



LEGEND

- SA = STOP AHEAD
- NLT = NO LEFT TURN
- DNE = DO NOT ENTER
- WW = WRONG WAY
- OWL = ONE WAY LEFT
- OWR = ONE WAY RIGHT
- S3W = STOP W/ 3-WAY PLAQUE
- S3WDR = STOP W/ 3-WAY PLAQUE/NORTH US 5 DETOUR RIGHT
- S3WDL = STOP W/ 3-WAY PLAQUE/NORTH US 5 DETOUR LEFT
- EDT = END DETOUR
- N5DL = NORTH US 5 DETOUR LEFT
- N5DR = NORTH US 5 DETOUR RIGHT
- N5D = NORTH US 5 DETOUR
- N5ED = NORTH US 5 END DETOUR
- S5DL = SOUTH US 5 DETOUR LEFT
- S5DR = SOUTH US 5 DETOUR RIGHT
- S5D = SOUTH US 5 DETOUR
- N5DL/S5D = NORTH US 5 DETOUR LEFT/SOUTH US 5 DETOUR
- 5DL = US 5 DETOUR LEFT
- 5D = US 5 DETOUR
- DA5N = DETOUR AHEAD NORTH US 5
- DA5S = DETOUR AHEAD SOUTH US 5

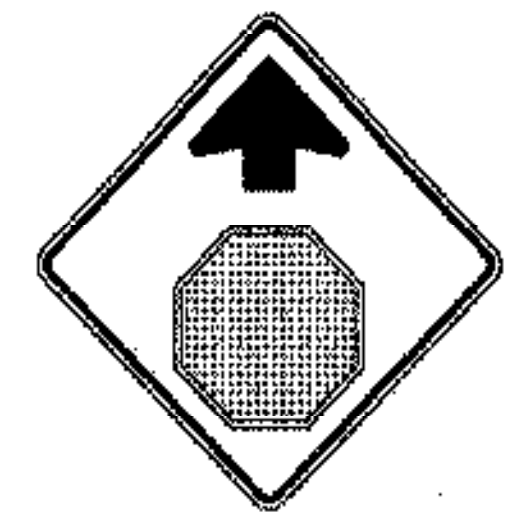

STOP AHEAD (SA)

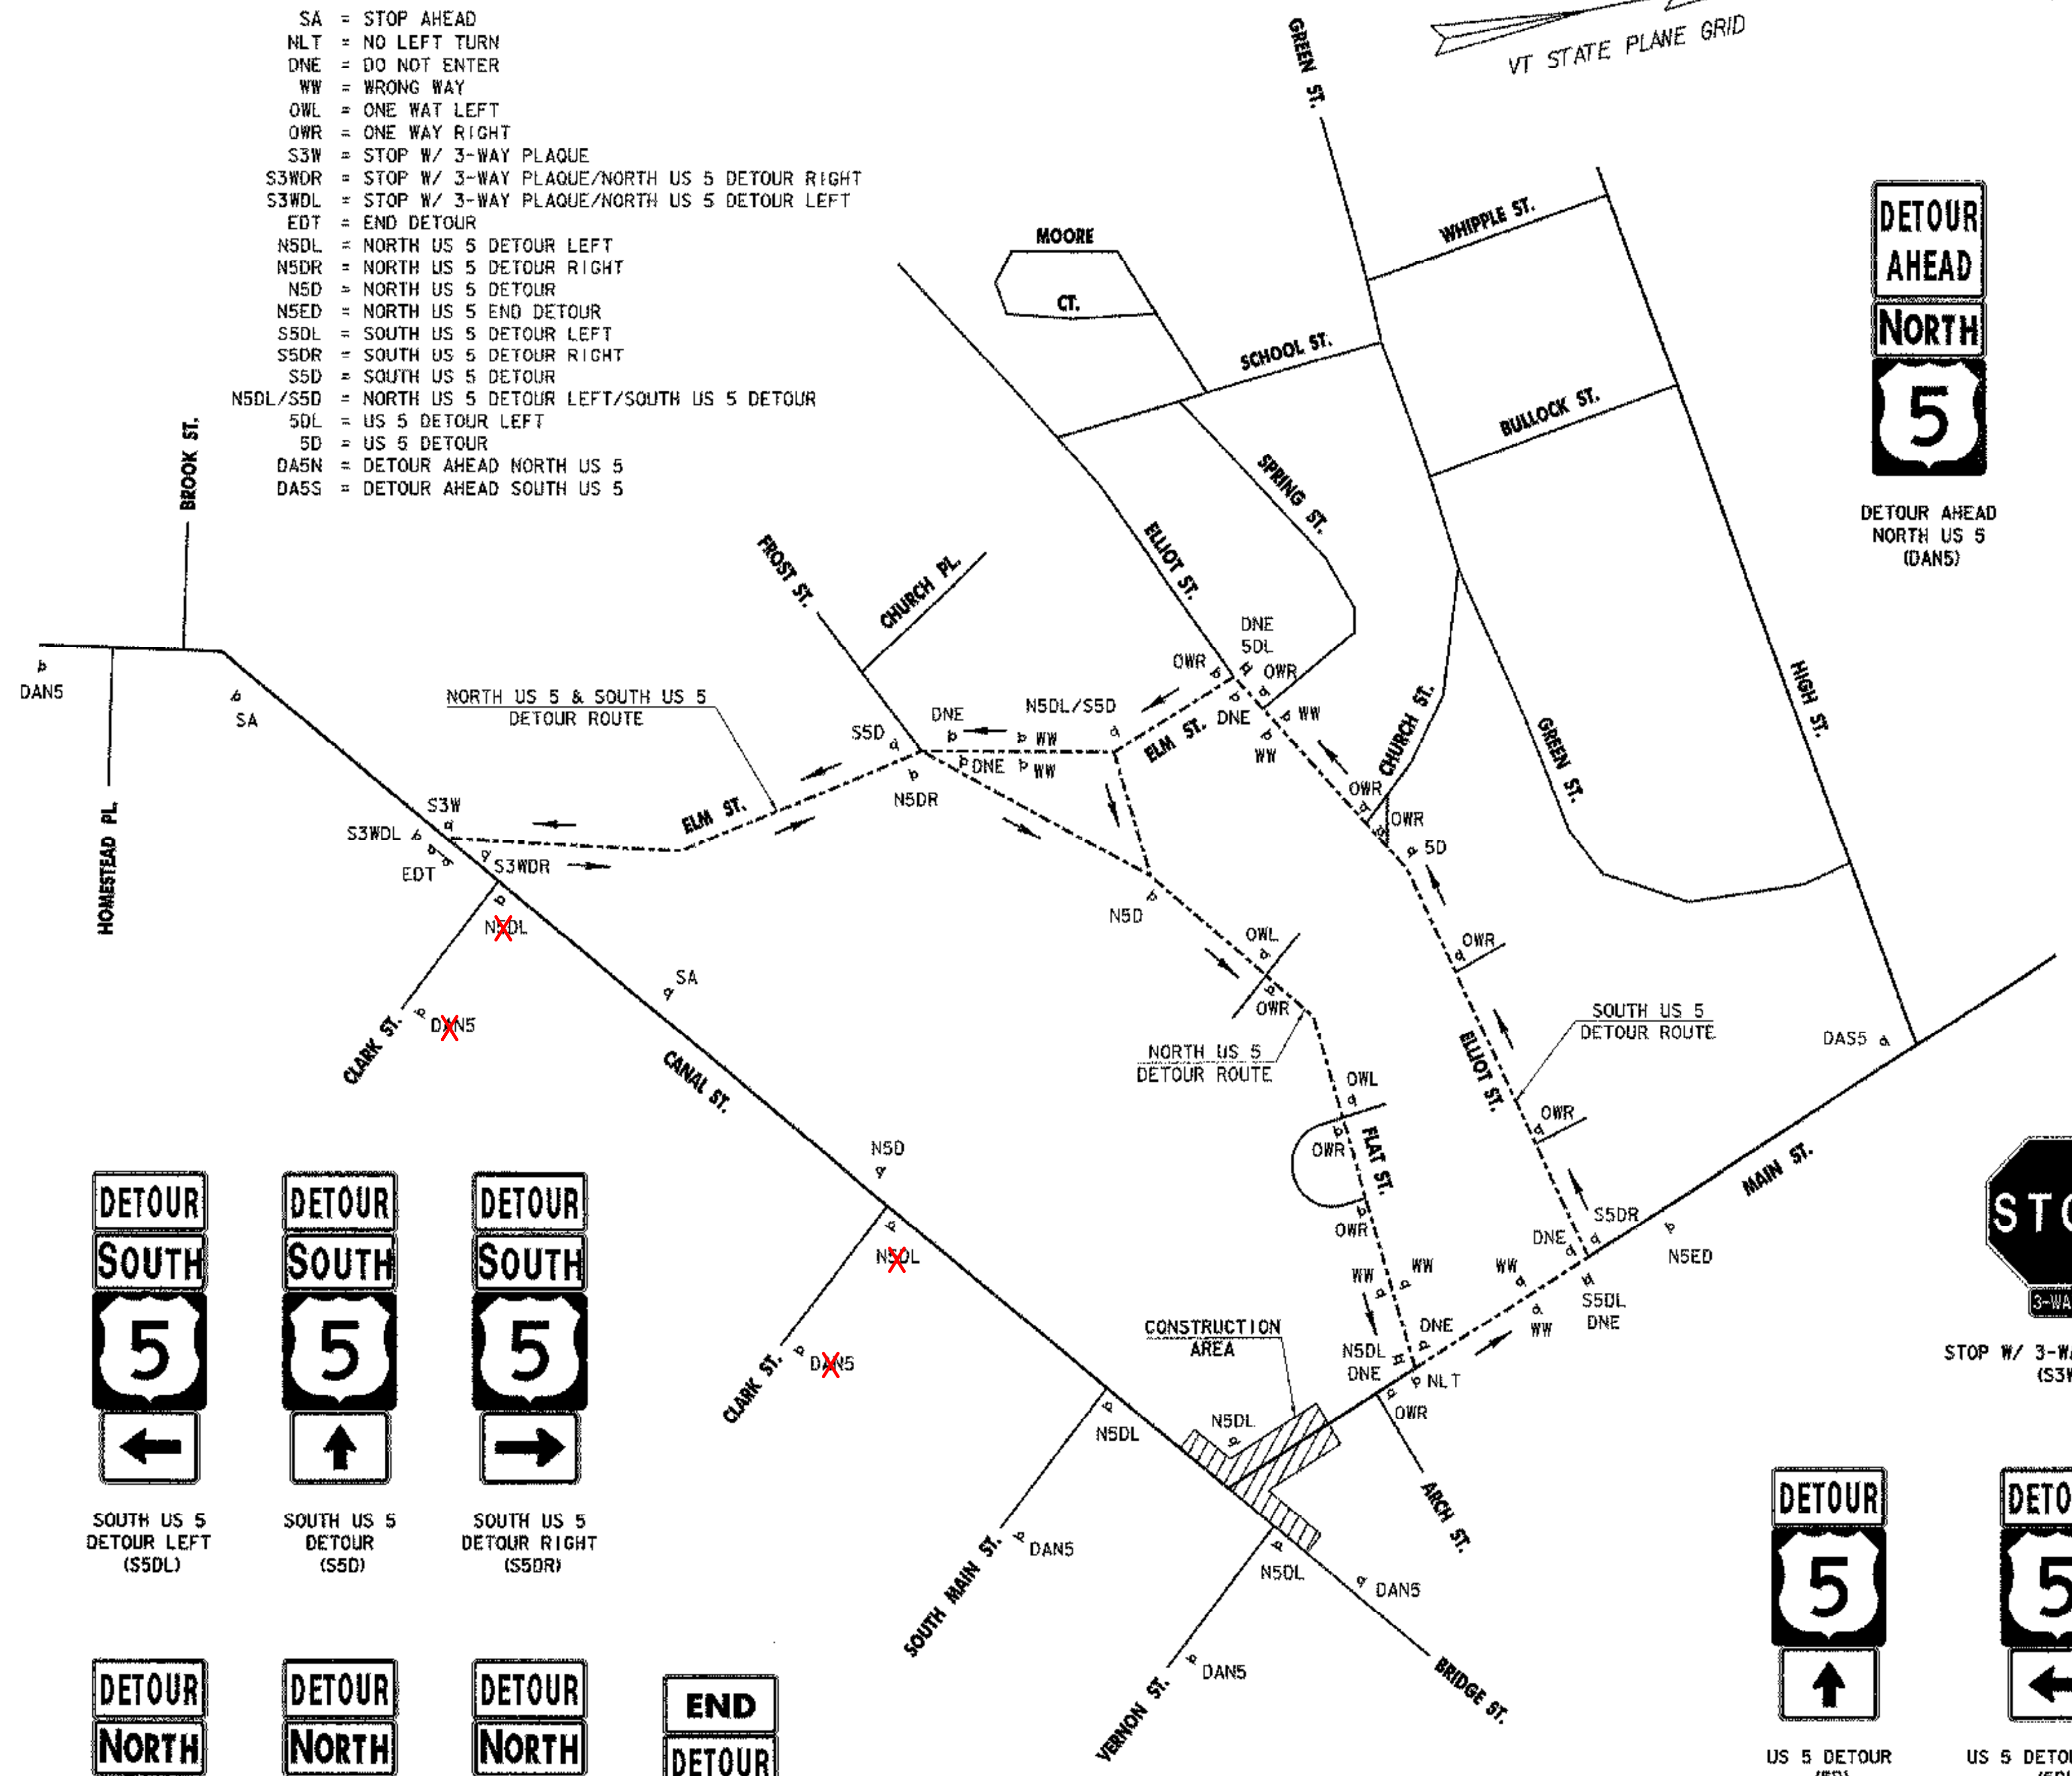

NO LEFT TURN (NLT)



DO NOT ENTER (DNE)



WRONG WAY (WW)



ONE WAY LEFT (OWL)



ONE WAY RIGHT (OWR)



STOP W/ 3-WAY PLAQUE NORTH US 5 DETOUR RIGHT (S3WDR)



STOP W/ 3-WAY PLAQUE NORTH US 5 DETOUR LEFT (S3WDL)



SOUTH US 5 DETOUR LEFT (S5DL)



SOUTH US 5 DETOUR (S5D)



SOUTH US 5 DETOUR RIGHT (S5DR)



NORTH US 5 DETOUR LEFT (N5DL)



NORTH US 5 DETOUR (N5D)



NORTH US 5 DETOUR RIGHT (N5DR)



NORTH US 5 END DETOUR (N5ED)



DETOUR AHEAD NORTH US 5 (DA5N)



DETOUR AHEAD SOUTH US 5 (DA5S)



STOP W/ 3-WAY PLAQUE (S3W)



US 5 DETOUR (5D)



US 5 DETOUR LEFT (5DL)

DETOUR SIGNING

| | | | |
|------------------|-----------------------------|-------------|-----------------|
| PROJECT NAME: | BRATTLEBORO | | |
| PROJECT NUMBER: | BHF 2000 (17) | | |
| FILE NAME: | 94\078\Structures\sj078ds.1 | PLOT DATE: | 24-MAY-2004 |
| PROJECT MANAGER: | R. R. WHITCOMB | DRAWN BY: | G. ROY |
| DESIGNED BY: | G. ROY | CHECKED BY: | T. SUMNER |
| | | | SHEET 168 OF 71 |

| DATE | BY | REVISION |
|------------|------|--|
| 04/22/2003 | VAOT | MODIFIED SIGNS FOR DETOUR DUE TO BRIDGE CLOSURE. |