
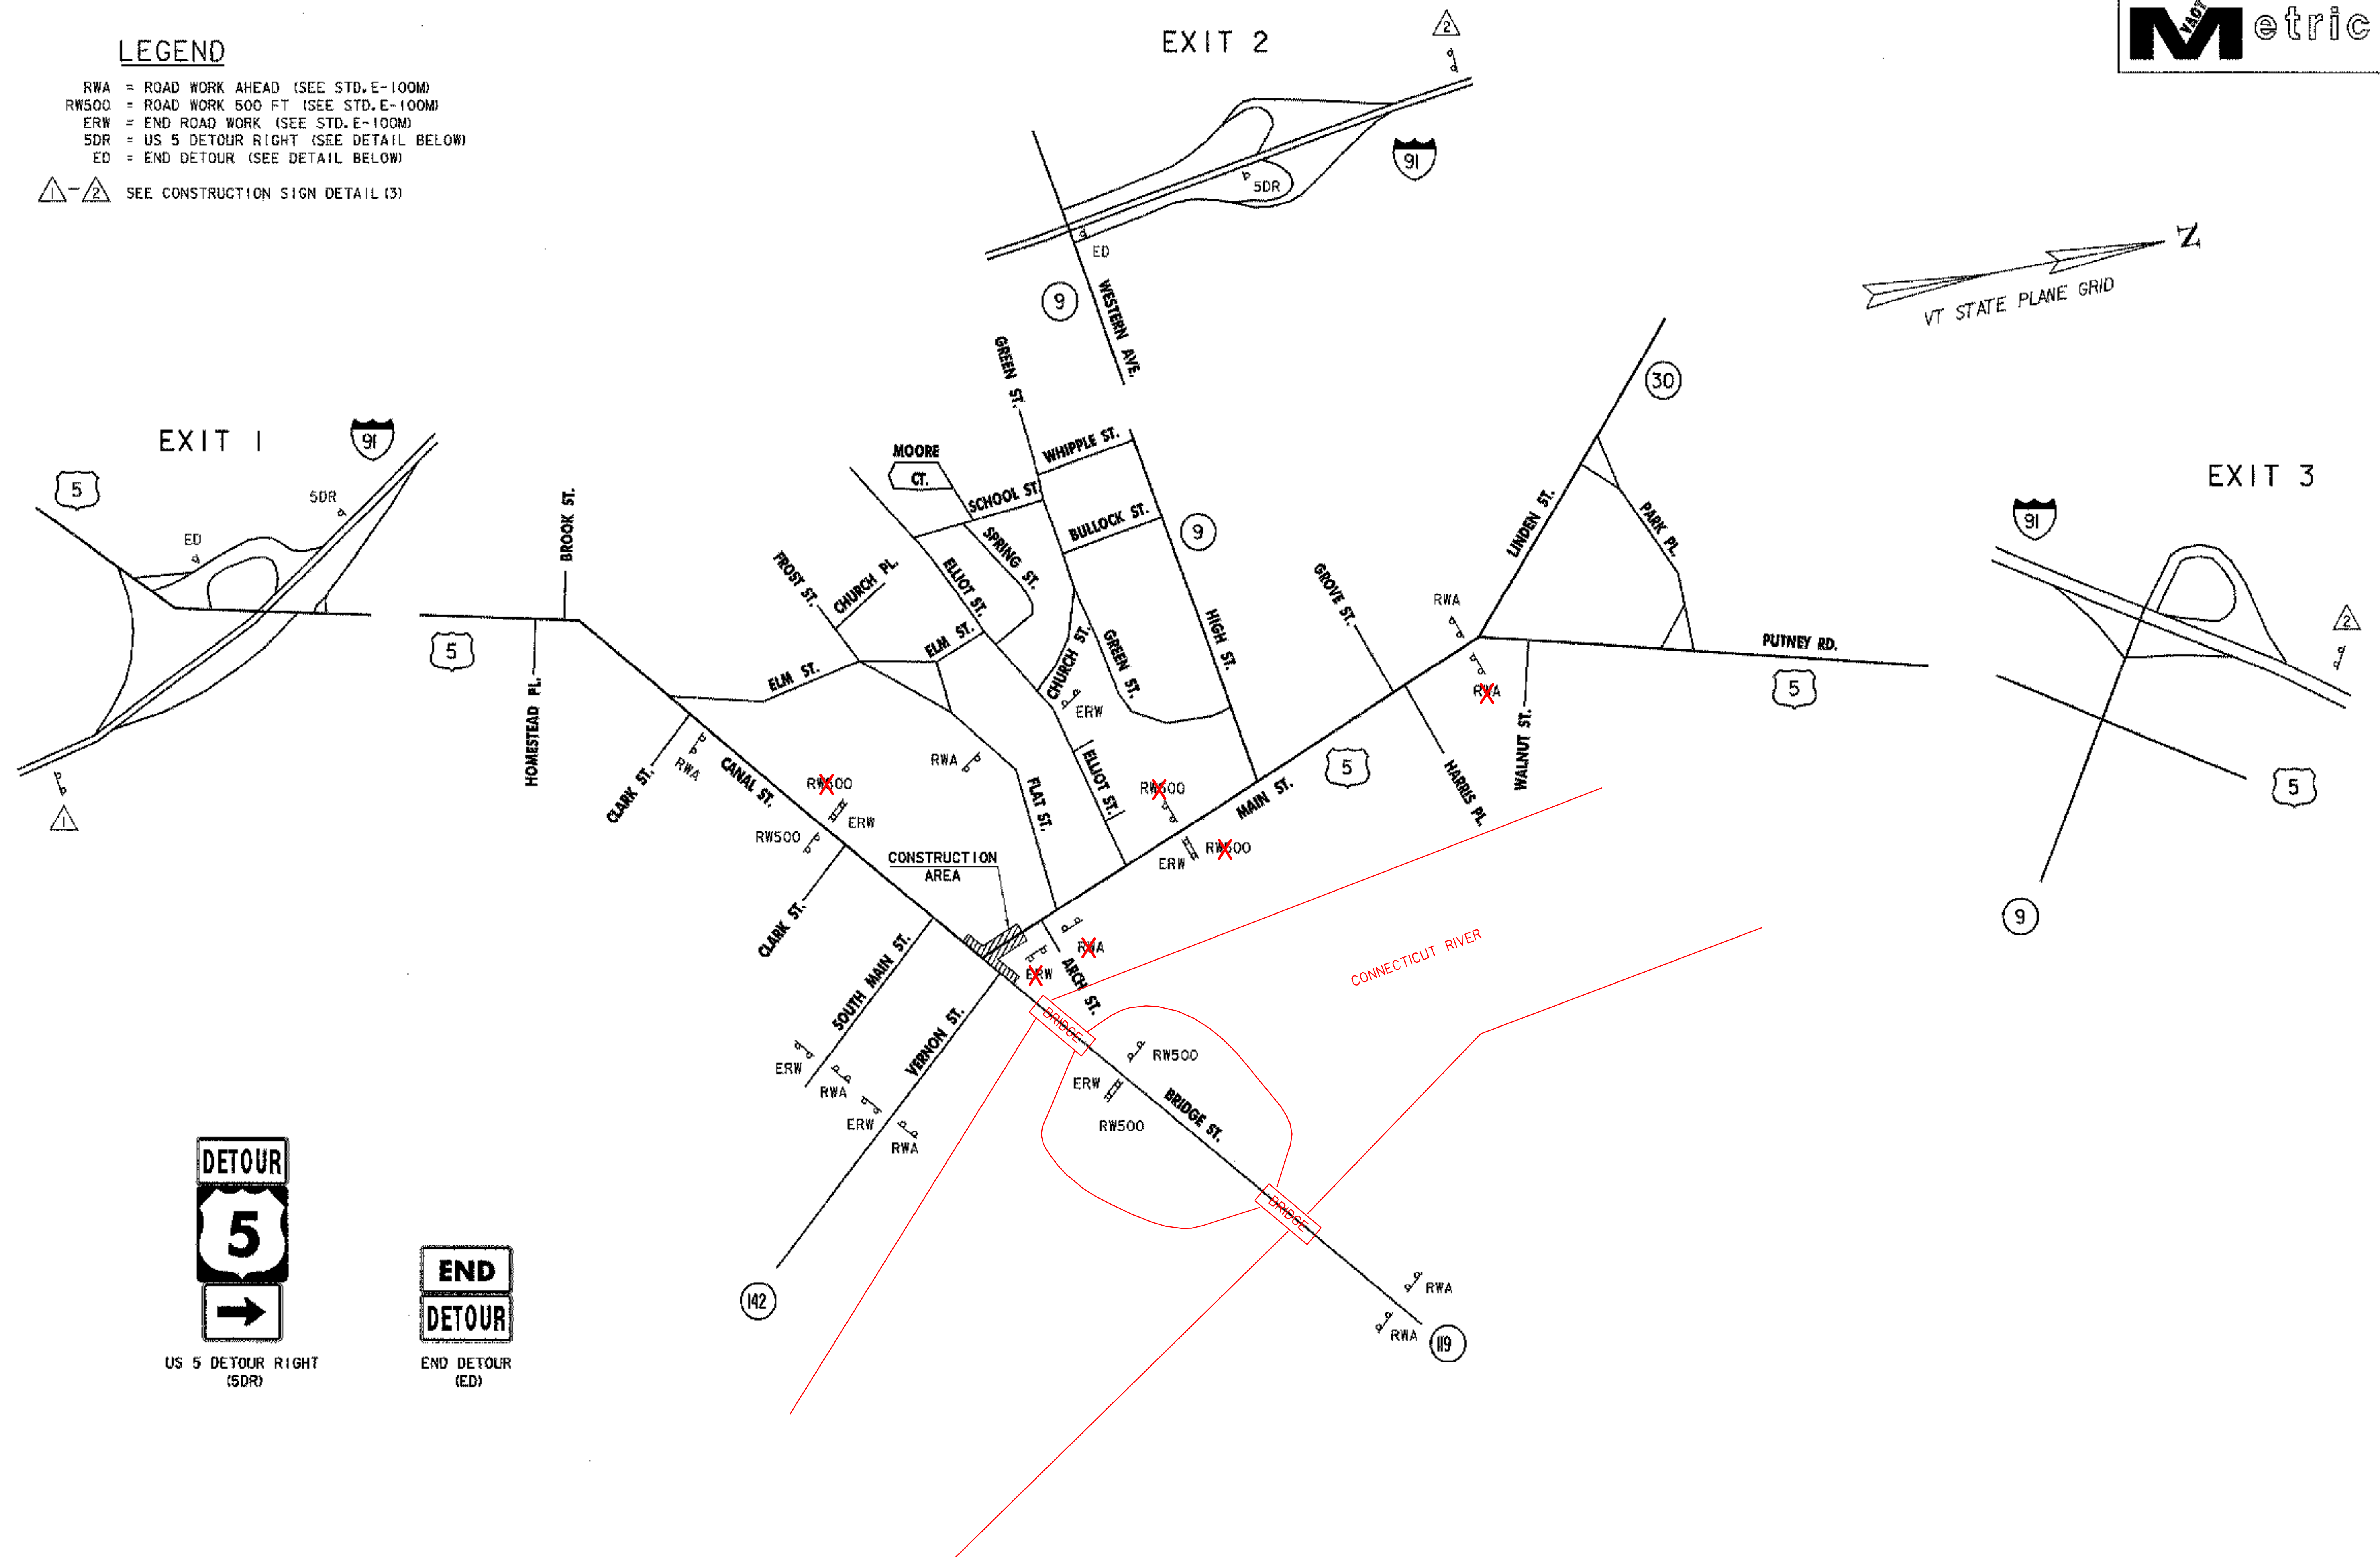


**LEGEND**

- RWA = ROAD WORK AHEAD (SEE STD. E-100M)
  - RW500 = ROAD WORK 500 FT (SEE STD. E-100M)
  - ERW = END ROAD WORK (SEE STD. E-100M)
  - SDR = US 5 DETOUR RIGHT (SEE DETAIL BELOW)
  - ED = END DETOUR (SEE DETAIL BELOW)
- ▲-▲ SEE CONSTRUCTION SIGN DETAIL (3)

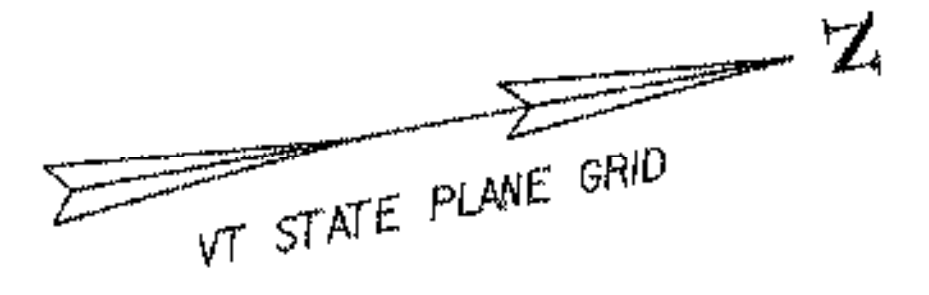

**CONSTRUCTION APPROACH SIGNING**

PROJECT NAME:	BRATTLEBORO	FILE NAME:	94\078\Structures\078cas.d	PLOT DATE:	24-MAY-2004
PROJECT NUMBER:	BHF 2000 (17)	PROJECT MANAGER:	R. R. WHITCOMB	DRAWN BY:	G. ROY
		DESIGNED BY:	G. ROY	CHECKED BY:	T. SUMNER
				SHEET	16A OF 71

DATE	BY	REVISION
04/22/2003	VAOT	MODIFIED SIGNS FOR DETOUR DUE TO BRIDGE CLOSURE.