

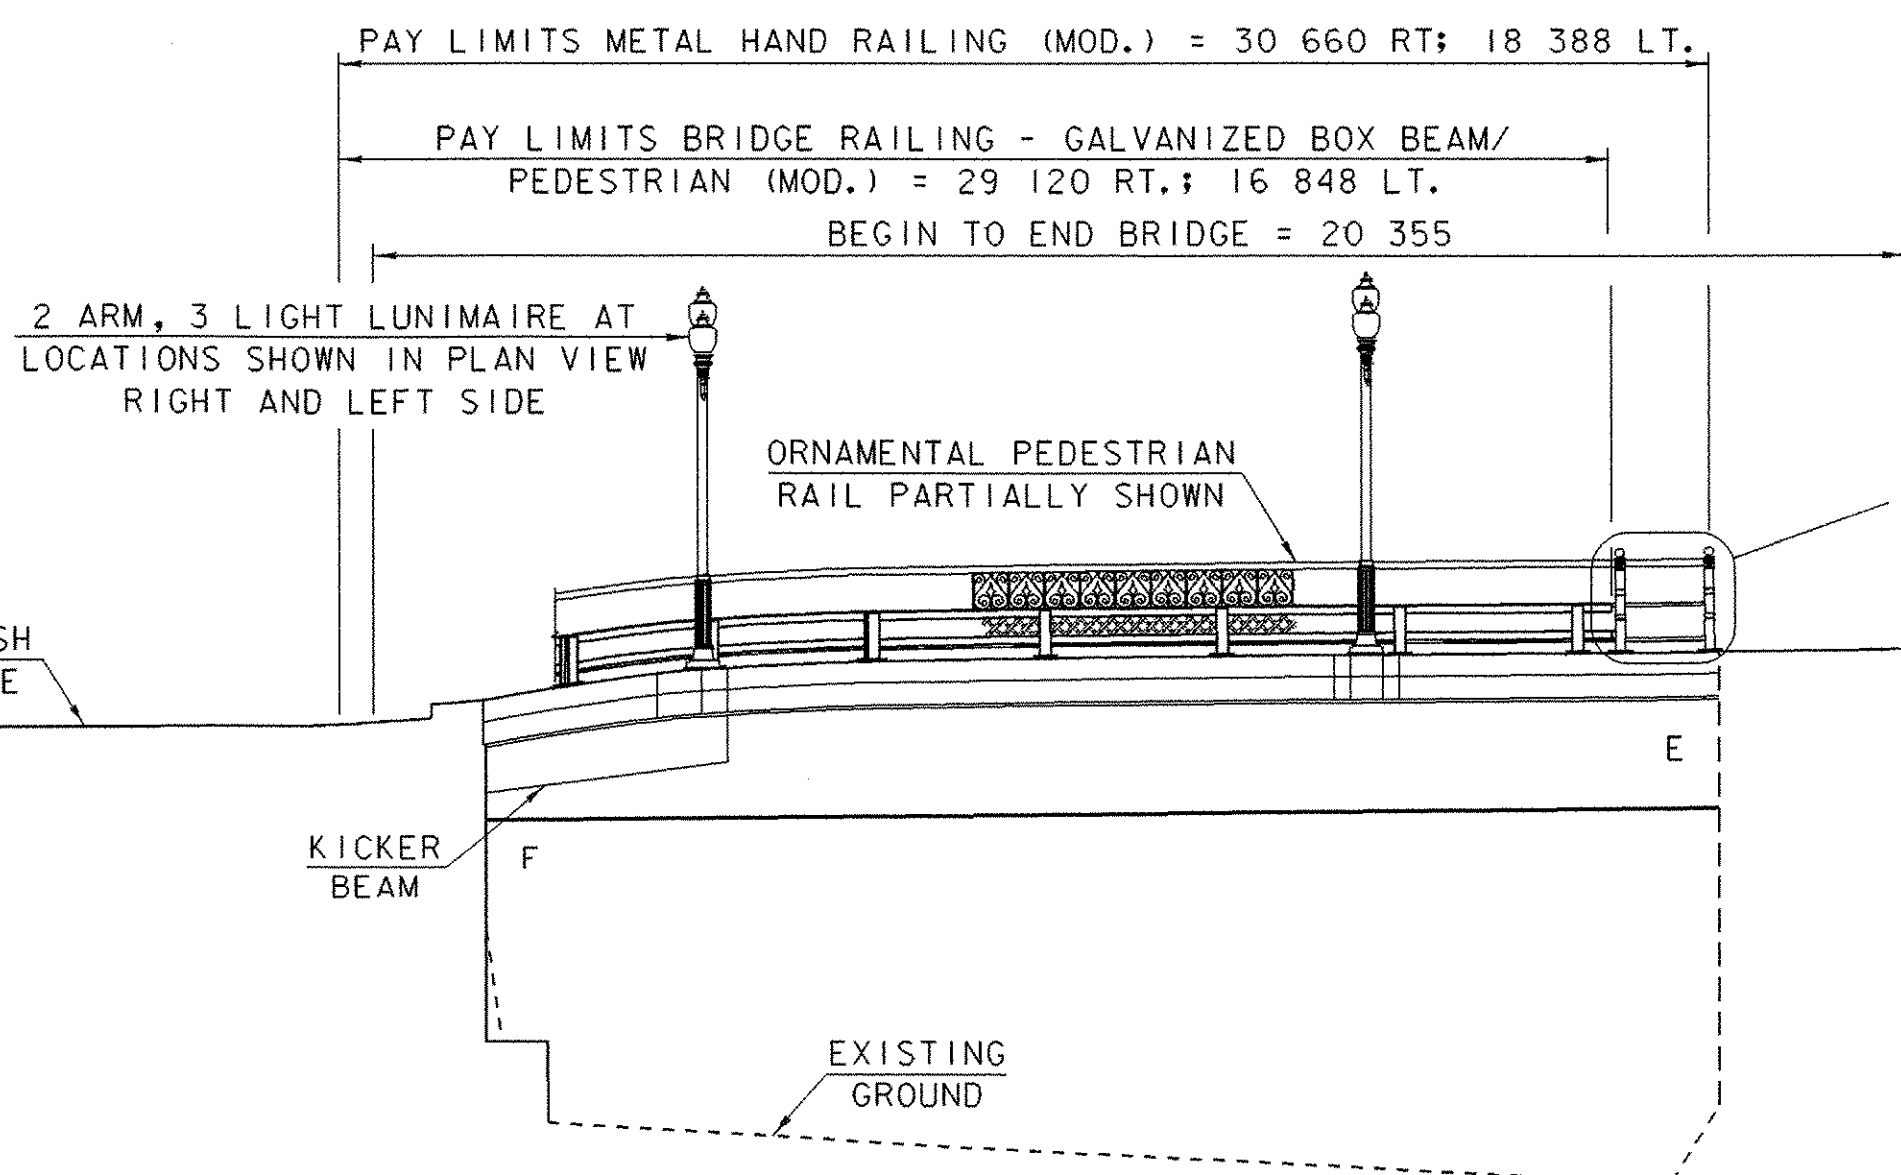
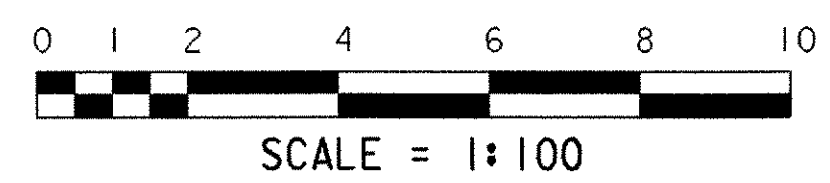
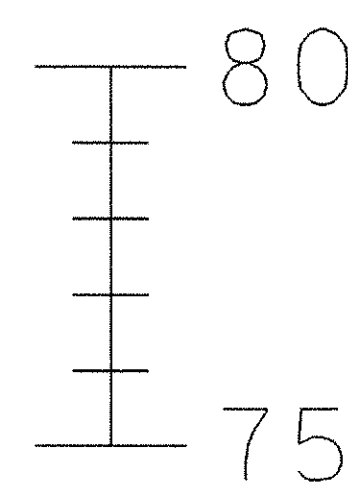


PLAN

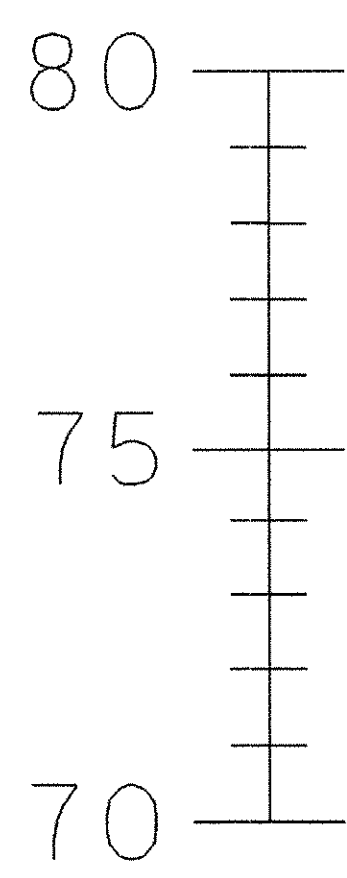

ELEVATION

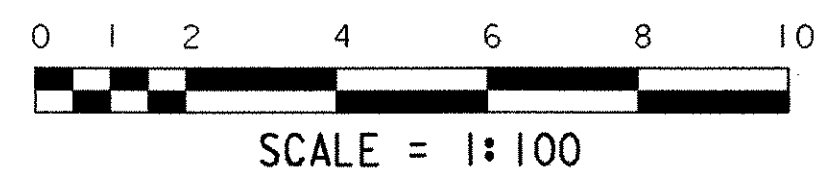

PLAN AND ELEVATION

PROJECT NAME: BRATTLEBORO	PROJECT NUMBER: BHF 2000 (17)
FILE NAME: 94J078\Structures\sj078pe.1	PLOT DATE: 06-FEB-2003
PROJECT MANAGER: R. R. WHITCOMB	DRAWN BY: G. ROY
DESIGNED BY: G. ROY	CHECKED BY: T. SUMNER
	SHEET 31 OF 71