

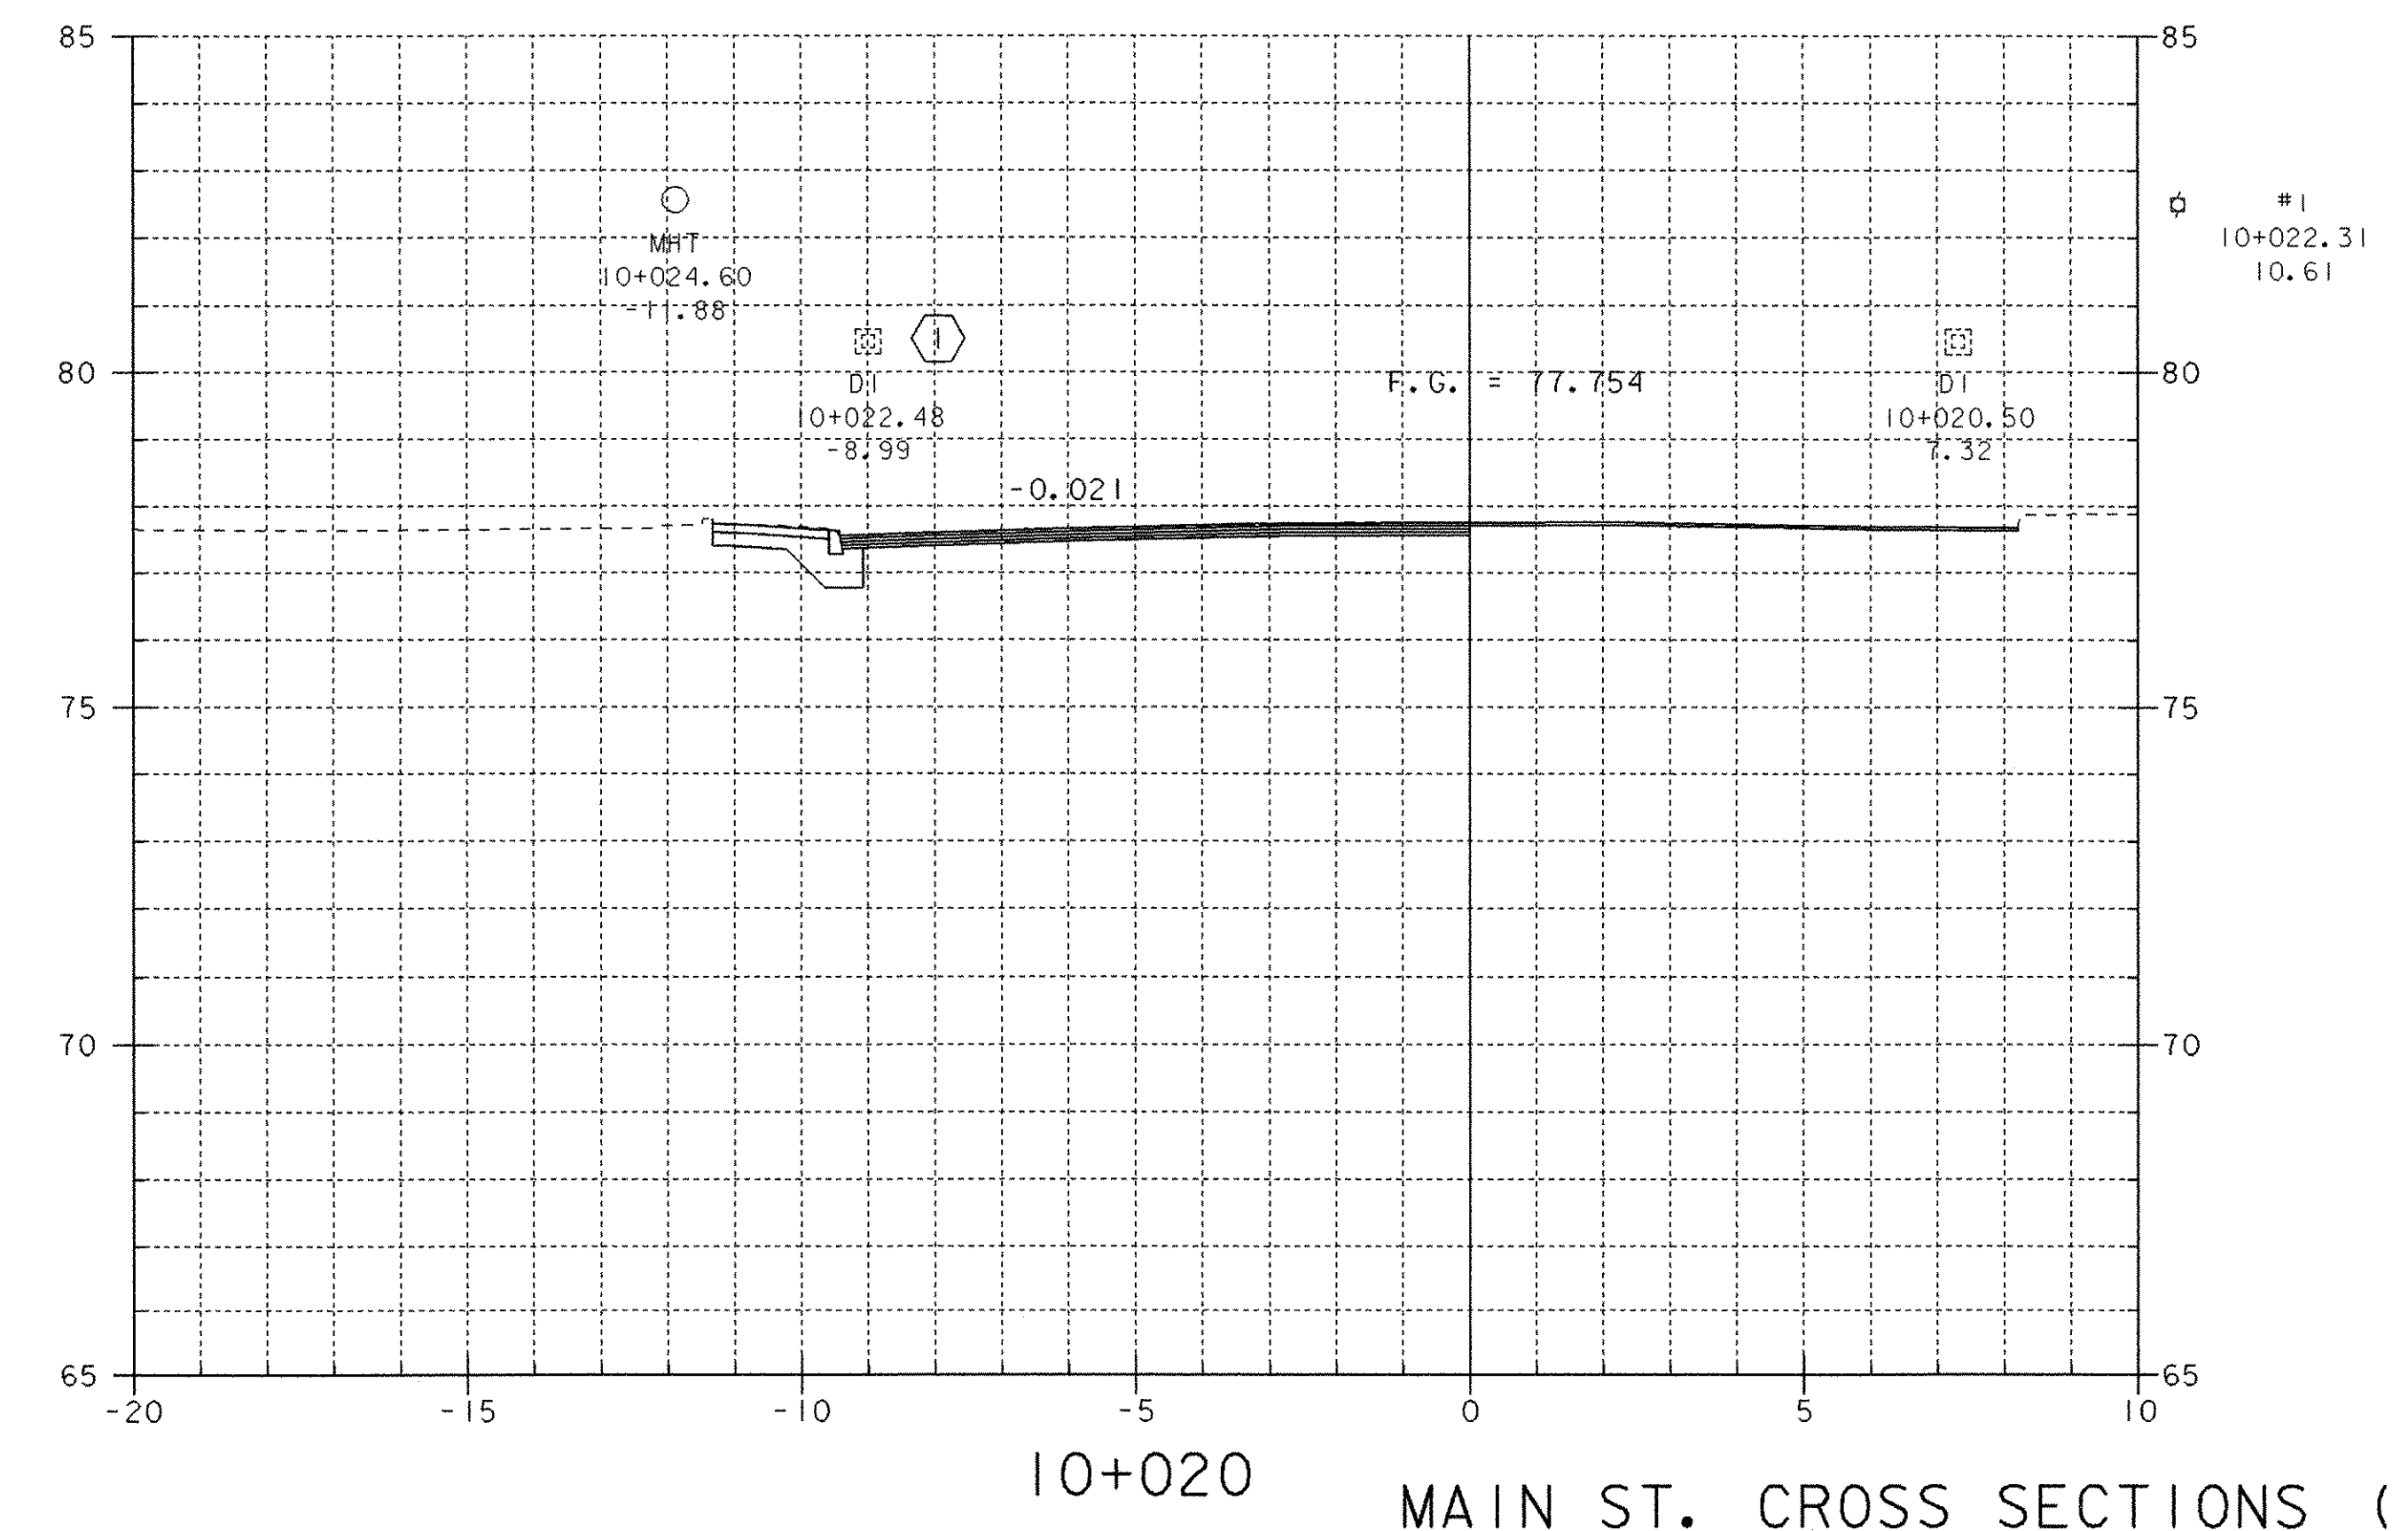
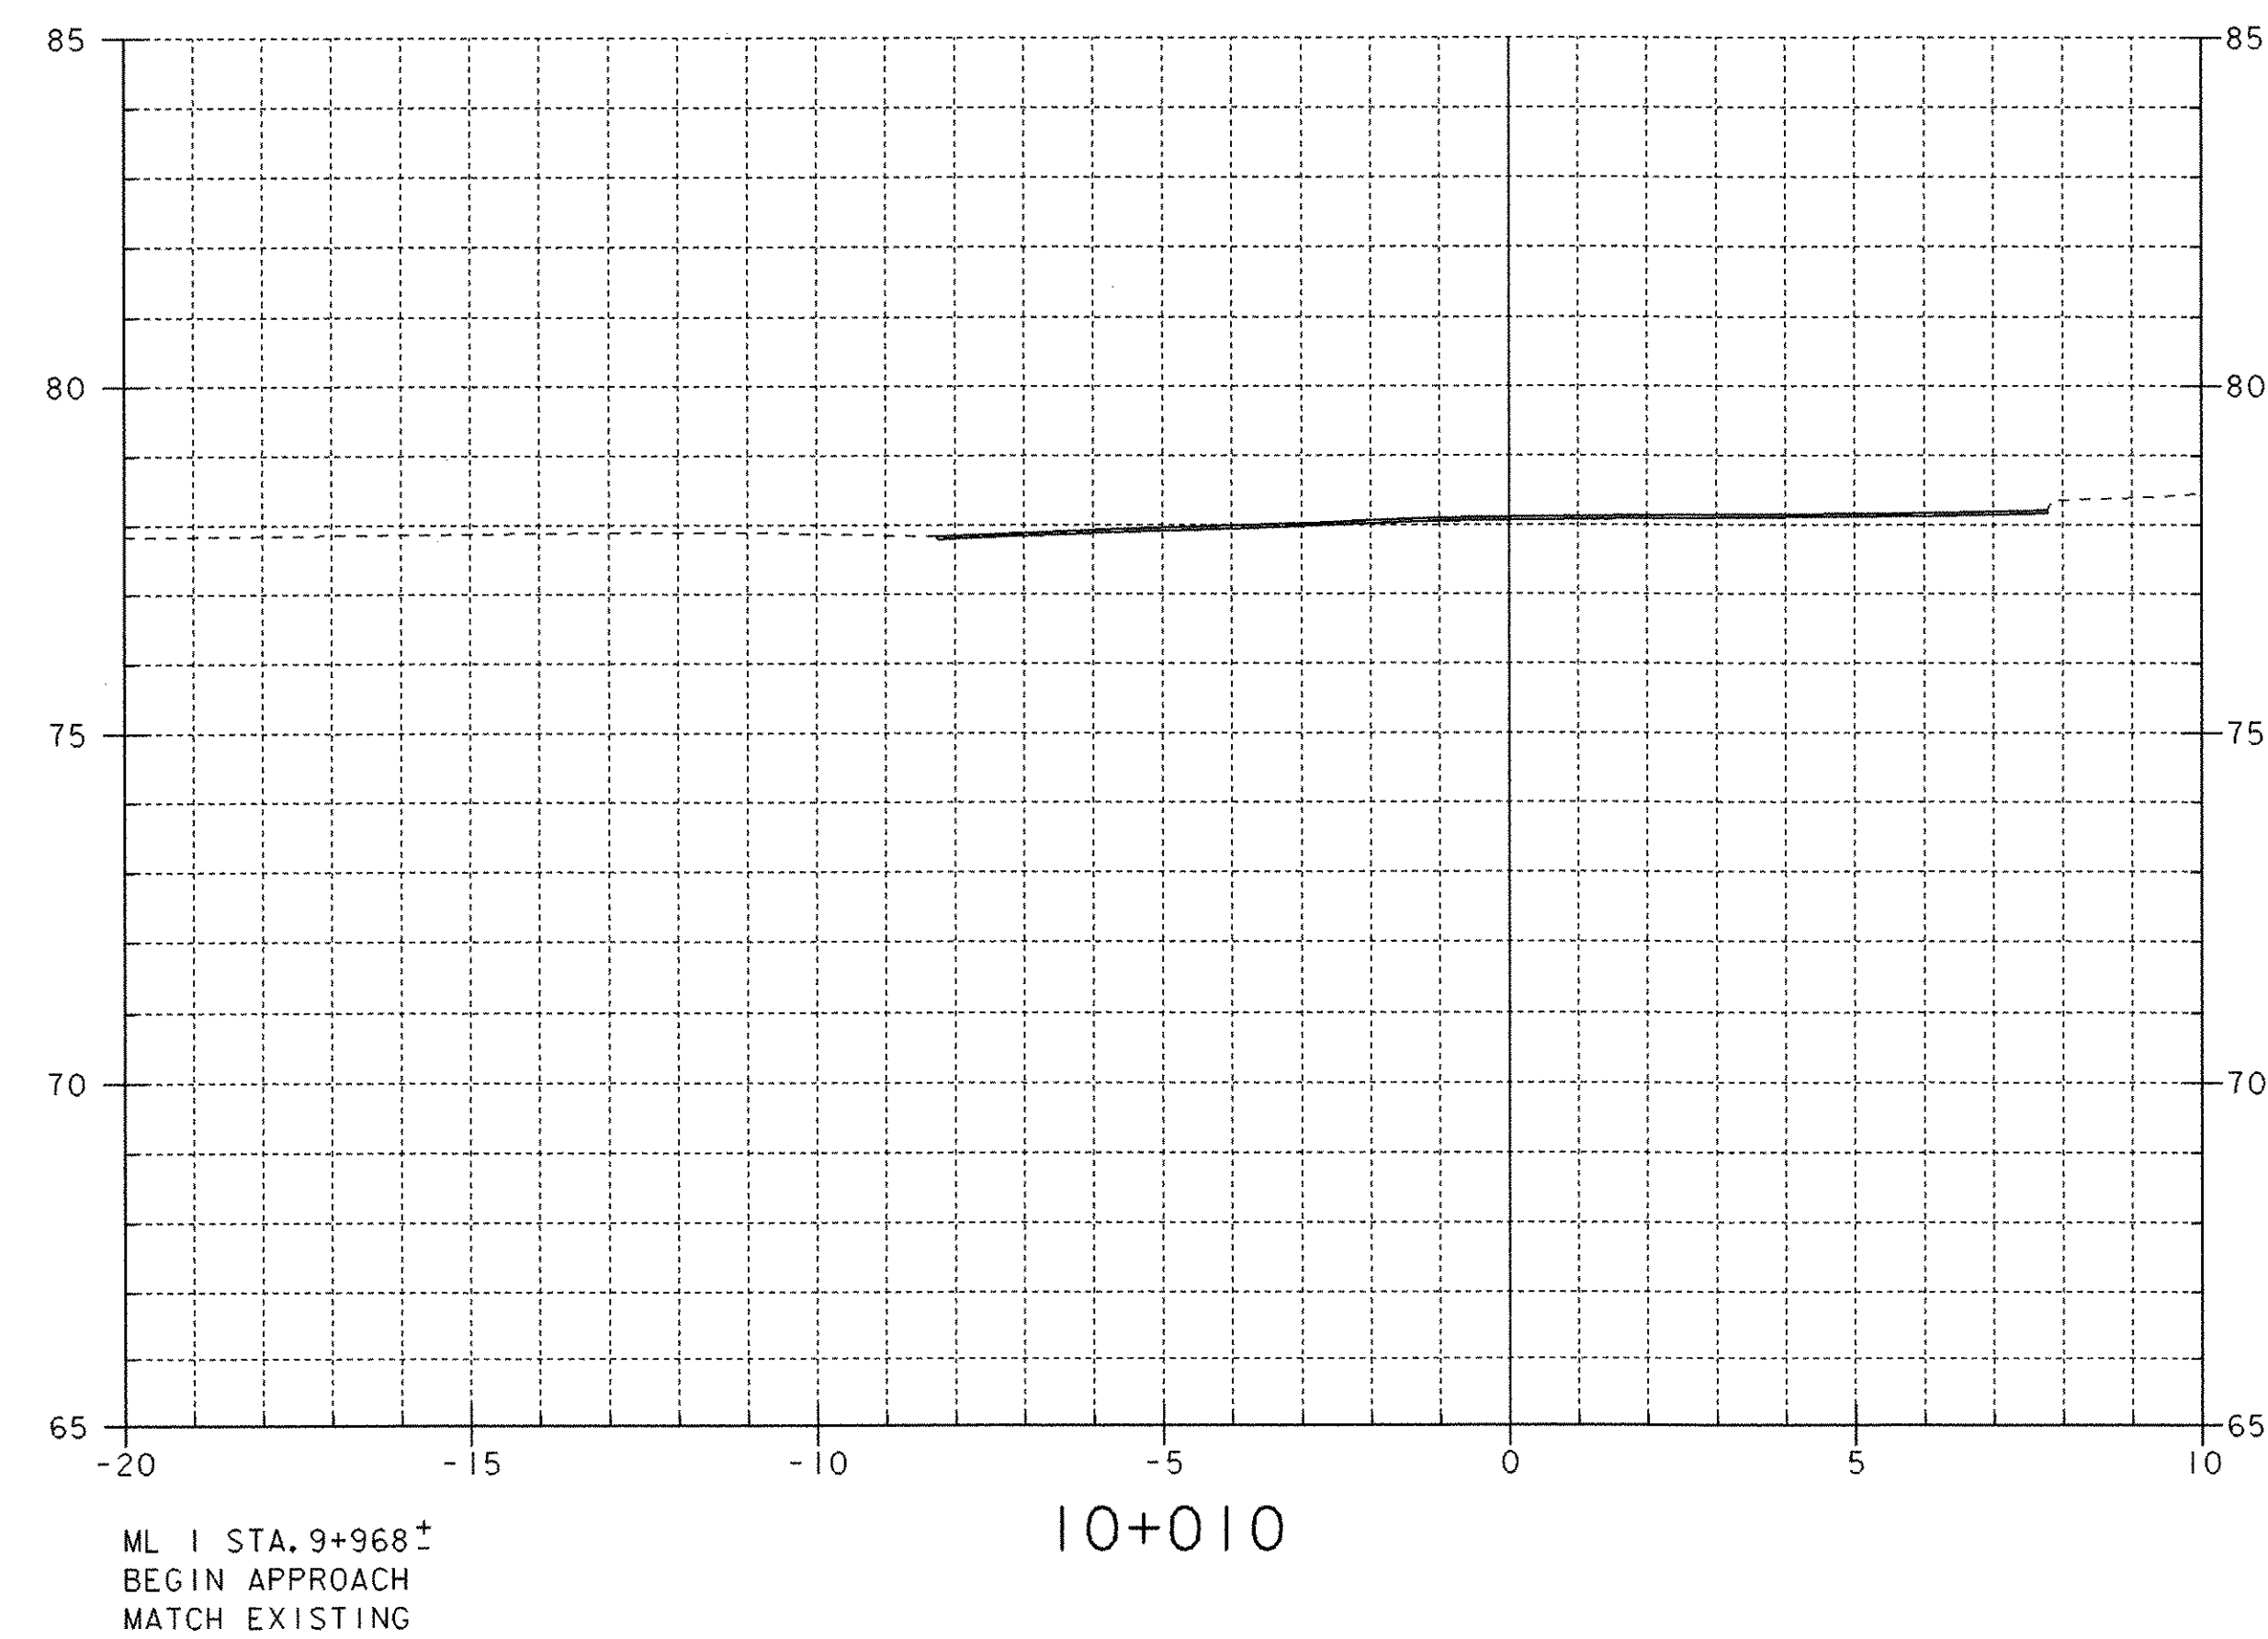


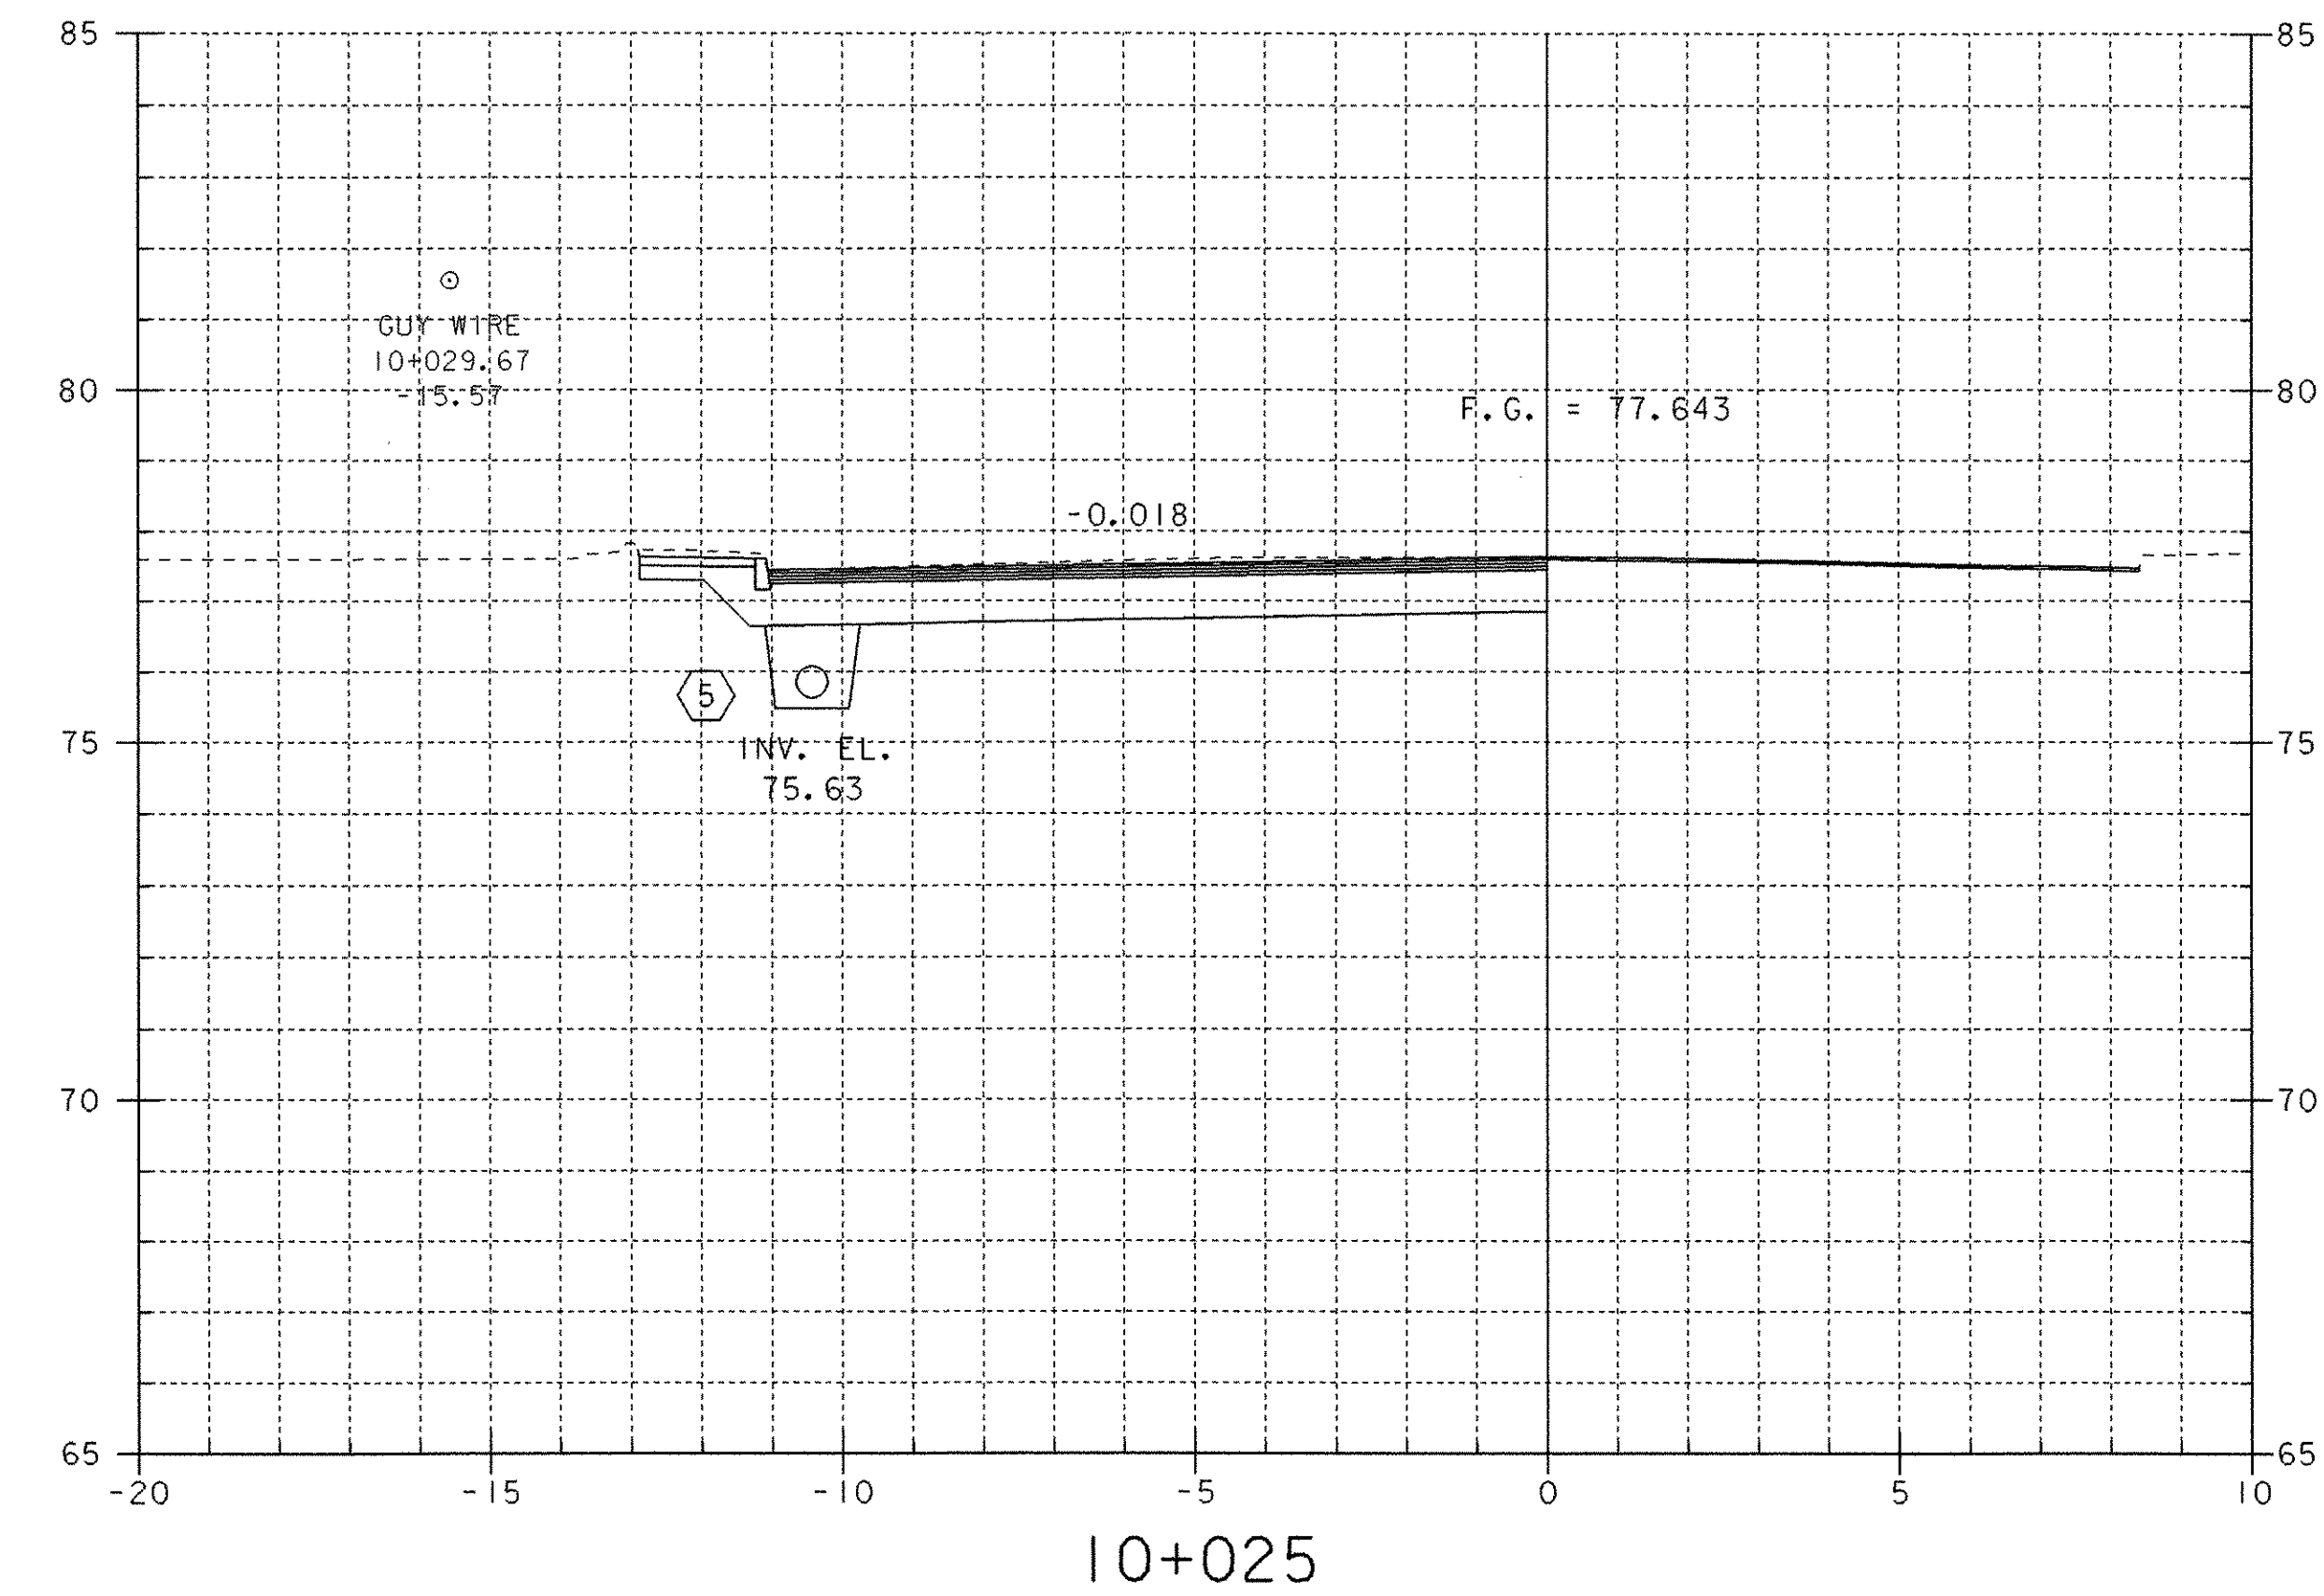

MAIN ST. CROSS SECTIONS (1)

PROJECT NAME: BRATTLEBORO
PROJECT NUMBER: BHF 2000 (17)

FILE NAME: 94J078\Structures\sj078m01.i PLOT DATE: 06-FEB-2003
PROJECT MANAGER: R.R. WHITCOMB DRAWN BY: G. ROY
DESIGNED BY: G. ROY CHECKED BY: T. SUMNER
SHEET 61 OF 71

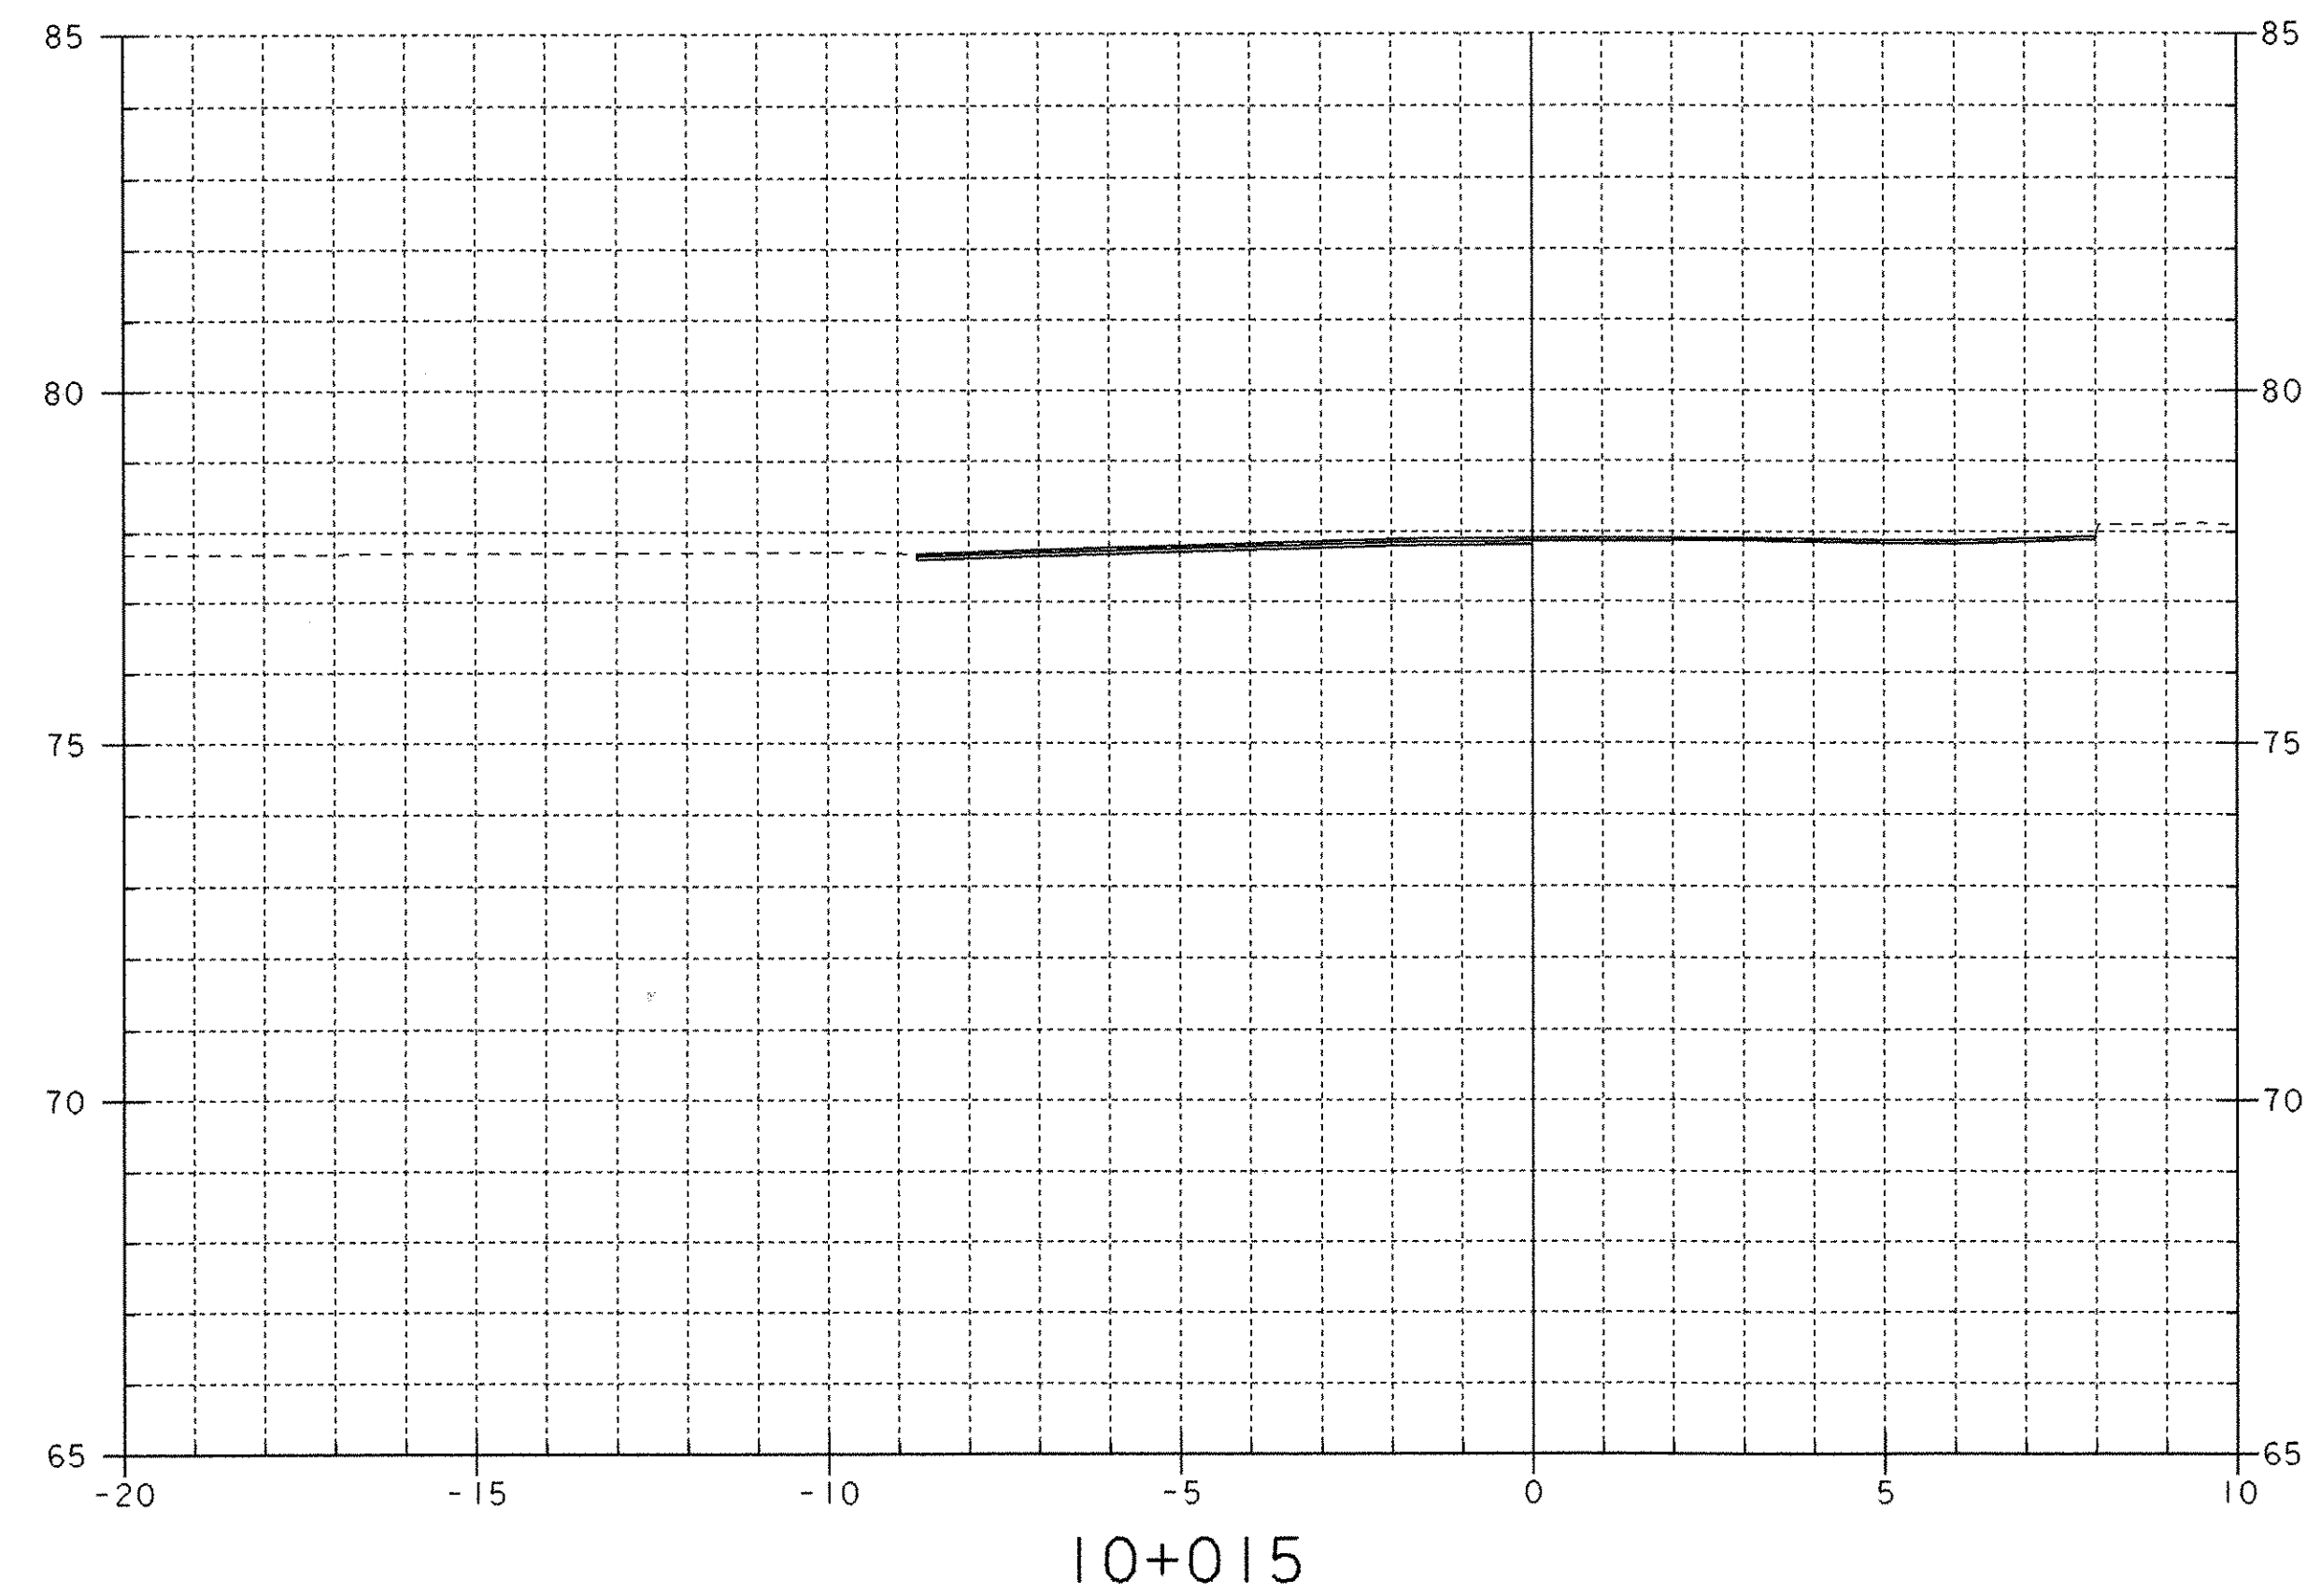