


ML 1 STA. 10+047.338
END APPROACH
BEGIN PROJECT/BRIDGE

MAIN ST. CROSS SECTIONS (3)

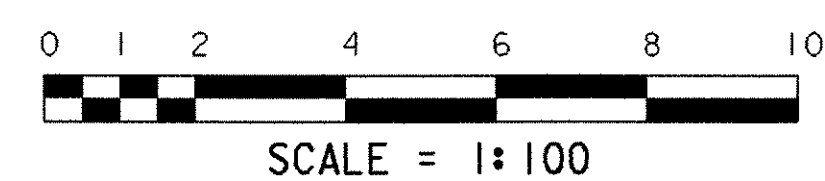

PROJECT NAME:	BRATTLEBORO
PROJECT NUMBER:	BHF 2000 (17)
FILE NAME:	94j078\Structures\sj078m03.1
PROJECT MANAGER:	R.R. WHITCOMB
DESIGNED BY:	G. ROY
PLOT DATE:	06-FEB-2003
DRAWN BY:	G. ROY
CHECKED BY:	T. SUMNER
SHEET	63 OF 71