

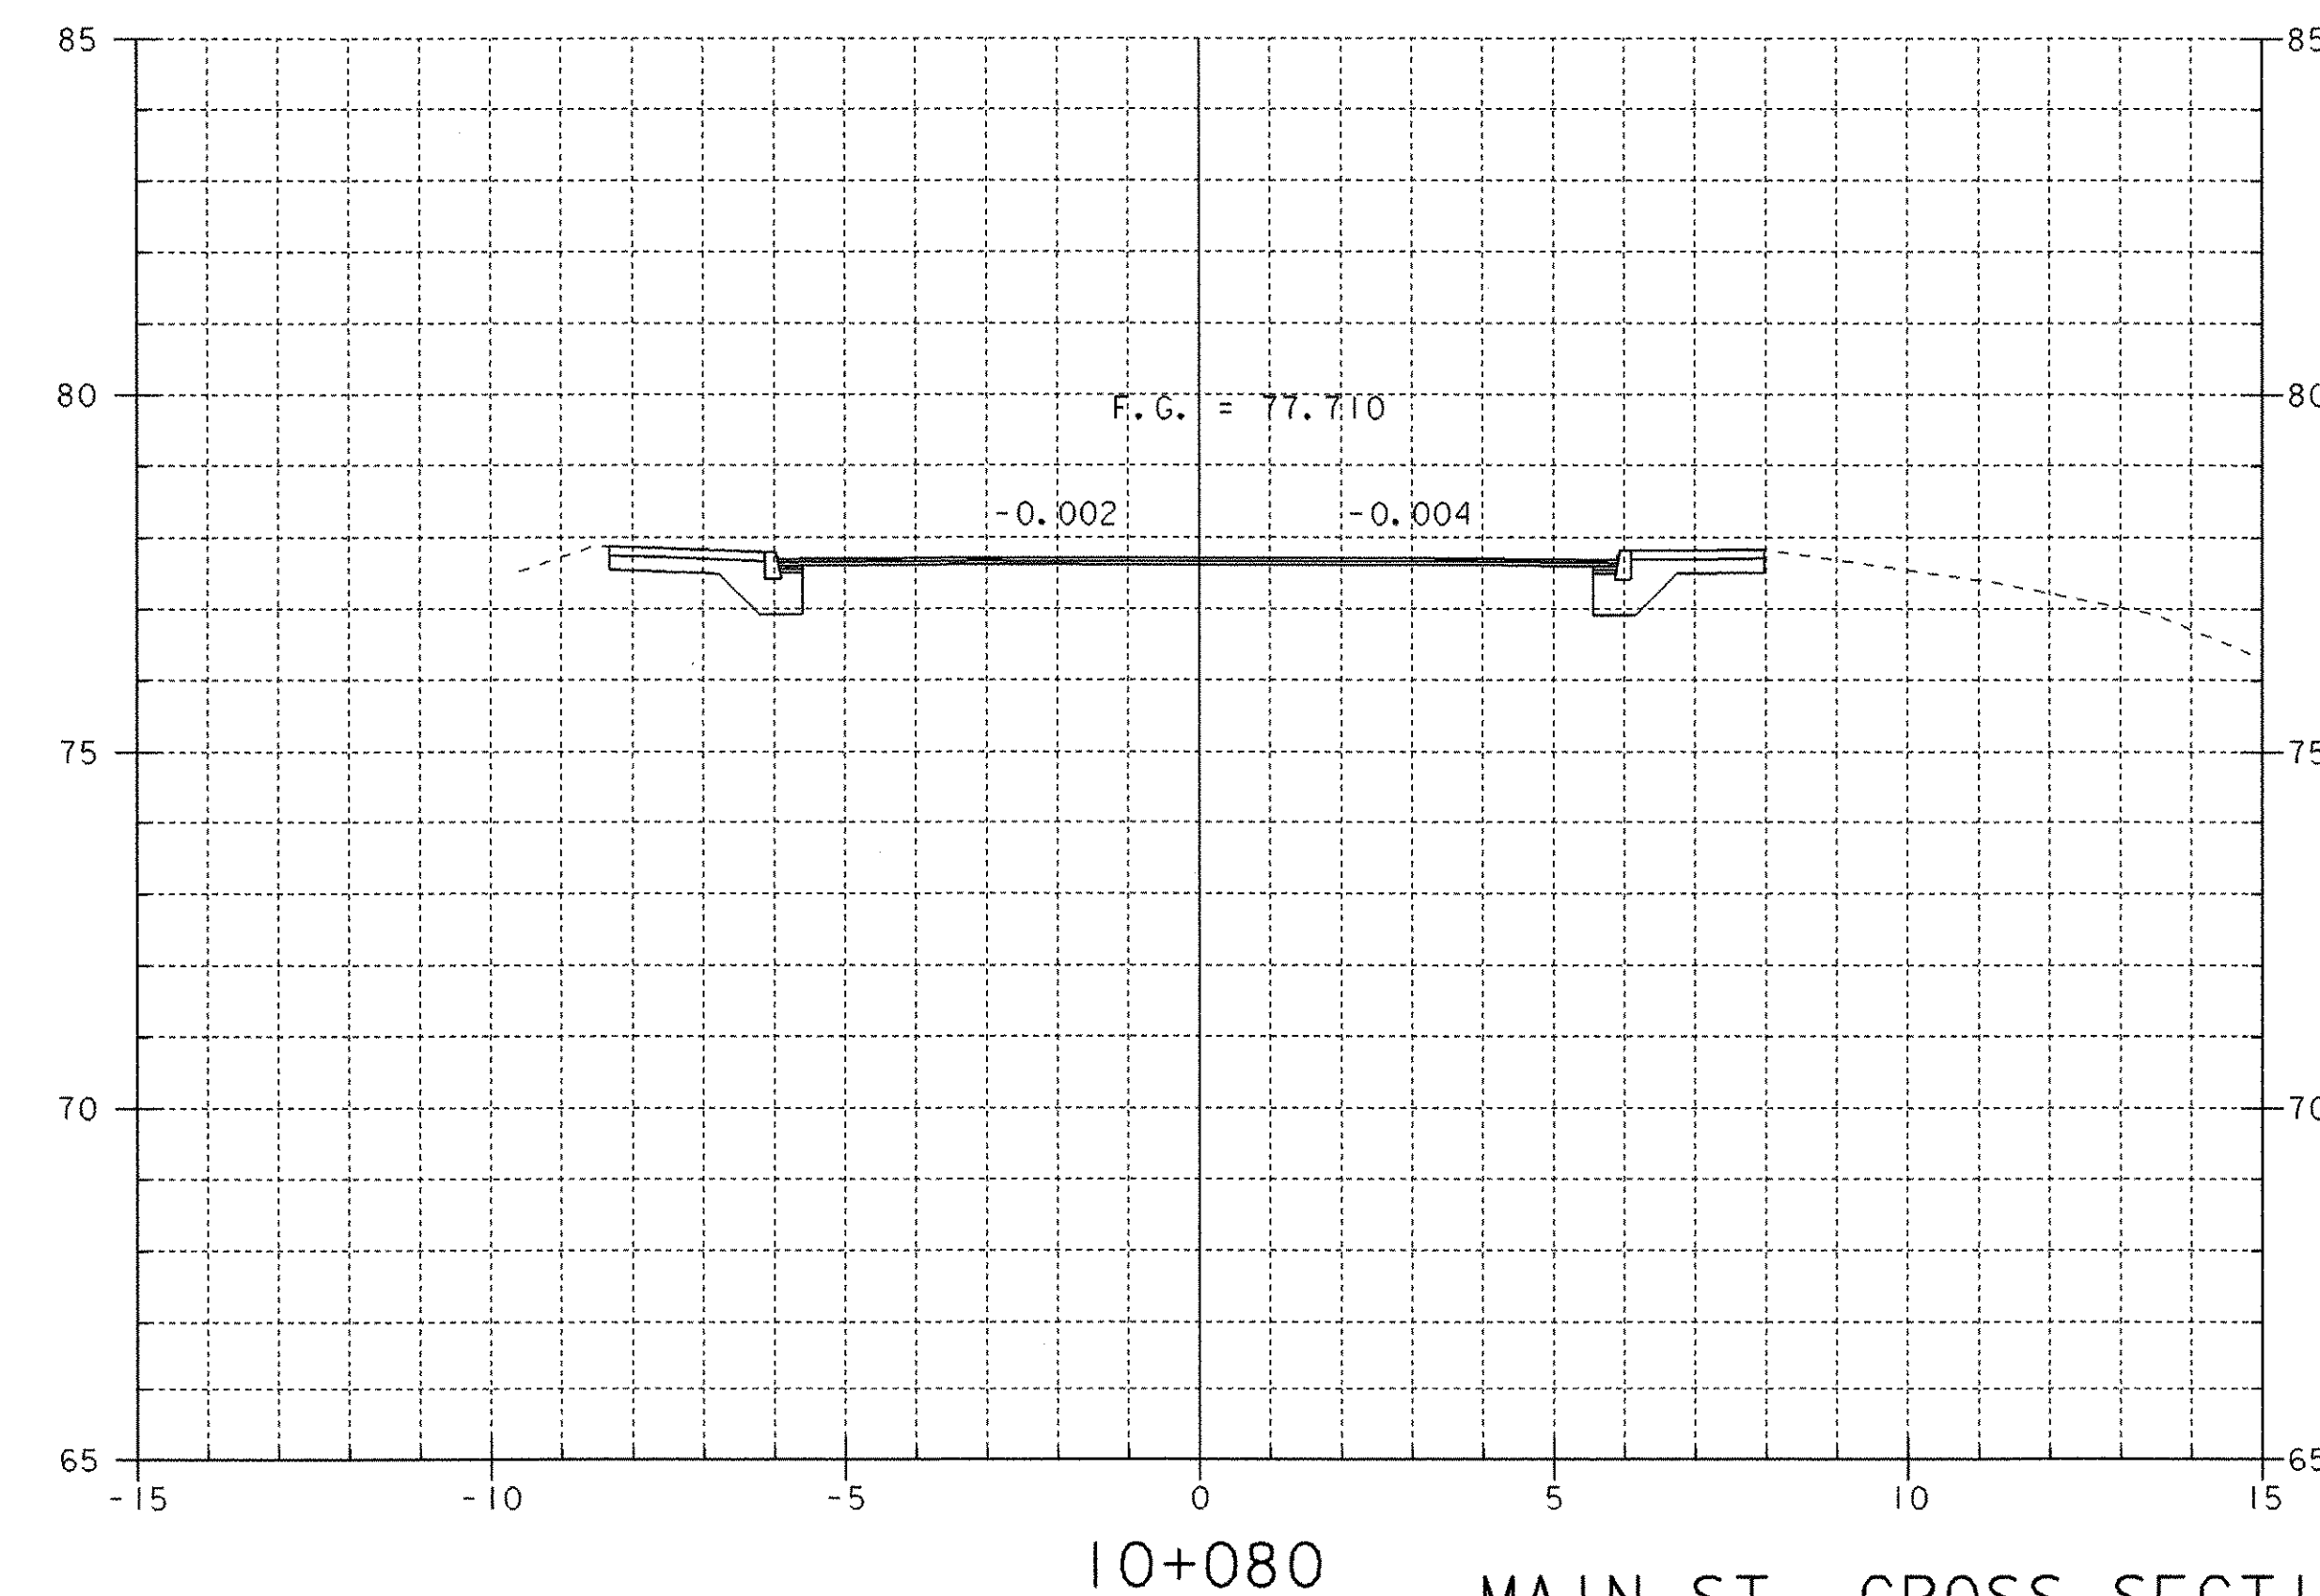
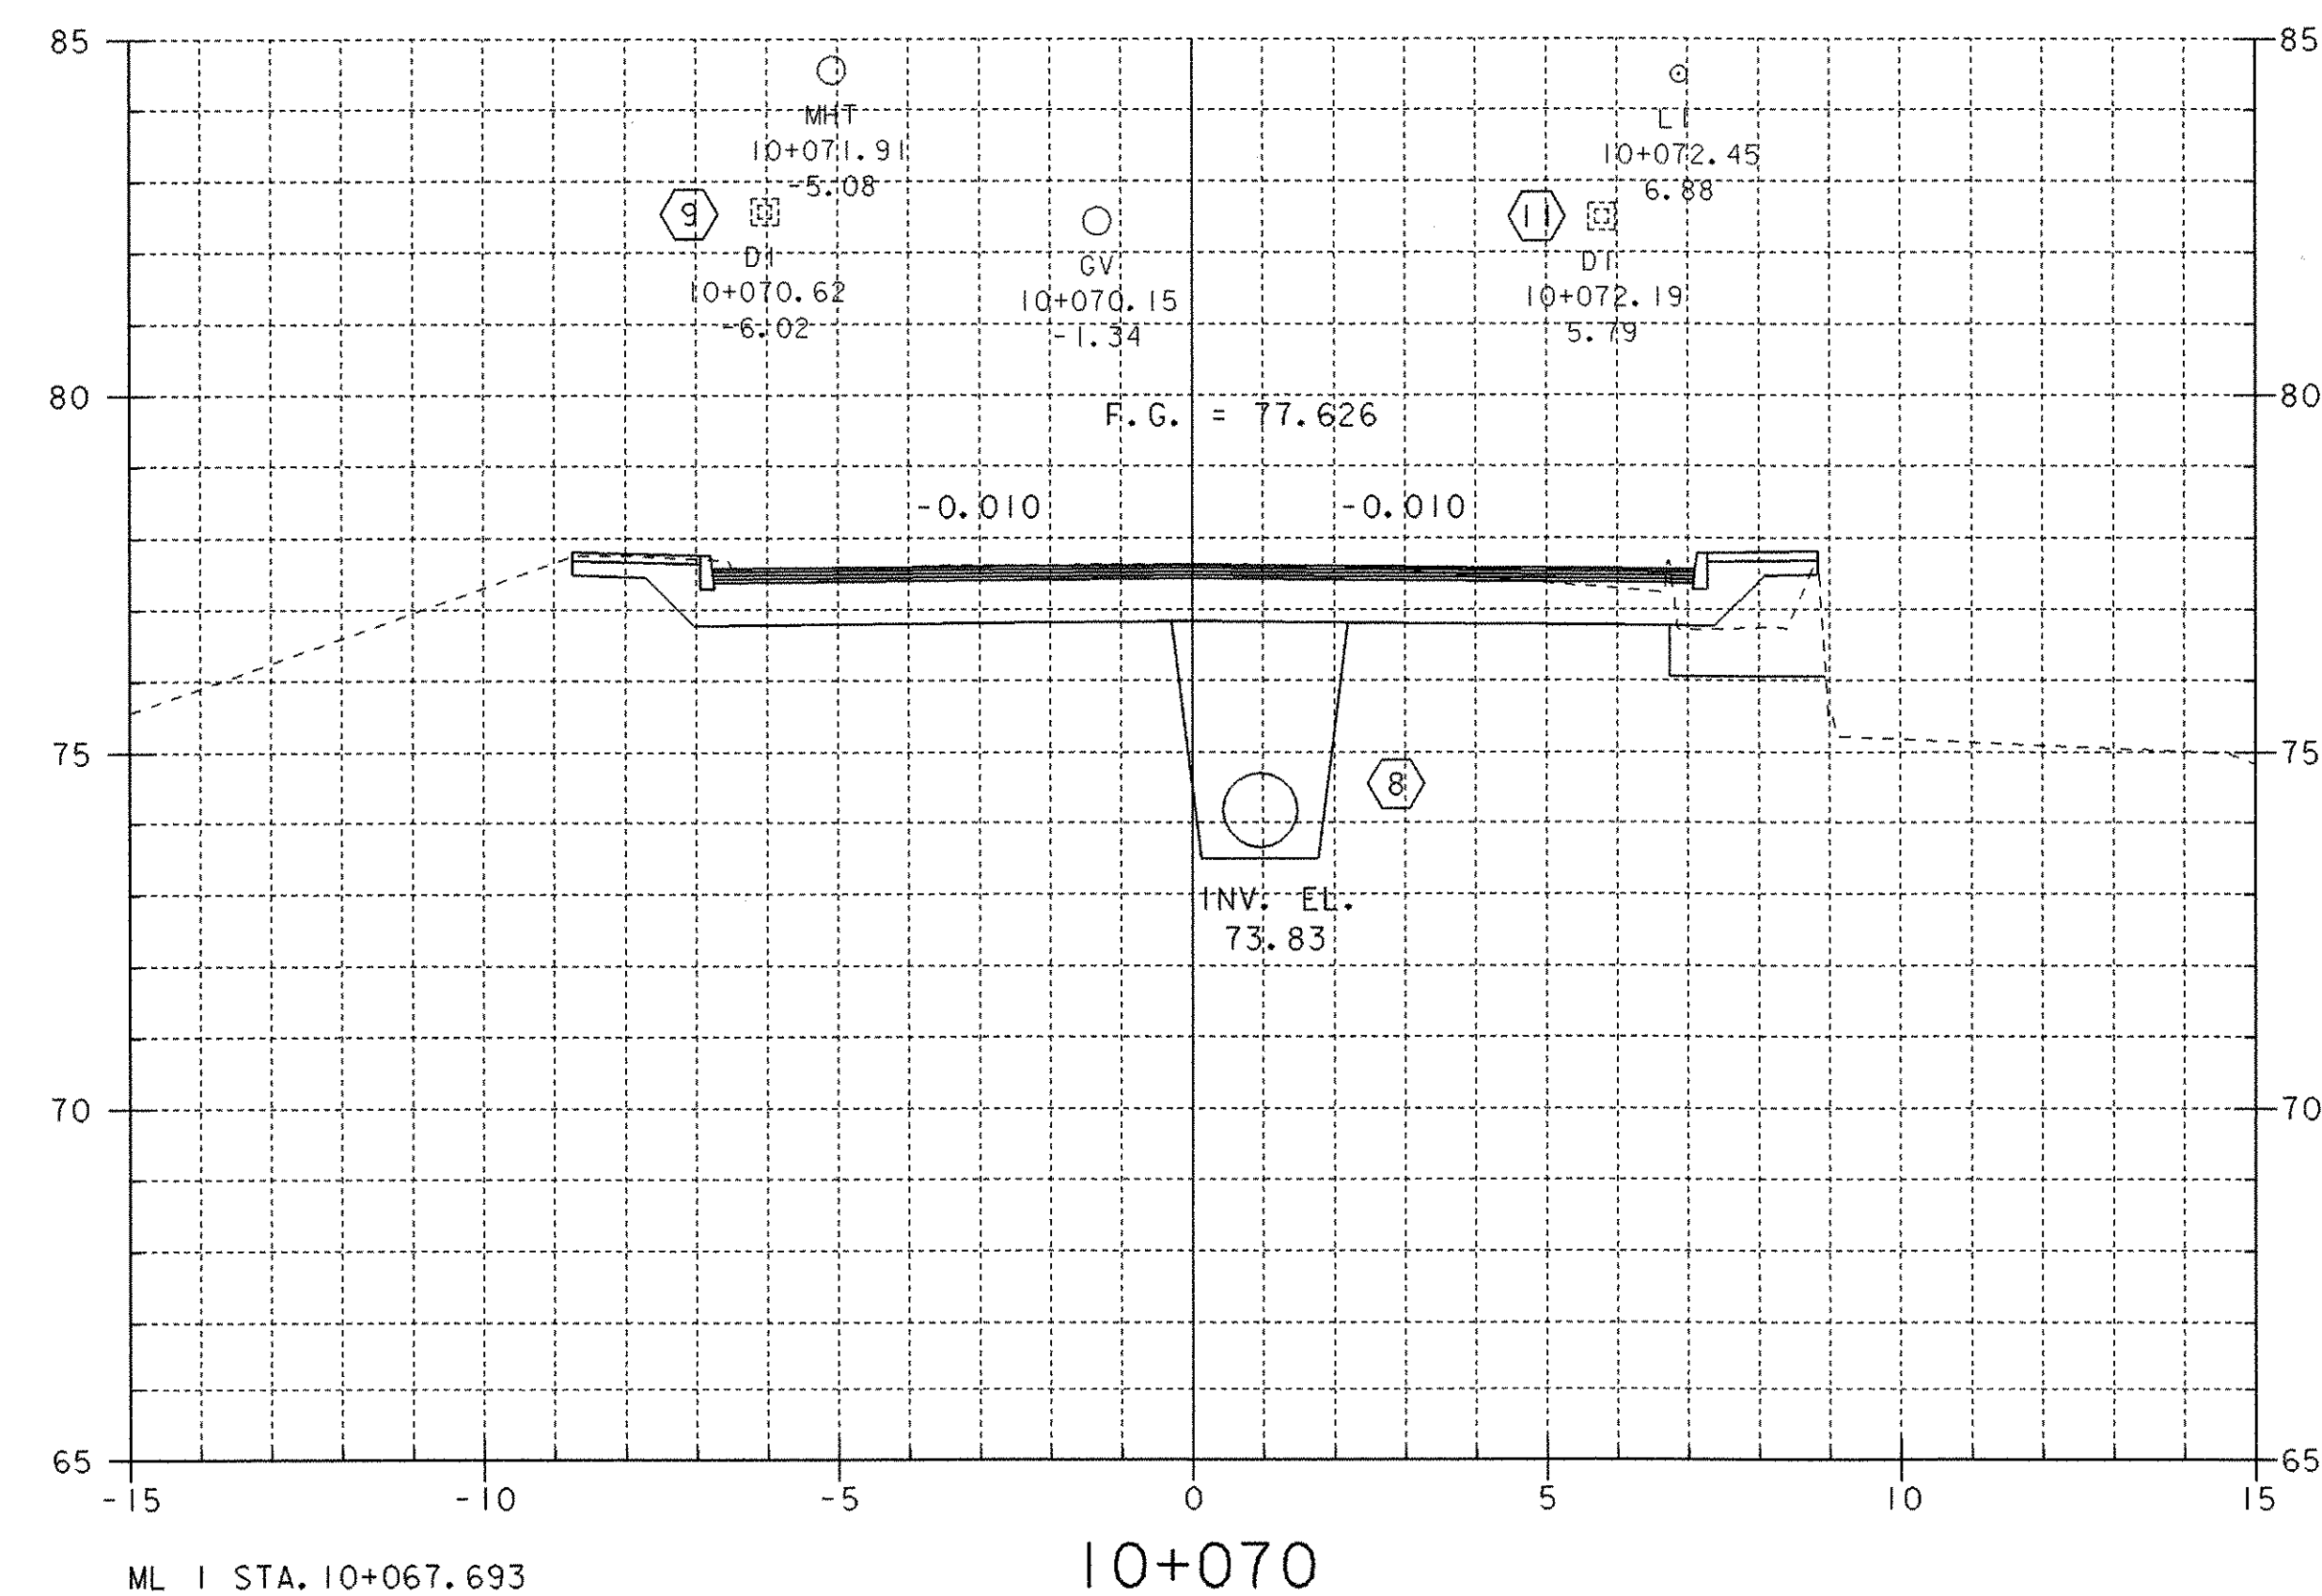
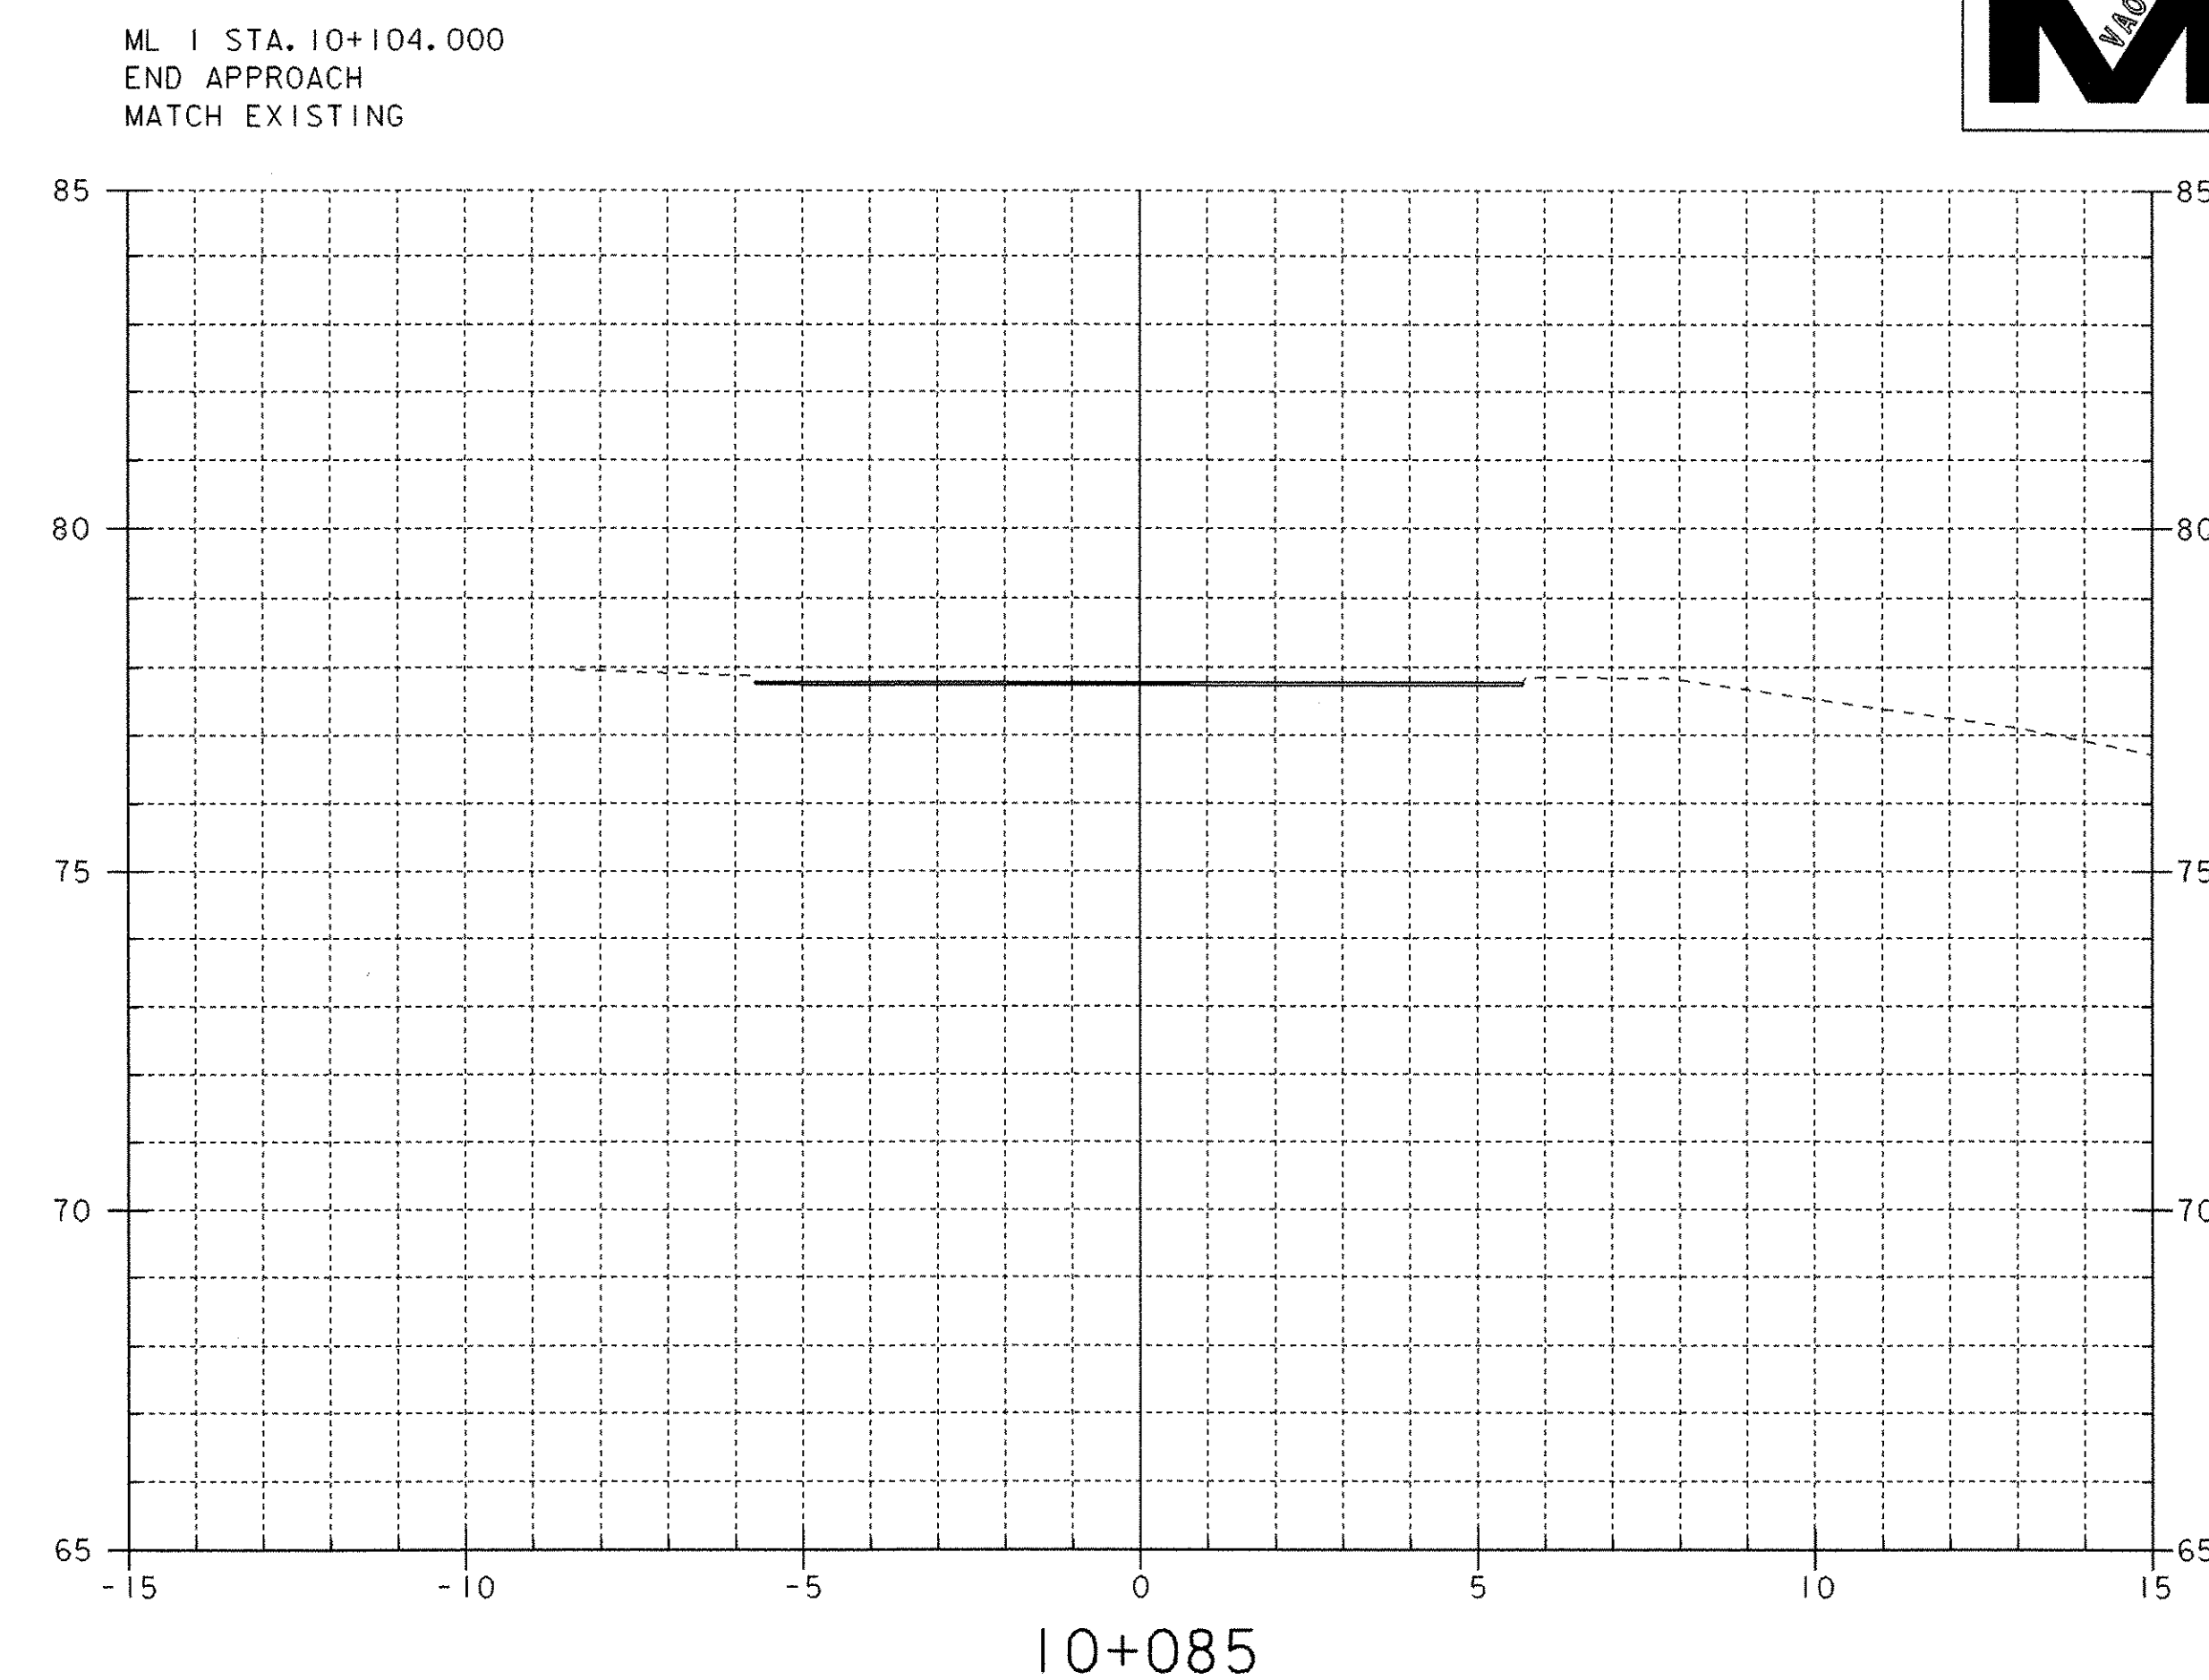


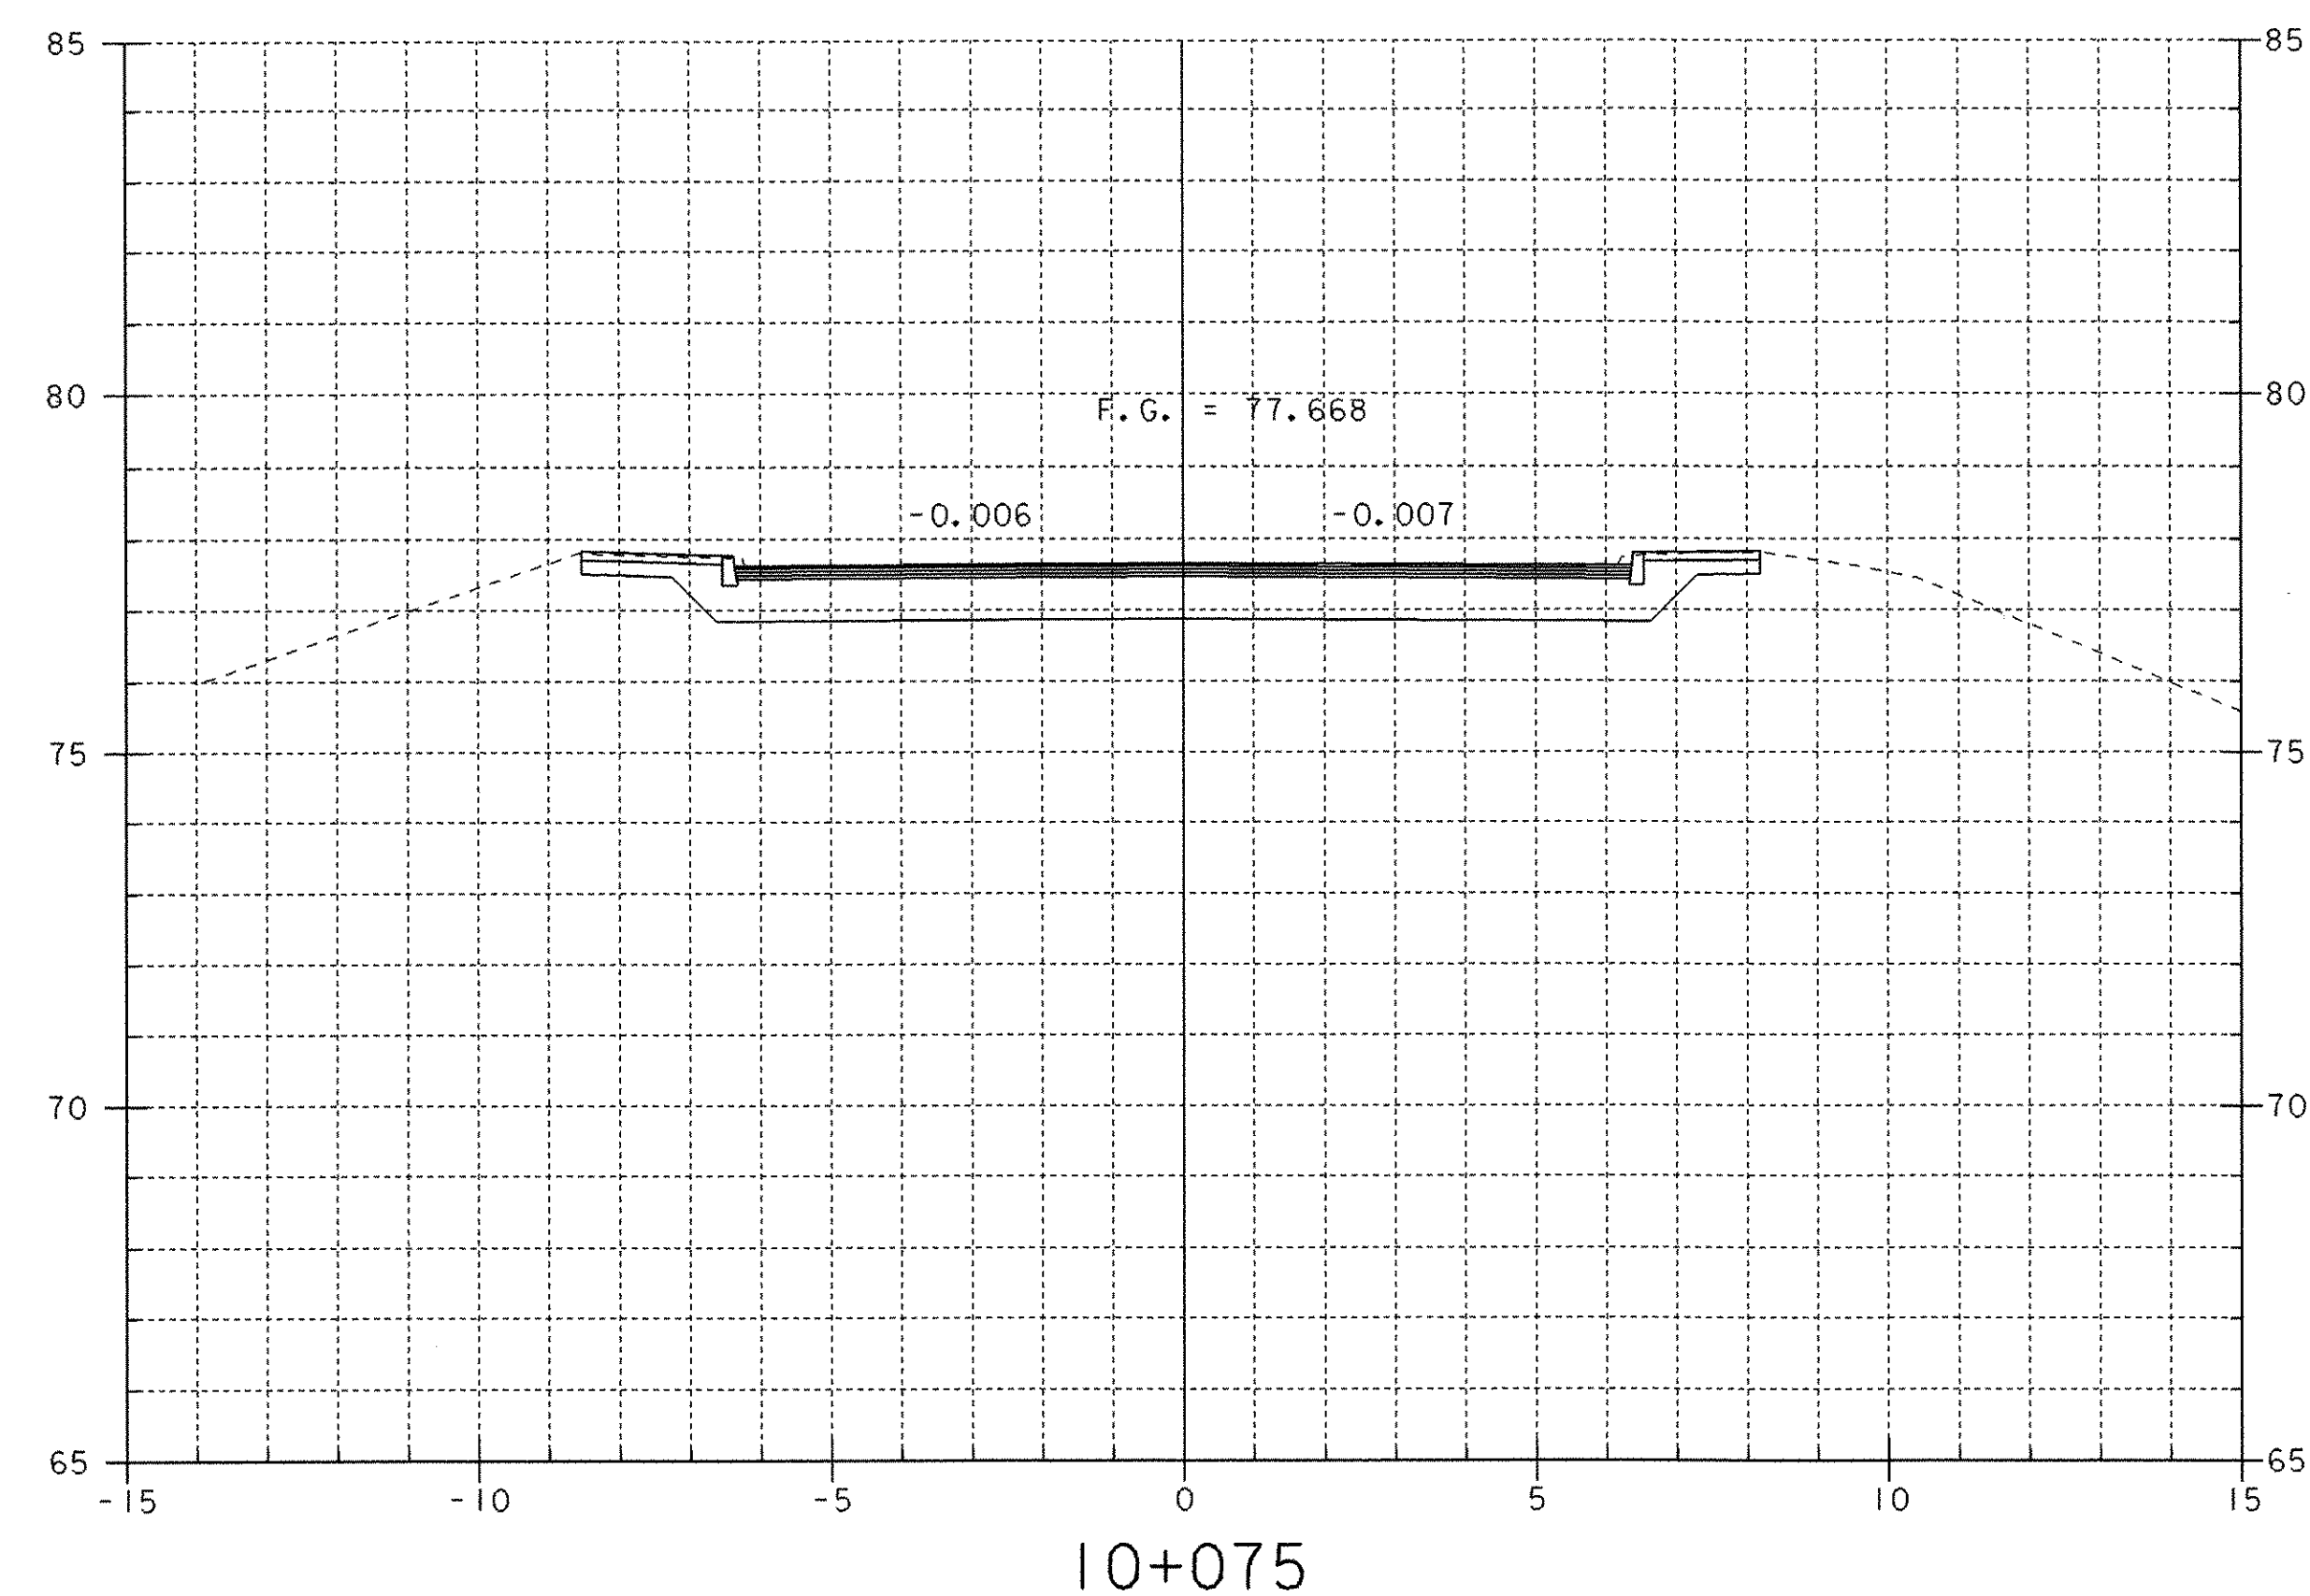

ML 1 STA. 10+067.693  
END BRIDGE/PROJECT  
BEGIN APPROACH

MAIN ST. CROSS SECTIONS (4)

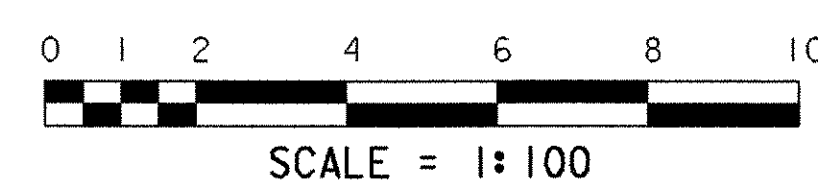

|                 |               |                  |                              |             |             |
|-----------------|---------------|------------------|------------------------------|-------------|-------------|
| PROJECT NAME:   | BRATTLEBORO   | FILE NAME:       | 94j078\Structures\sj078m04.i | PLOT DATE:  | 06-FEB-2003 |
| PROJECT NUMBER: | BHF 2000 (17) | PROJECT MANAGER: | R. R. WHITCOMB               | DRAWN BY:   | G. ROY      |
|                 |               | DESIGNED BY:     | G. ROY                       | CHECKED BY: | T. SUMNER   |
|                 |               |                  |                              | SHEET       | 64 OF 71    |