


ML 2 STA. 20+005.000
BEGIN APPROACH
MATCH EXISTING

MAINLINE 2 CROSS SECTIONS (1)

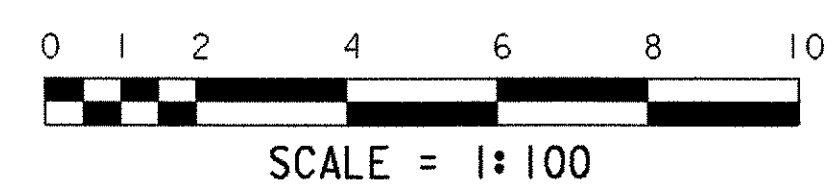

PROJECT NAME:	BRATTLEBORO	FILE NAME:	94j078\Structures\sj078m05.1	PLOT DATE:	06-FEB-2003
PROJECT NUMBER:	BHF 2000 (17)	PROJECT MANAGER:	R. R. WHITCOMB	DRAWN BY:	G. ROY
		DESIGNED BY:	G. ROY	CHECKED BY:	T. SUMNER
				SHEET	65 OF 71