


50+040

CHANNEL STA. 50+037.83 FAR RT.
 BEGIN STRUCTURE EXCAVATION
 GRANULAR BACKFILL FOR STRUCTURES

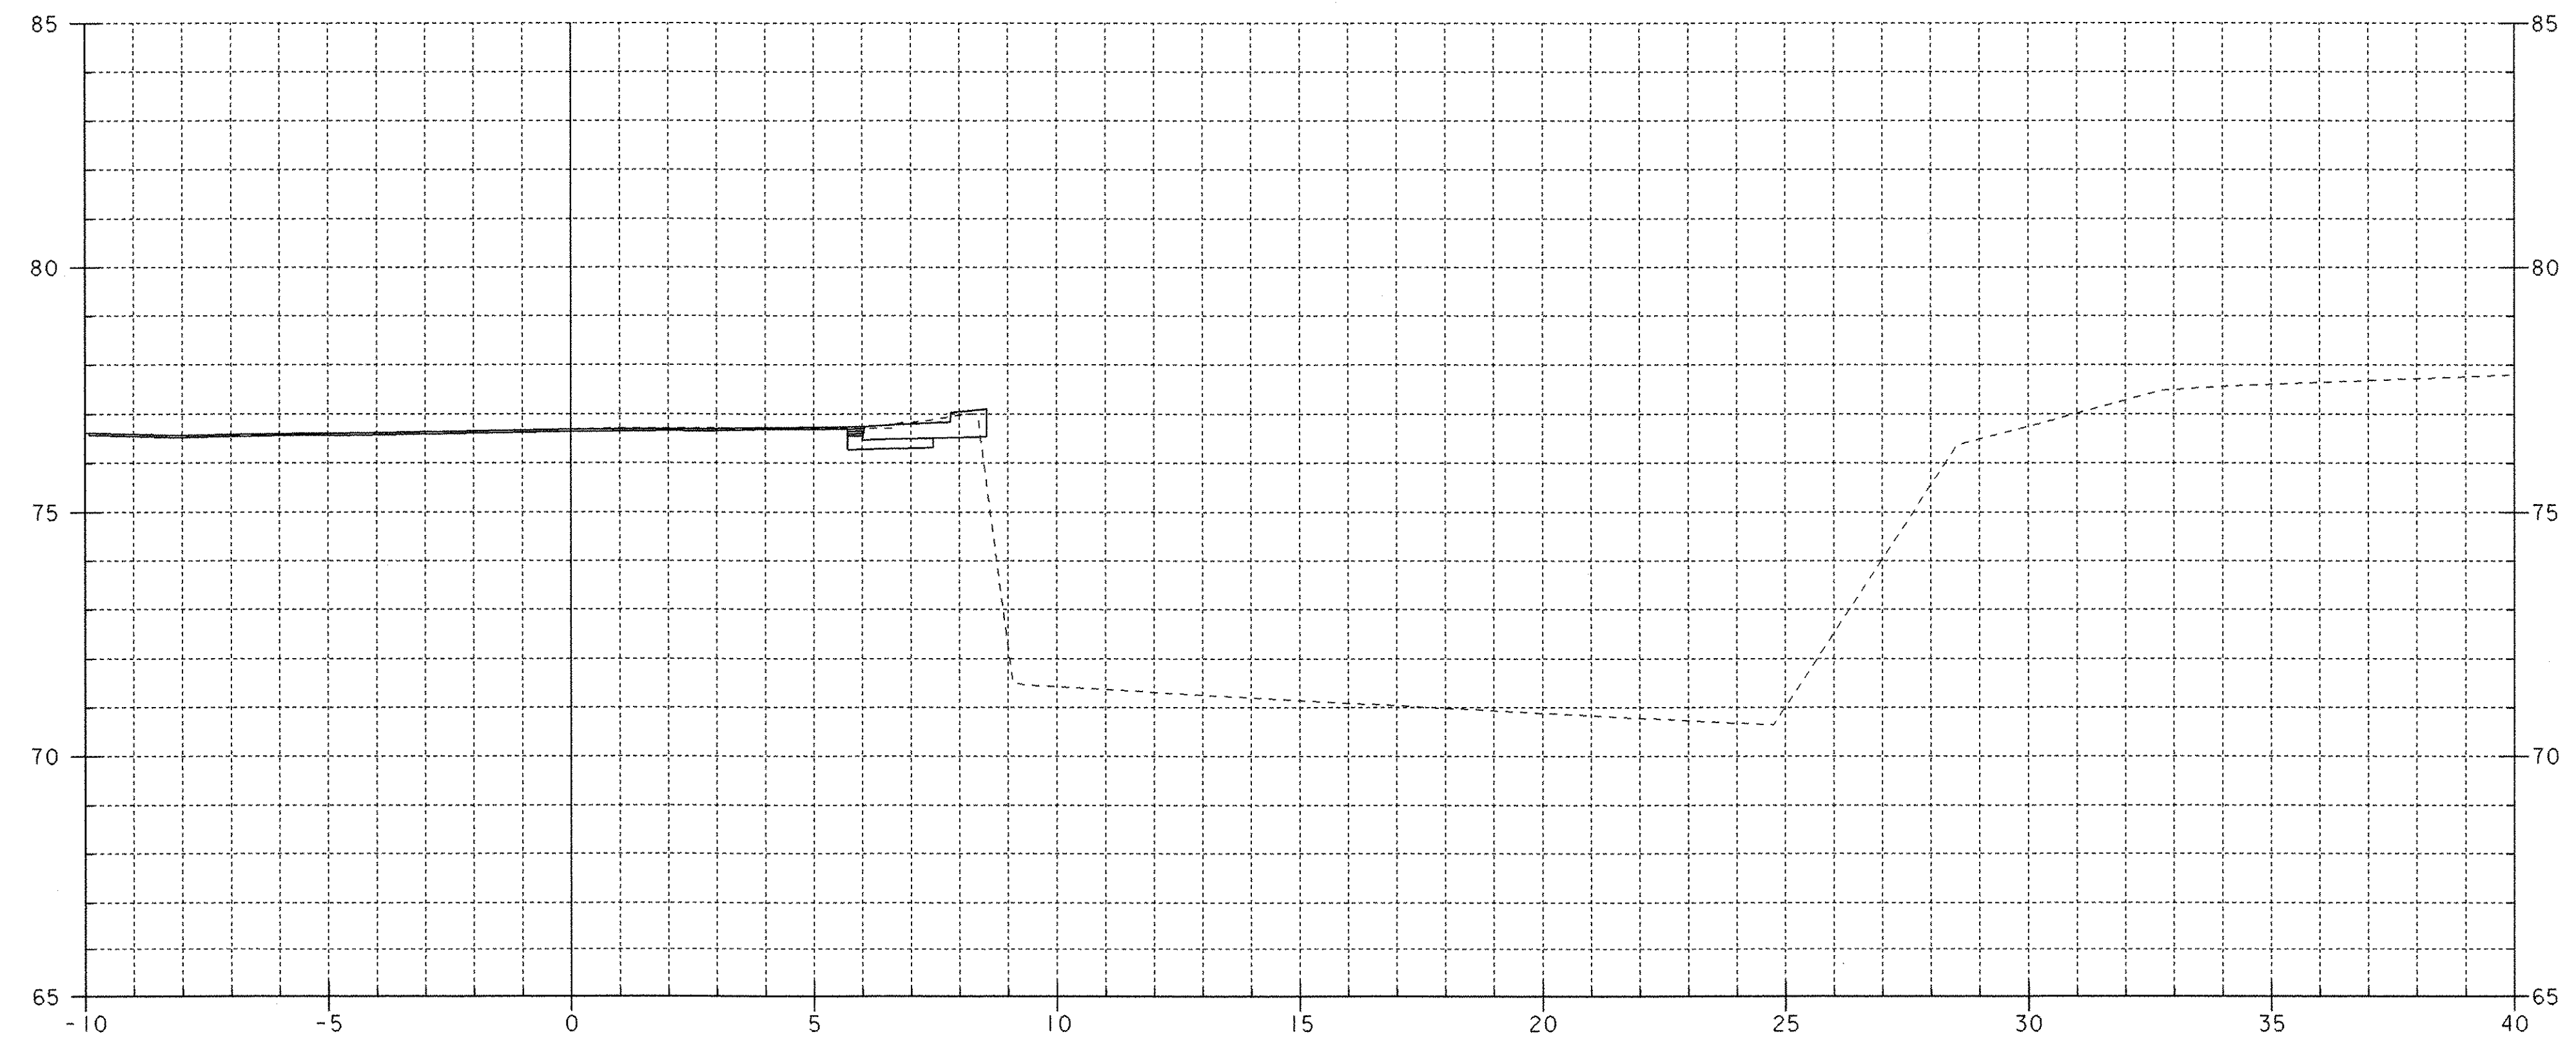


50+035

CHANNEL STA. 50+035.00 RT.
 BEGIN STRUCTURE EXCAVATION
 GRANULAR BACKFILL FOR STRUCTURES

NOTE:
 SEE SHEET 60 FOR DRAINAGE
 DETAILS AT END OF ABUT. NO. 2

CHANNEL CROSS SECTIONS (1)

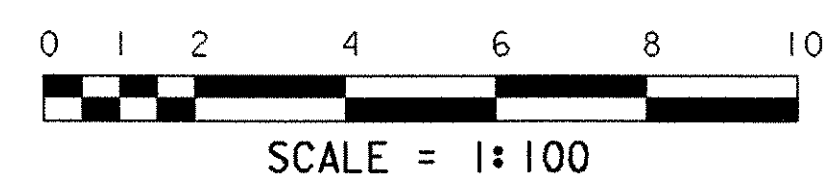

PROJECT NAME:	BRATTLEBORO	FILE NAME:	94J078\Structures\sj078c01I	PLOT DATE:	06-FEB-2003
PROJECT NUMBER:	BHF 2000 (17)	PROJECT MANAGER:	R. R. WHITCOMB	DRAWN BY:	G. ROY
		DESIGNED BY:	G. ROY	CHECKED BY:	T. SUMNER
				SHEET	68 OF 71