


NOTE:
SEE SHEET 60 FOR DRAINAGE
DETAILS AT END OF ABUT. NO.2

CHANNEL CROSS SECTIONS (2)

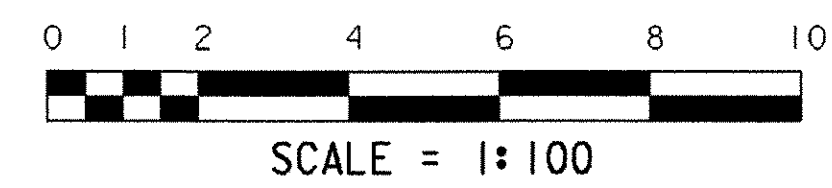

PROJECT NAME:	BRATTLEBORO	FILE NAME:	94j078\Structures\sj078c02.i	PLOT DATE:	06-FEB-2003
PROJECT NUMBER:	BHF 2000 (17)	PROJECT MANAGER:	R. R. WHITCOMB	DRAWN BY:	G. ROY
		DESIGNED BY:	G. ROY	CHECKED BY:	T. SUMNER
					SHEET 69 OF 71