



50+060

CHANNEL STA. 50+055.97 FAR RT.
END STRUCTURE EXCAVATION
GRANULAR BACKFILL FOR STRUCTURES

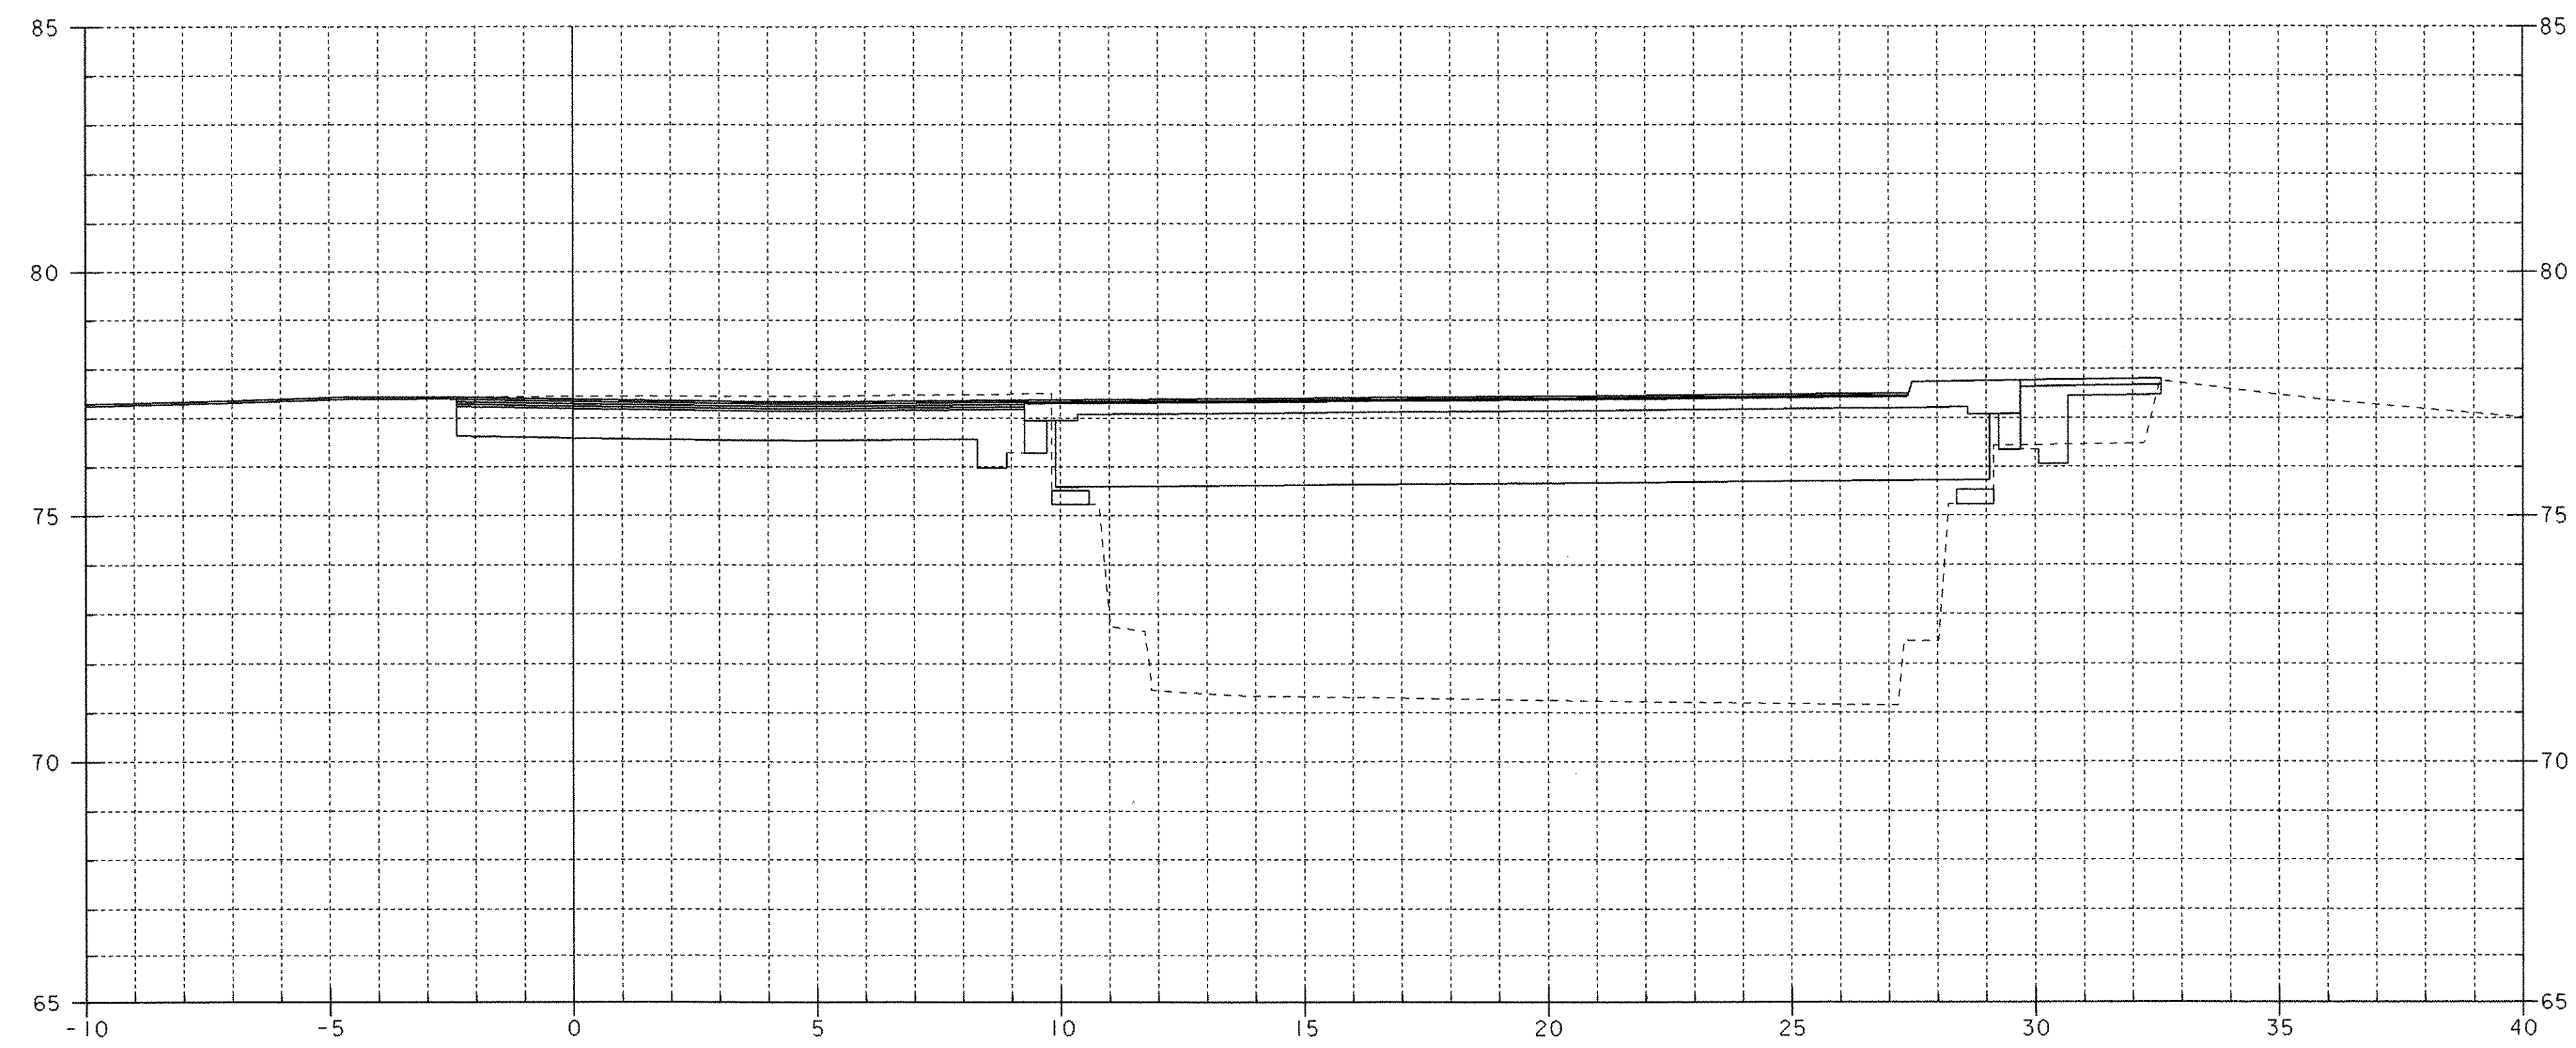

50+055

CHANNEL CROSS SECTIONS (3)

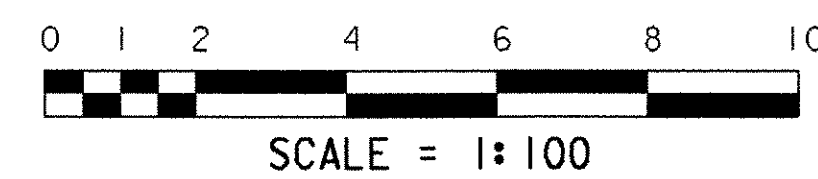

PROJECT NAME:	BRATTLEBORO	FILE NAME:	94J078\Structures\sj078c03.1	PLOT DATE:	06-FEB-2003
PROJECT NUMBER:	BHF 2000 (17)	PROJECT MANAGER:	R. R. WHITCOMB	DRAWN BY:	G. ROY
		DESIGNED BY:	G. ROY	CHECKED BY:	T. SUMNER
				SHEET	70 OF 71