



PLAN VIEW
1" = 40'

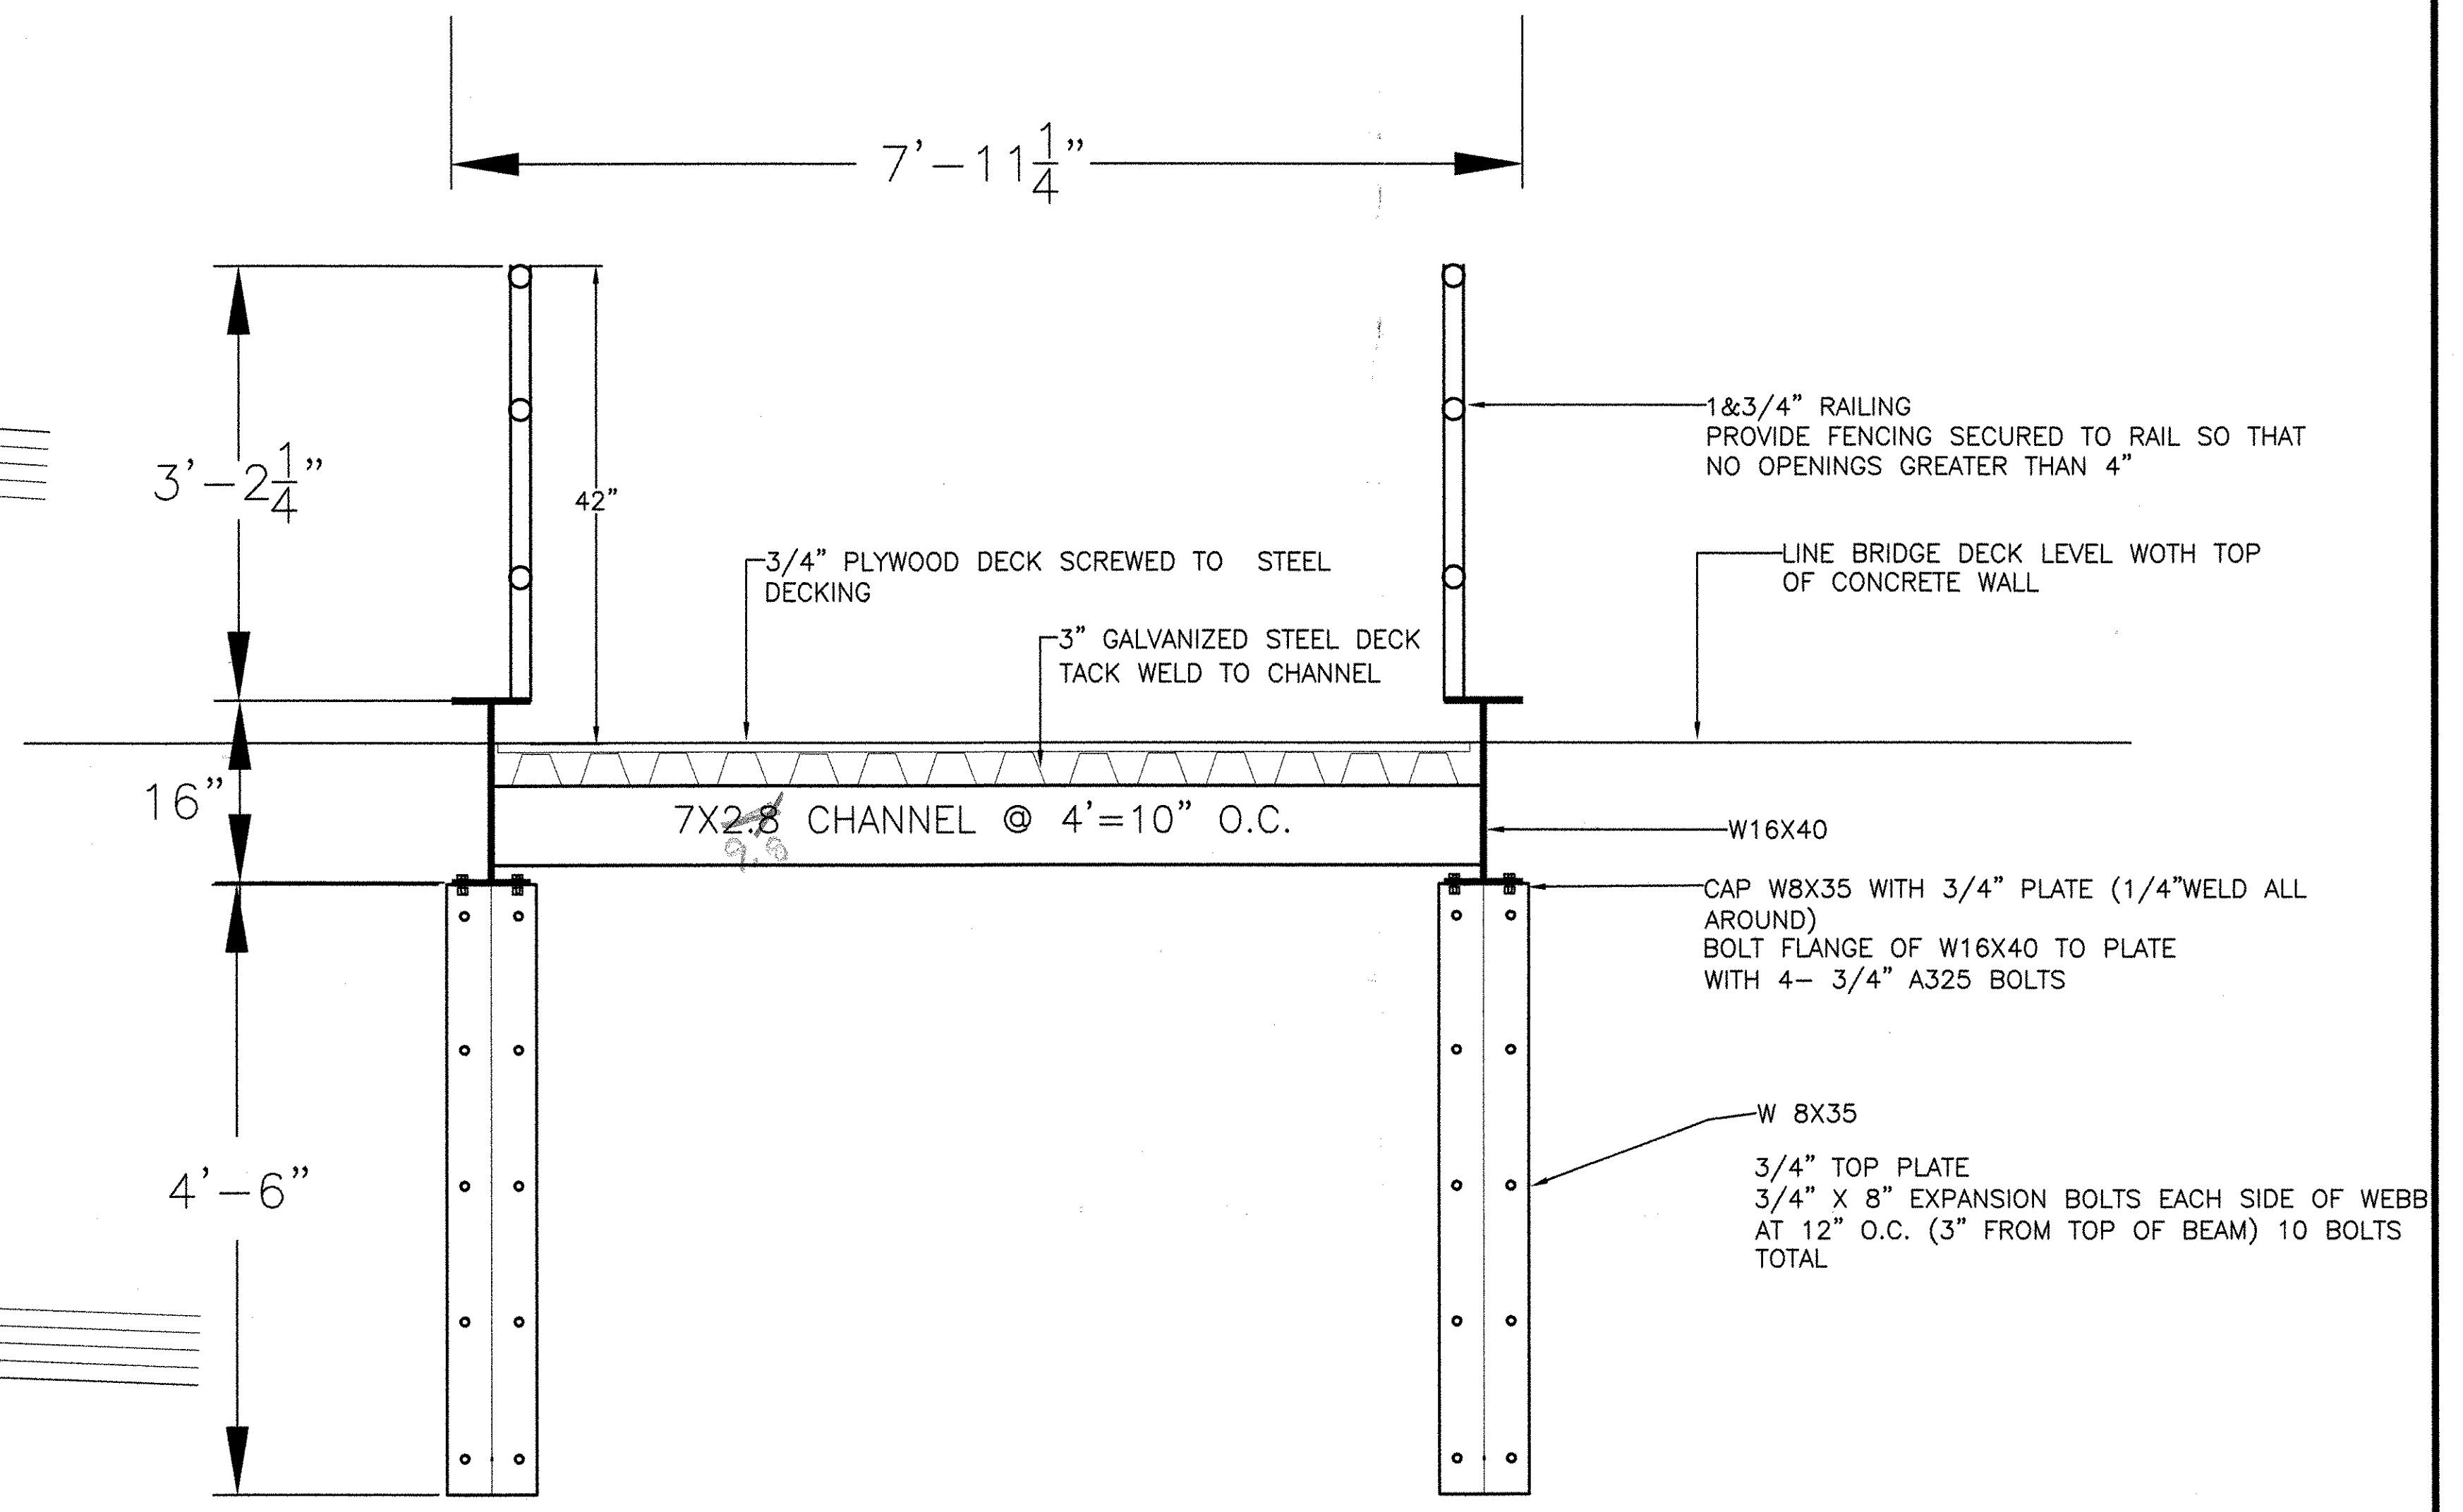

CROSS SECTION THROUGH BRIDGE DECK
1" = 1'

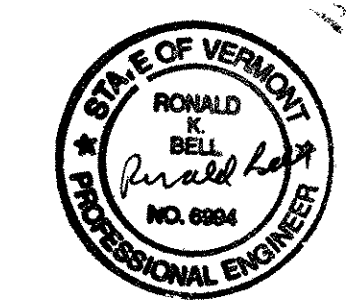

**PEDESTRIAN BRIDGE
FOR THE MAIN STREET BRIDGE REPAIR
BRATTLEBORO, VT**

 BELL ENGINEERING CIVIL & ENVIRONMENTAL 17 ECHO COVE WAY SPOFFORD, NH 03462 (603) 363-9966	DATE: 5-01-03	PROJECT NUMBER
	DESIGNED BY: RONALD BELL, PE	03-025
DRAWN BY: RONALD BELL, PE	SHEET	
SCALE: AS SHOWN	1	072

Rec'd. 5/5/03