




D:\HHP\BHP 2000(17) - sheet 13.3

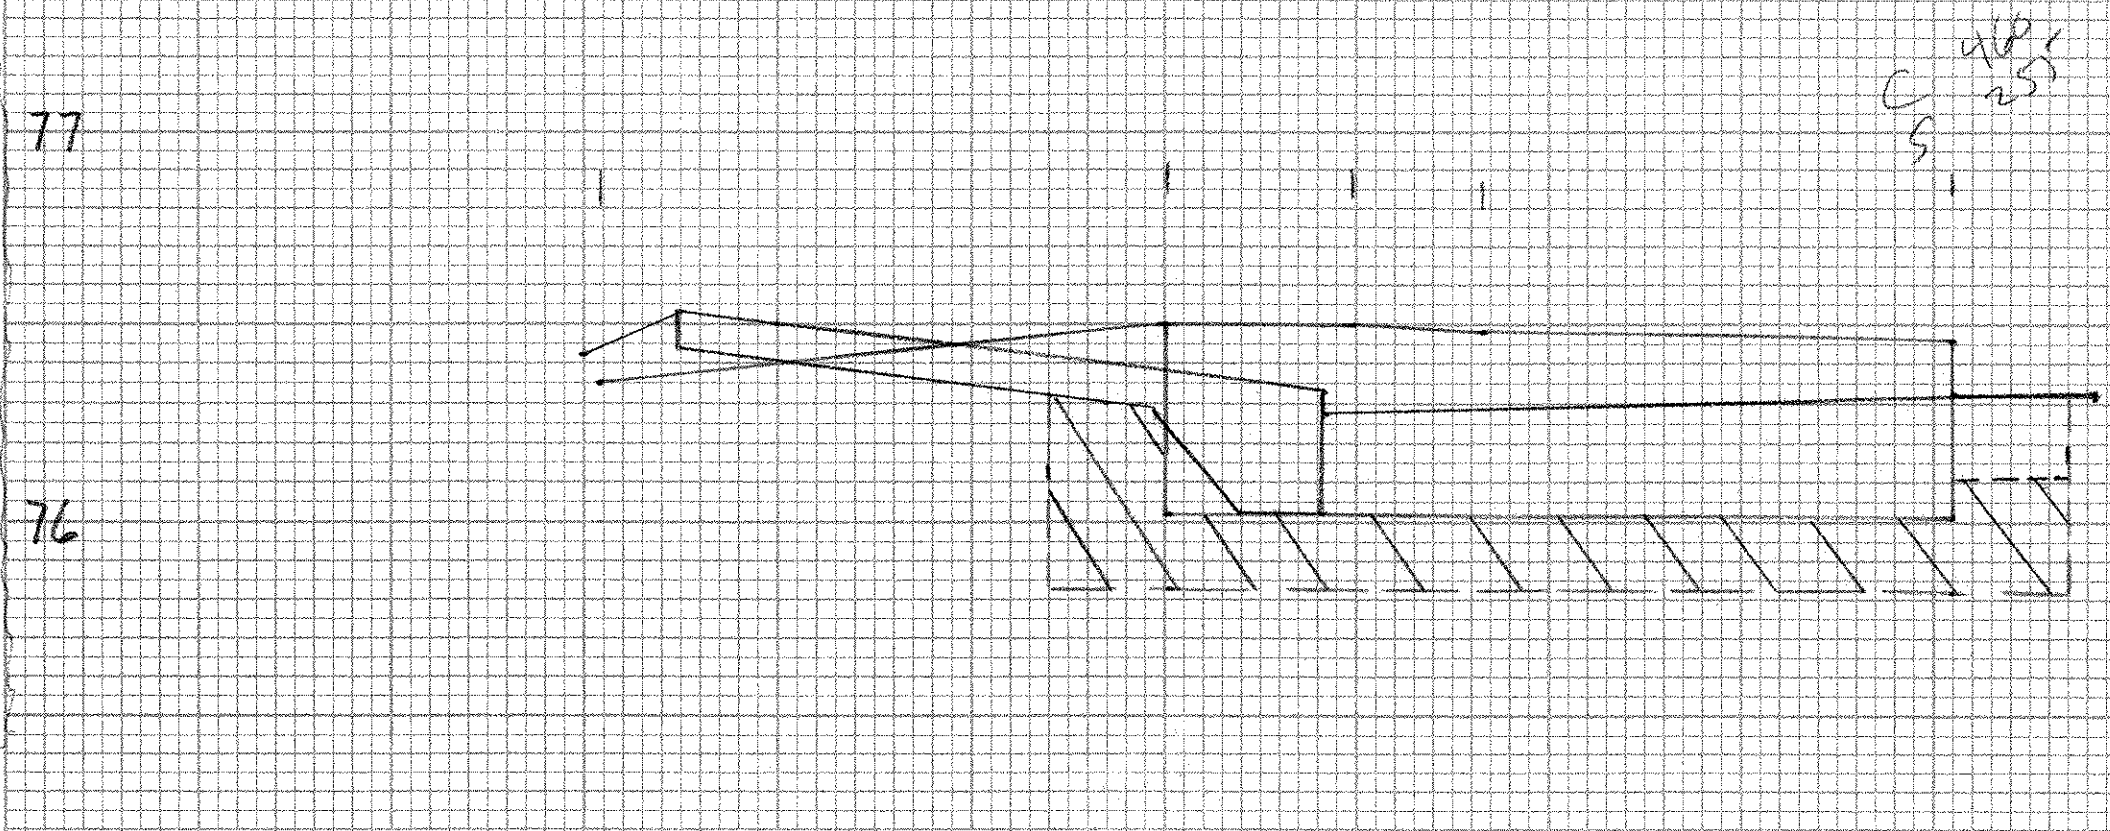

19.5 rt #

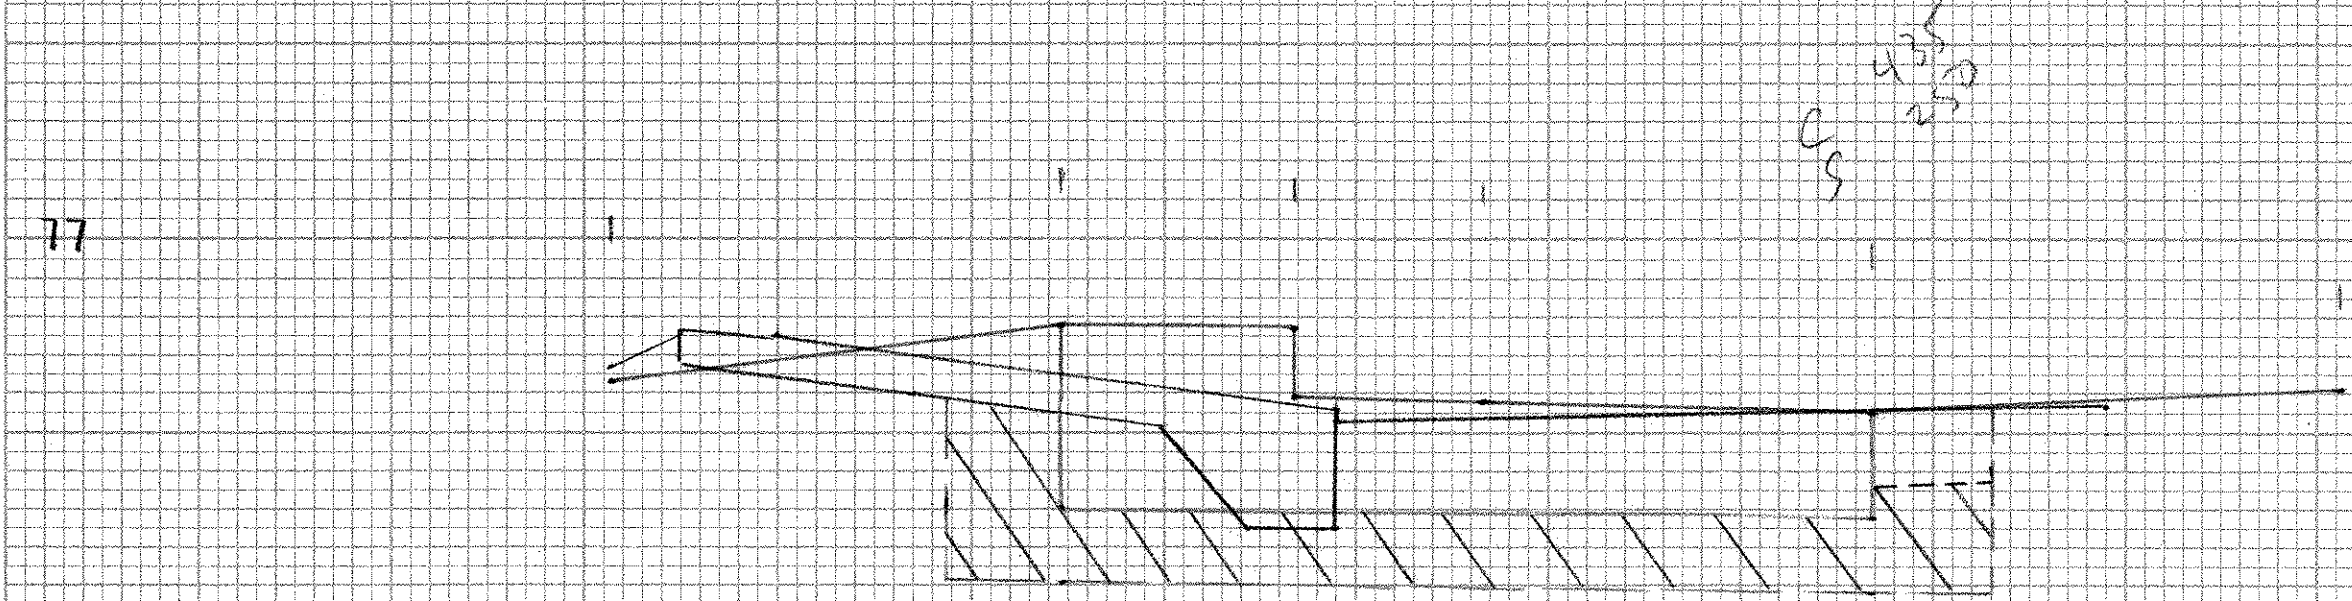

16.5 rt #

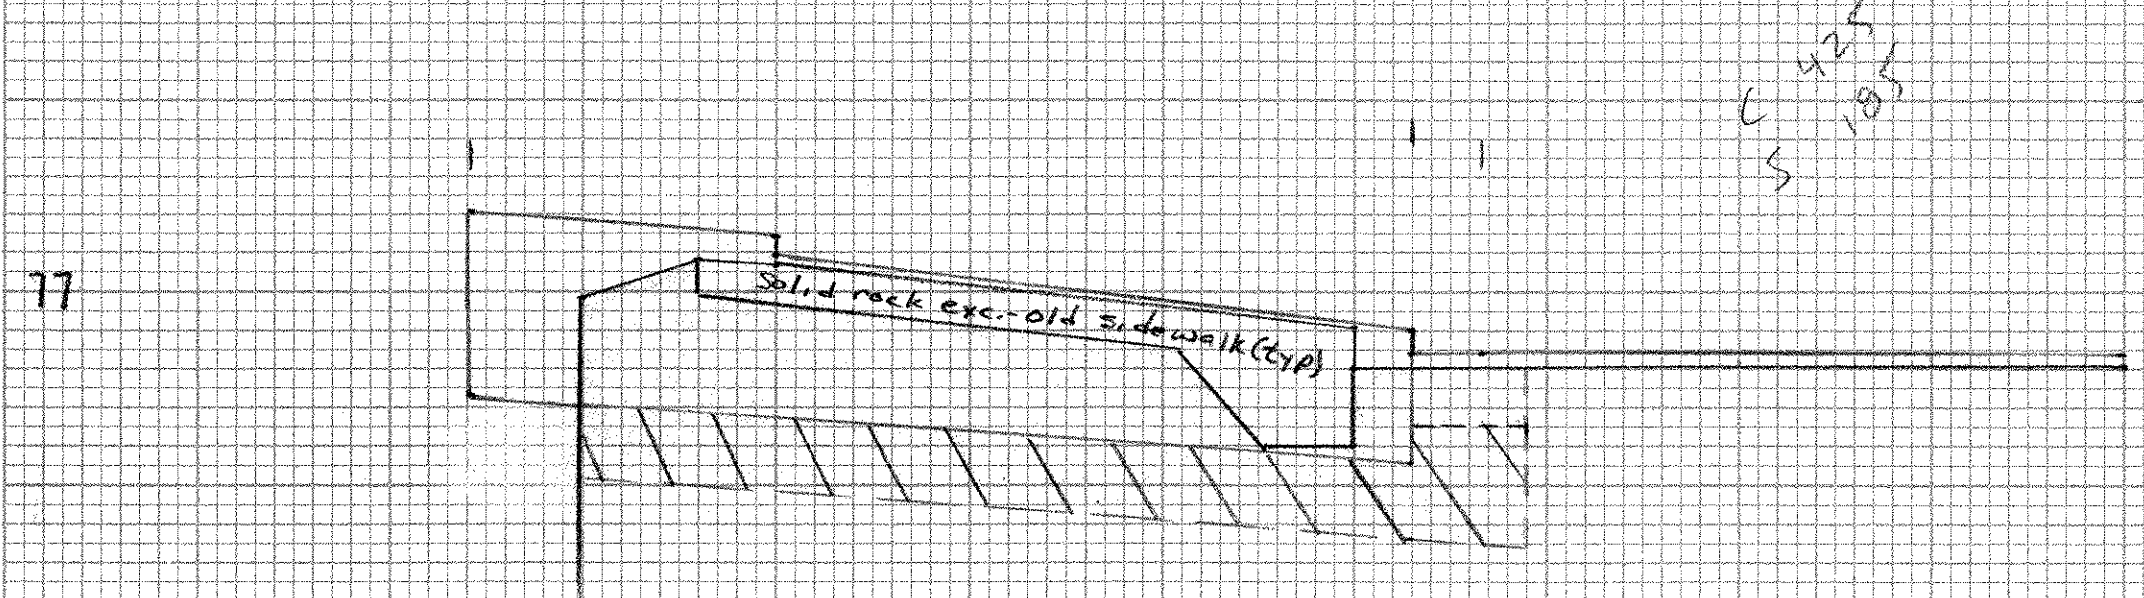

13.5 rt # use for 13.856 rt (butt)

67

Item 203.15 - Common Excavation


location	distance	end area	ave. end area	volume
13.856 (butt)		1.06		
16.5	2.644	1.075	1.075	2.84
19.5	3.0	1.12	1.12	3.36
22.5	3.0	1.19	1.19	3.57
25.5	3.0	1.23	1.23	3.77
27.5 (butt)	2.0	1.28	1.28	2.56
				16.10 cu yd 4-24 FWT

= Common Excavation


= Subbase of Dense Graded Crushed Stone

Item 301.35 - Subbase of Dense Graded Crushed Stone

location	distance	end area	ave. end area	volume
13+856 (butt)		0.46		
16.5	2.644	0.545	0.545	1.44
19.5	3.0	0.63	0.63	1.91
22.5	3.0	0.64	0.64	1.92
25.5	3.0	0.64	0.64	1.92
27.5 (butt)	2.0	0.69	0.69	1.38
				8.65 cu yd 4-24 FWT

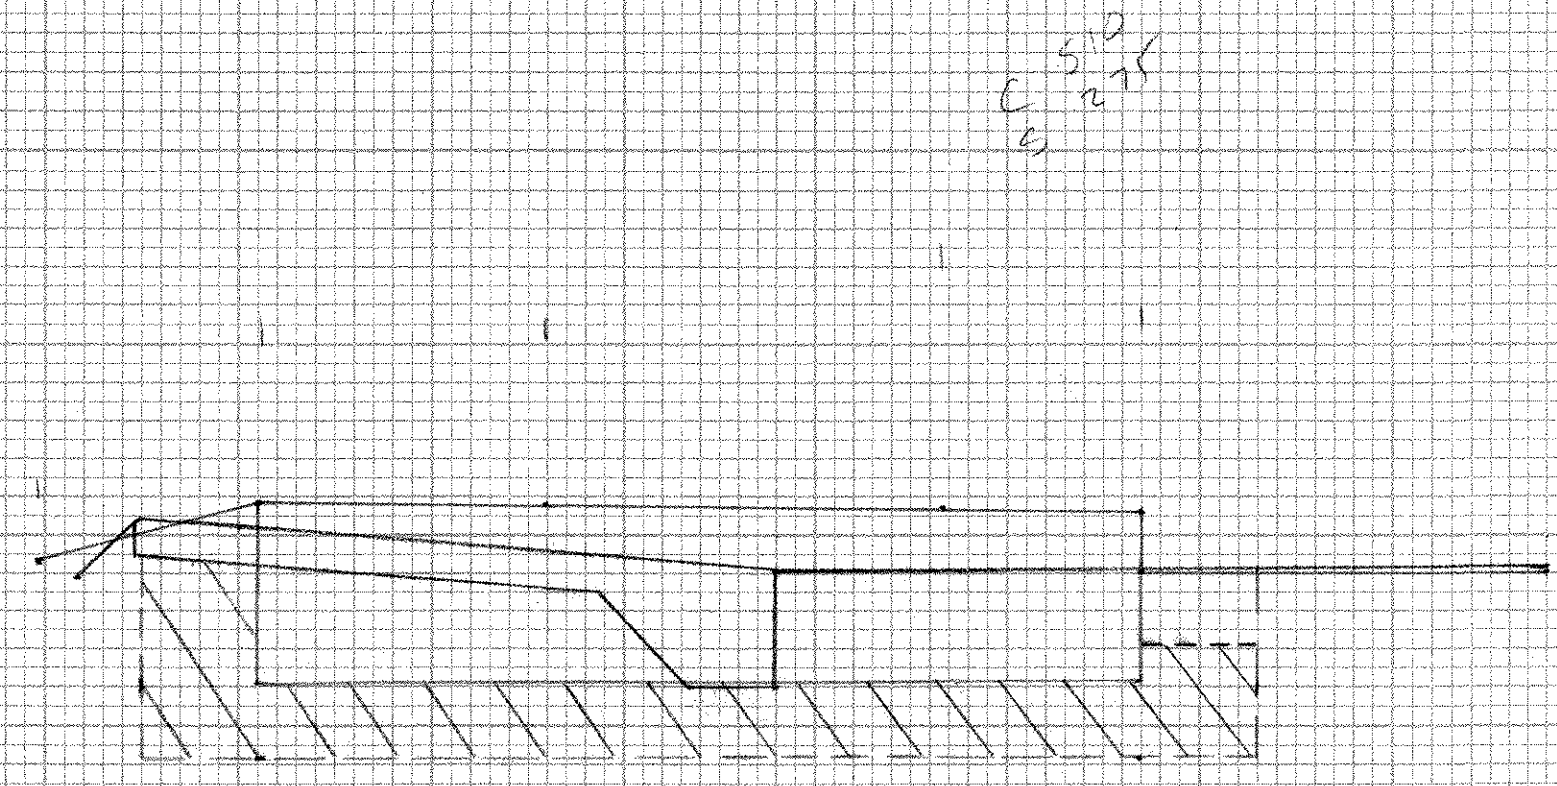

25.5 rt # use for 27.5 rt (butt)

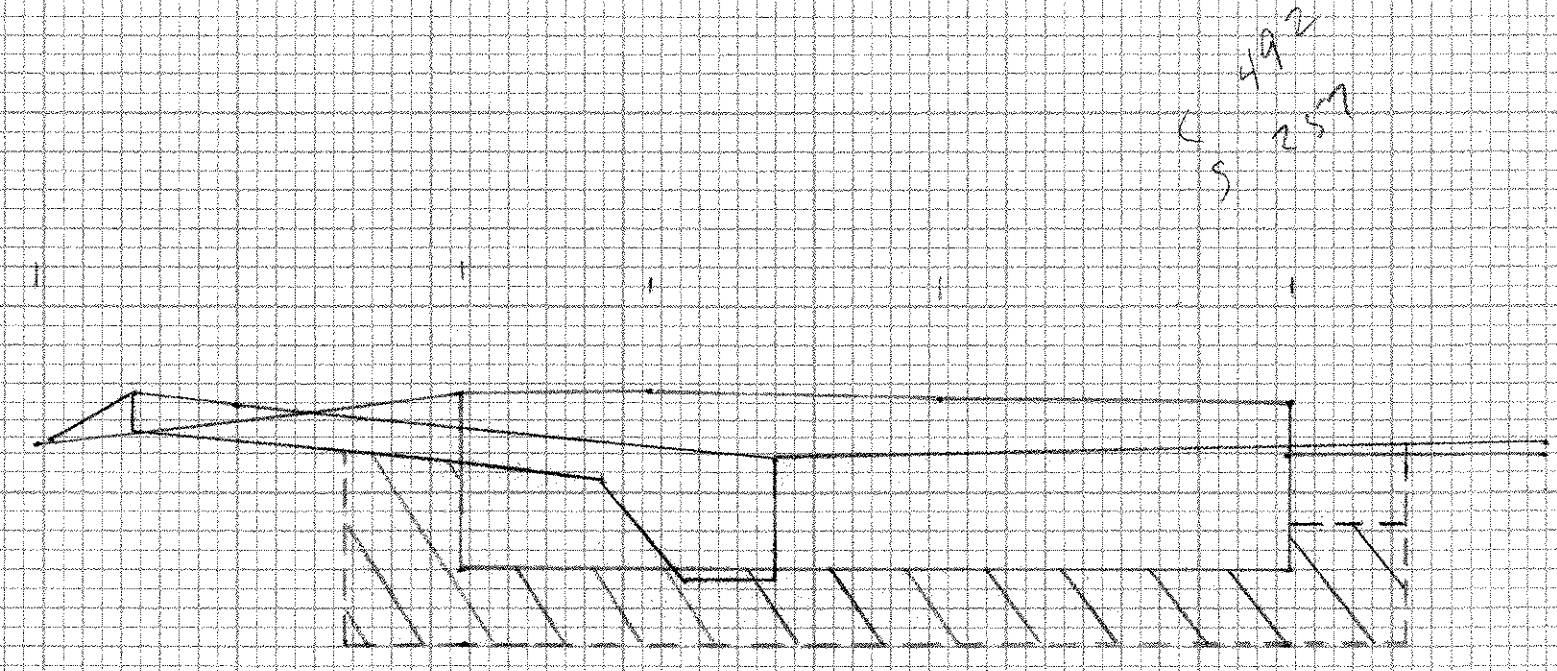

22.5 rt #

69

