

SEE SHEET 2 FOR INDEX OF SHEETS

STATE OF VERMONT AGENCY OF TRANSPORTATION




PROPOSED IMPROVEMENT BRIDGE PROJECT TOWN OF BRATTLEBORO COUNTY OF WINDHAM

ROUTE NO : US 5 (T.H.1) BRIDGE NO : 7

PROJECT LOCATION : BEGINNING APPROXIMATELY 0.010 KM FROM THE INTERSECTION OF US 5, VT 119, AND VT 142 AND PROCEEDING NORTHERLY FOR APPROXIMATELY 0.020 KM.


PROJECT DESCRIPTION : THE PROJECT SHALL CONSIST OF THE REHABILITATION OF BRIDGE NO.7 ALONG WITH RELATED ROADWAY APPROACH WORK.

LENGTH OF STRUCTURE : 20.355 METERS.
LENGTH OF ROADWAY : 0.000 METERS.
LENGTH OF PROJECT : 20.355 METERS.

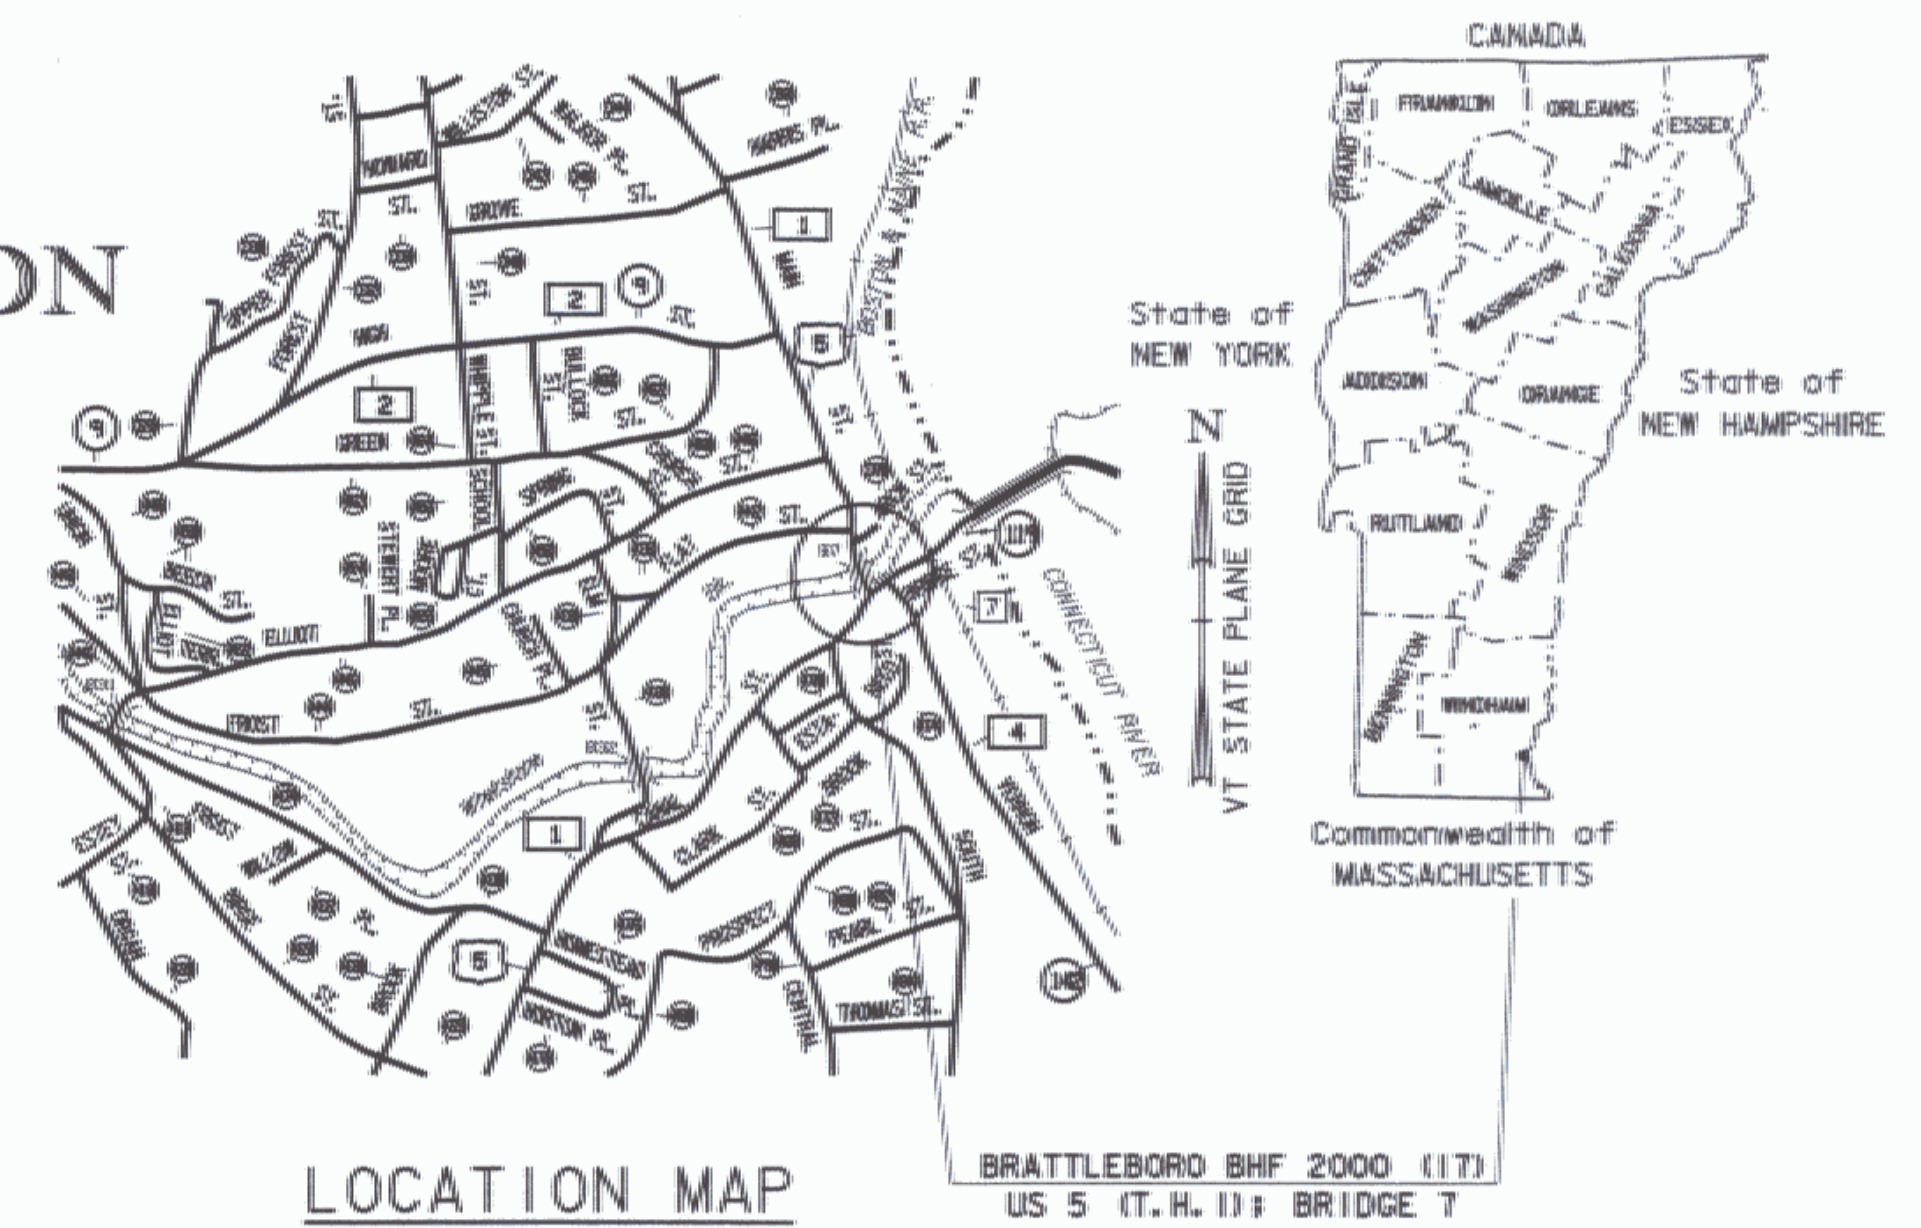

Renaud Bros., Inc.
Contractor
[Signature]
Signature
Vice President
Title

[Signature]
Director of Finance and Administration
or Duly Authorized Agent
4/1/03
Date

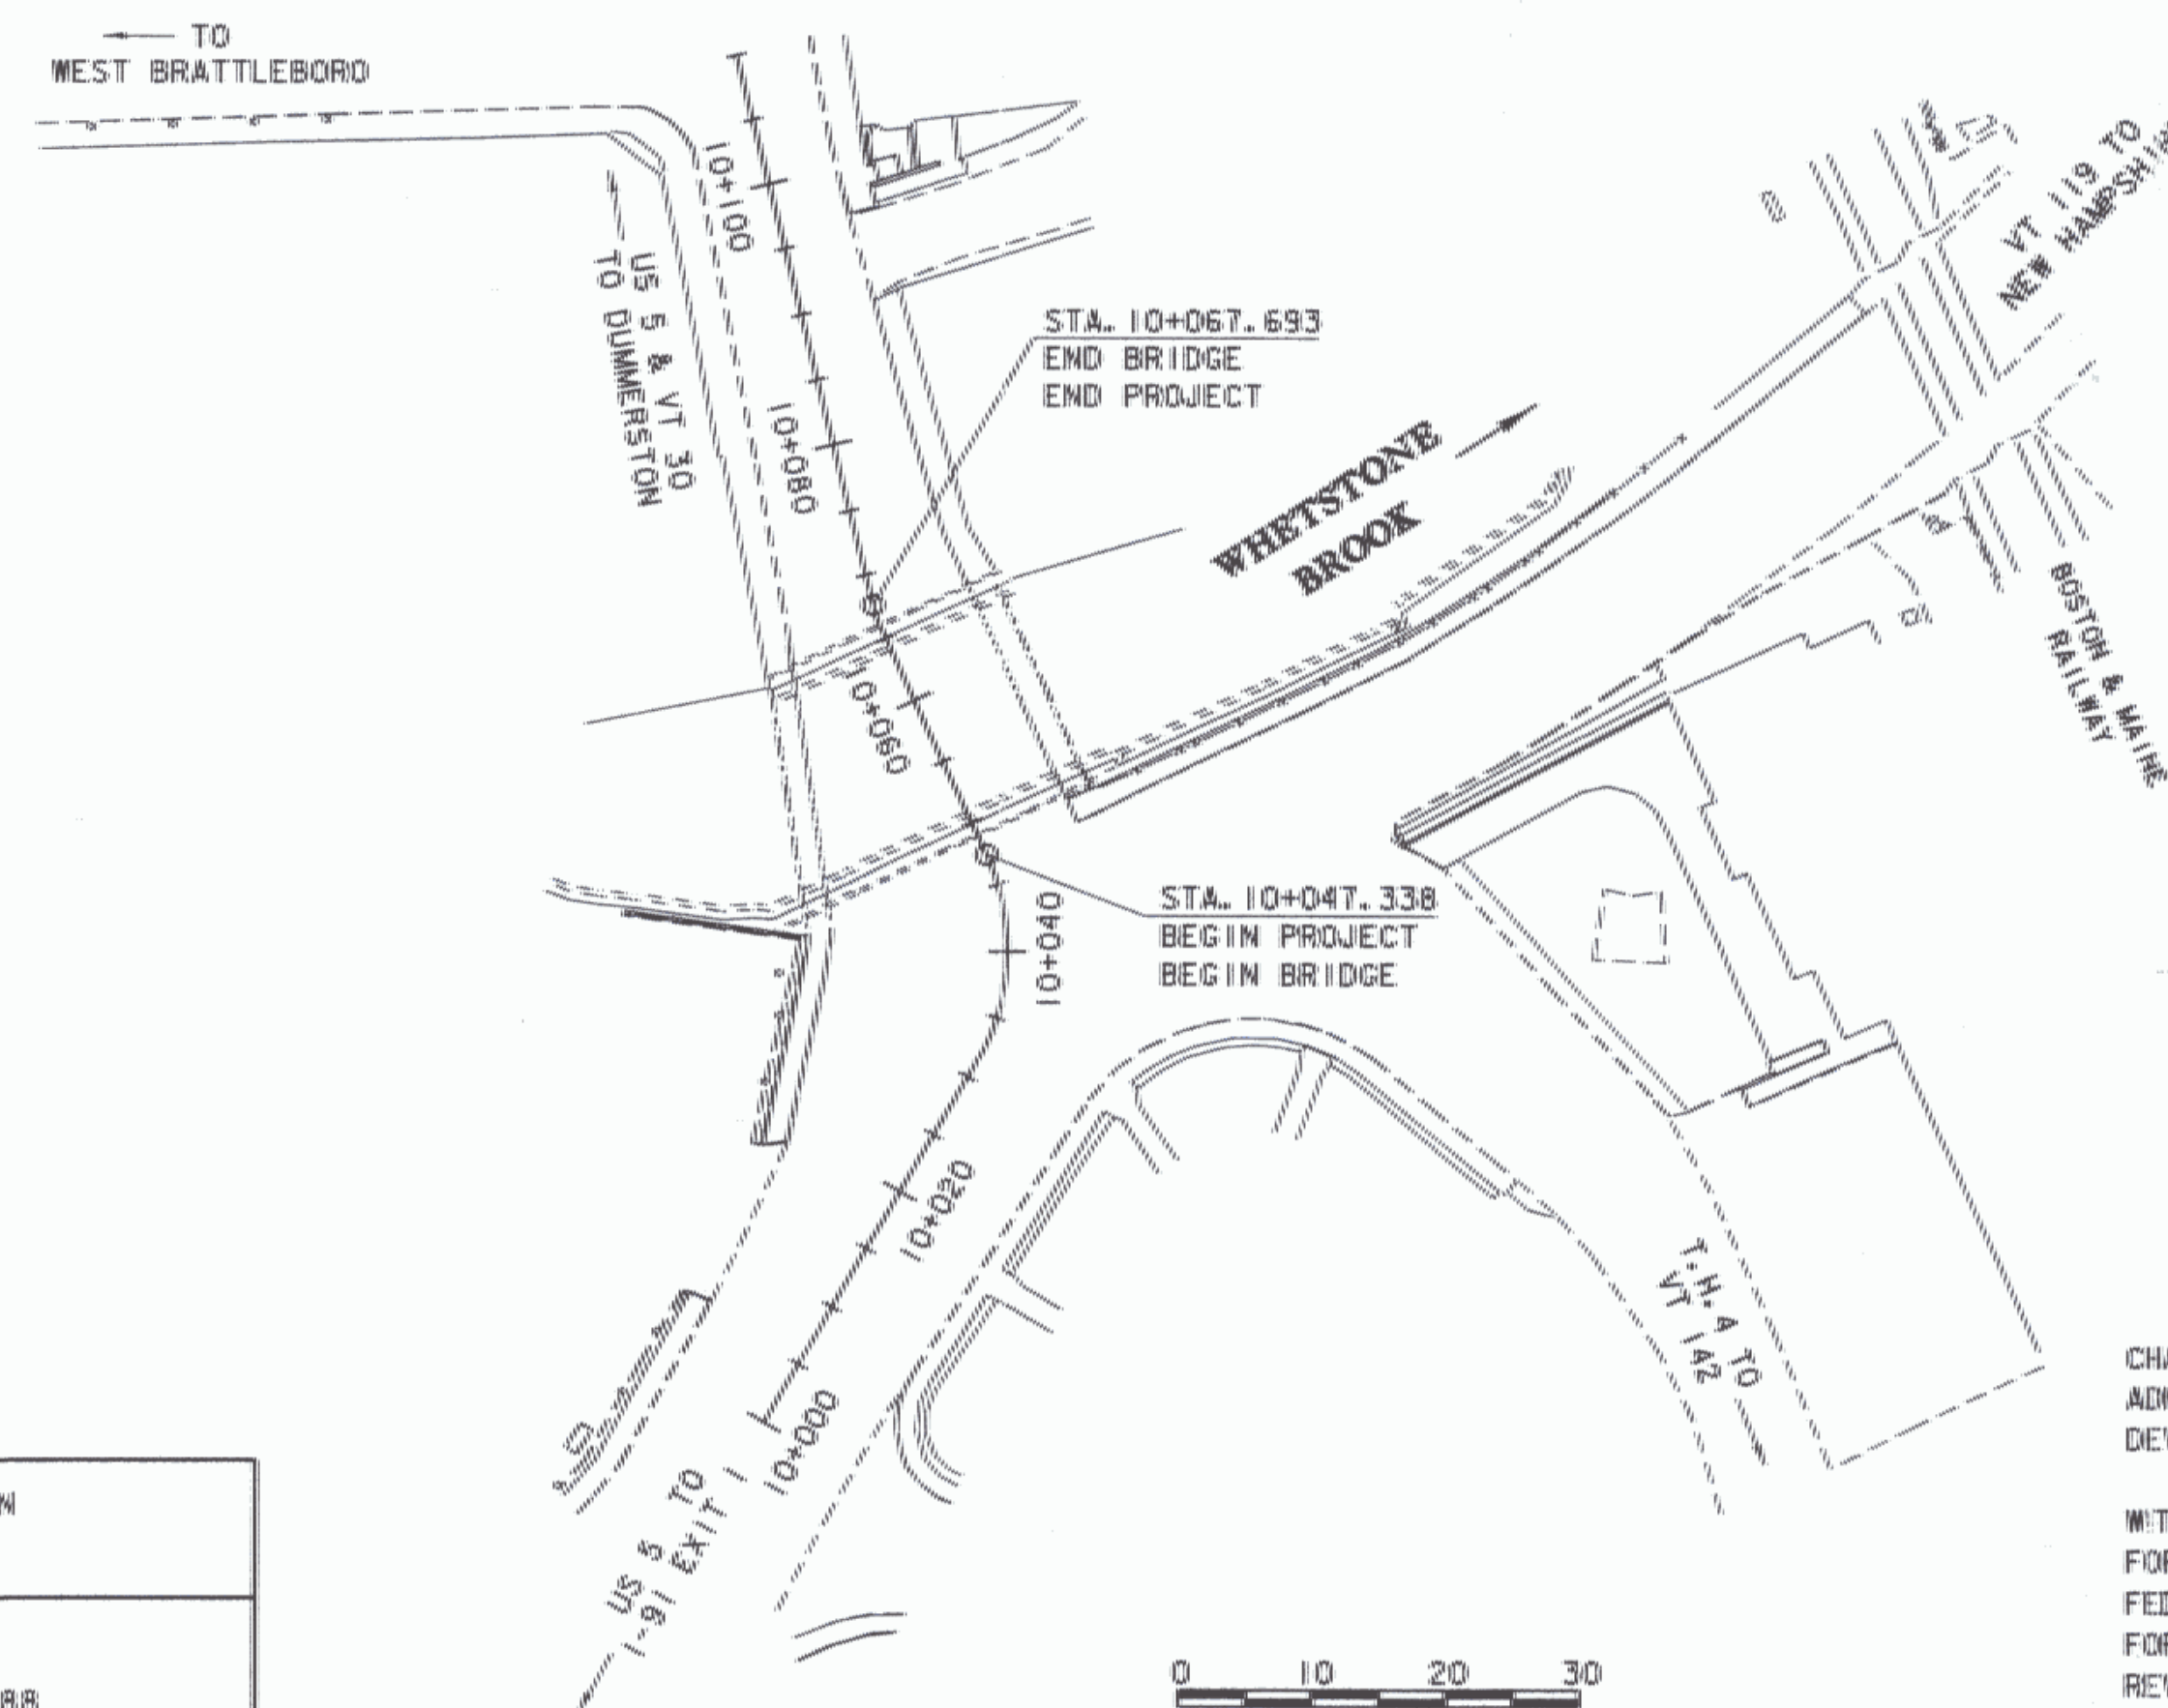

CONVENTIONAL SYMBOLS	
COUNTY LINE	———
TOWN LINE	———
LIMITS OF ACCESS	○ — ○
POINT OF ACCESS	X
FENCE LINE	X — X — X — X
STONE WALL	○ — ○ — ○ — ○
TRAVELED WAY	———
GUARD RAIL	○ — ○ — ○ — ○
RAILROAD	———
SURVEY LINE	———
CULVERT	———
POWER POLE	⊕
TELEPHONE POLE	⊕
TREES	⊕ * ⊕
CONTROL OF ACCESS	———
PROPERTY LINE	———
R.O.M. TAKING LINE	○ — SR — ○ — SR — ○ — SR
SLOPE RIGHTS	△ — △ — △ — △
TOP OF CUT	△ — △ — △ — △
TOE OF SLOPE	○ — ○ — ○ — ○

SURVEYED BY : R. GILMAN
SURVEYED DATE : 6/96

DATUM
VERTICAL NAVD 88
HORIZONTAL NAD 83 (92)

THESE PLANS ARE SUBJECT TO SUCH ENGINEERING CHANGES AS MAY BE REQUIRED BY THE FEDERAL HIGHWAY ADMINISTRATION OR THE DIRECTOR OF PROJECT DEVELOPMENT.

CONSTRUCTION IS TO BE CARRIED ON IN ACCORDANCE WITH THESE PLANS AND THE STANDARD SPECIFICATIONS FOR CONSTRUCTION DATED 2001, AS APPROVED BY THE FEDERAL HIGHWAY ADMINISTRATION ON JANUARY 4, 2001 FOR USE ON THIS PROJECT, INCLUDING ALL SUBSEQUENT REVISIONS AND SUCH REVISED SPECIFICATIONS AND SPECIAL PROVISIONS AS ARE INCORPORATED IN THESE PLANS.

94\078\structures\j07811t.dgn j07811t.i 05-FEB-2003

Metric
UNLESS NOTED OTHERWISE
STATIONS ARE IN KILOMETERS
ELEVATIONS ARE IN METERS
DIMENSIONS ARE IN MILLIMETERS

DIRECTOR OF PROJECT DEVELOPMENT	
APPROVED <i>[Signature]</i>	DATE 2/5/03
PROJECT MANAGER : R. R. WHITCOMB	
PROJECT NAME : BRATTLEBORO	
PROJECT NUMBER : BHF 2000 (17)	
SHEET 1 OF 71 SHEETS	