

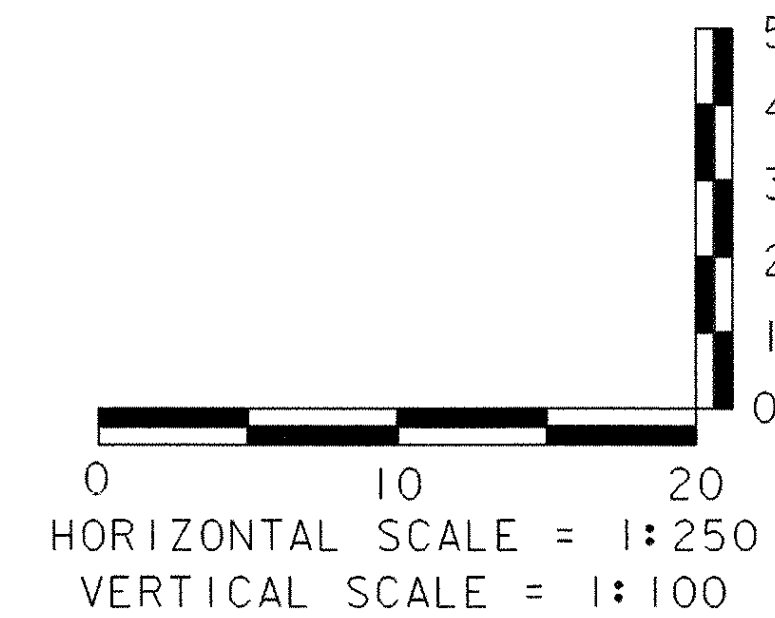
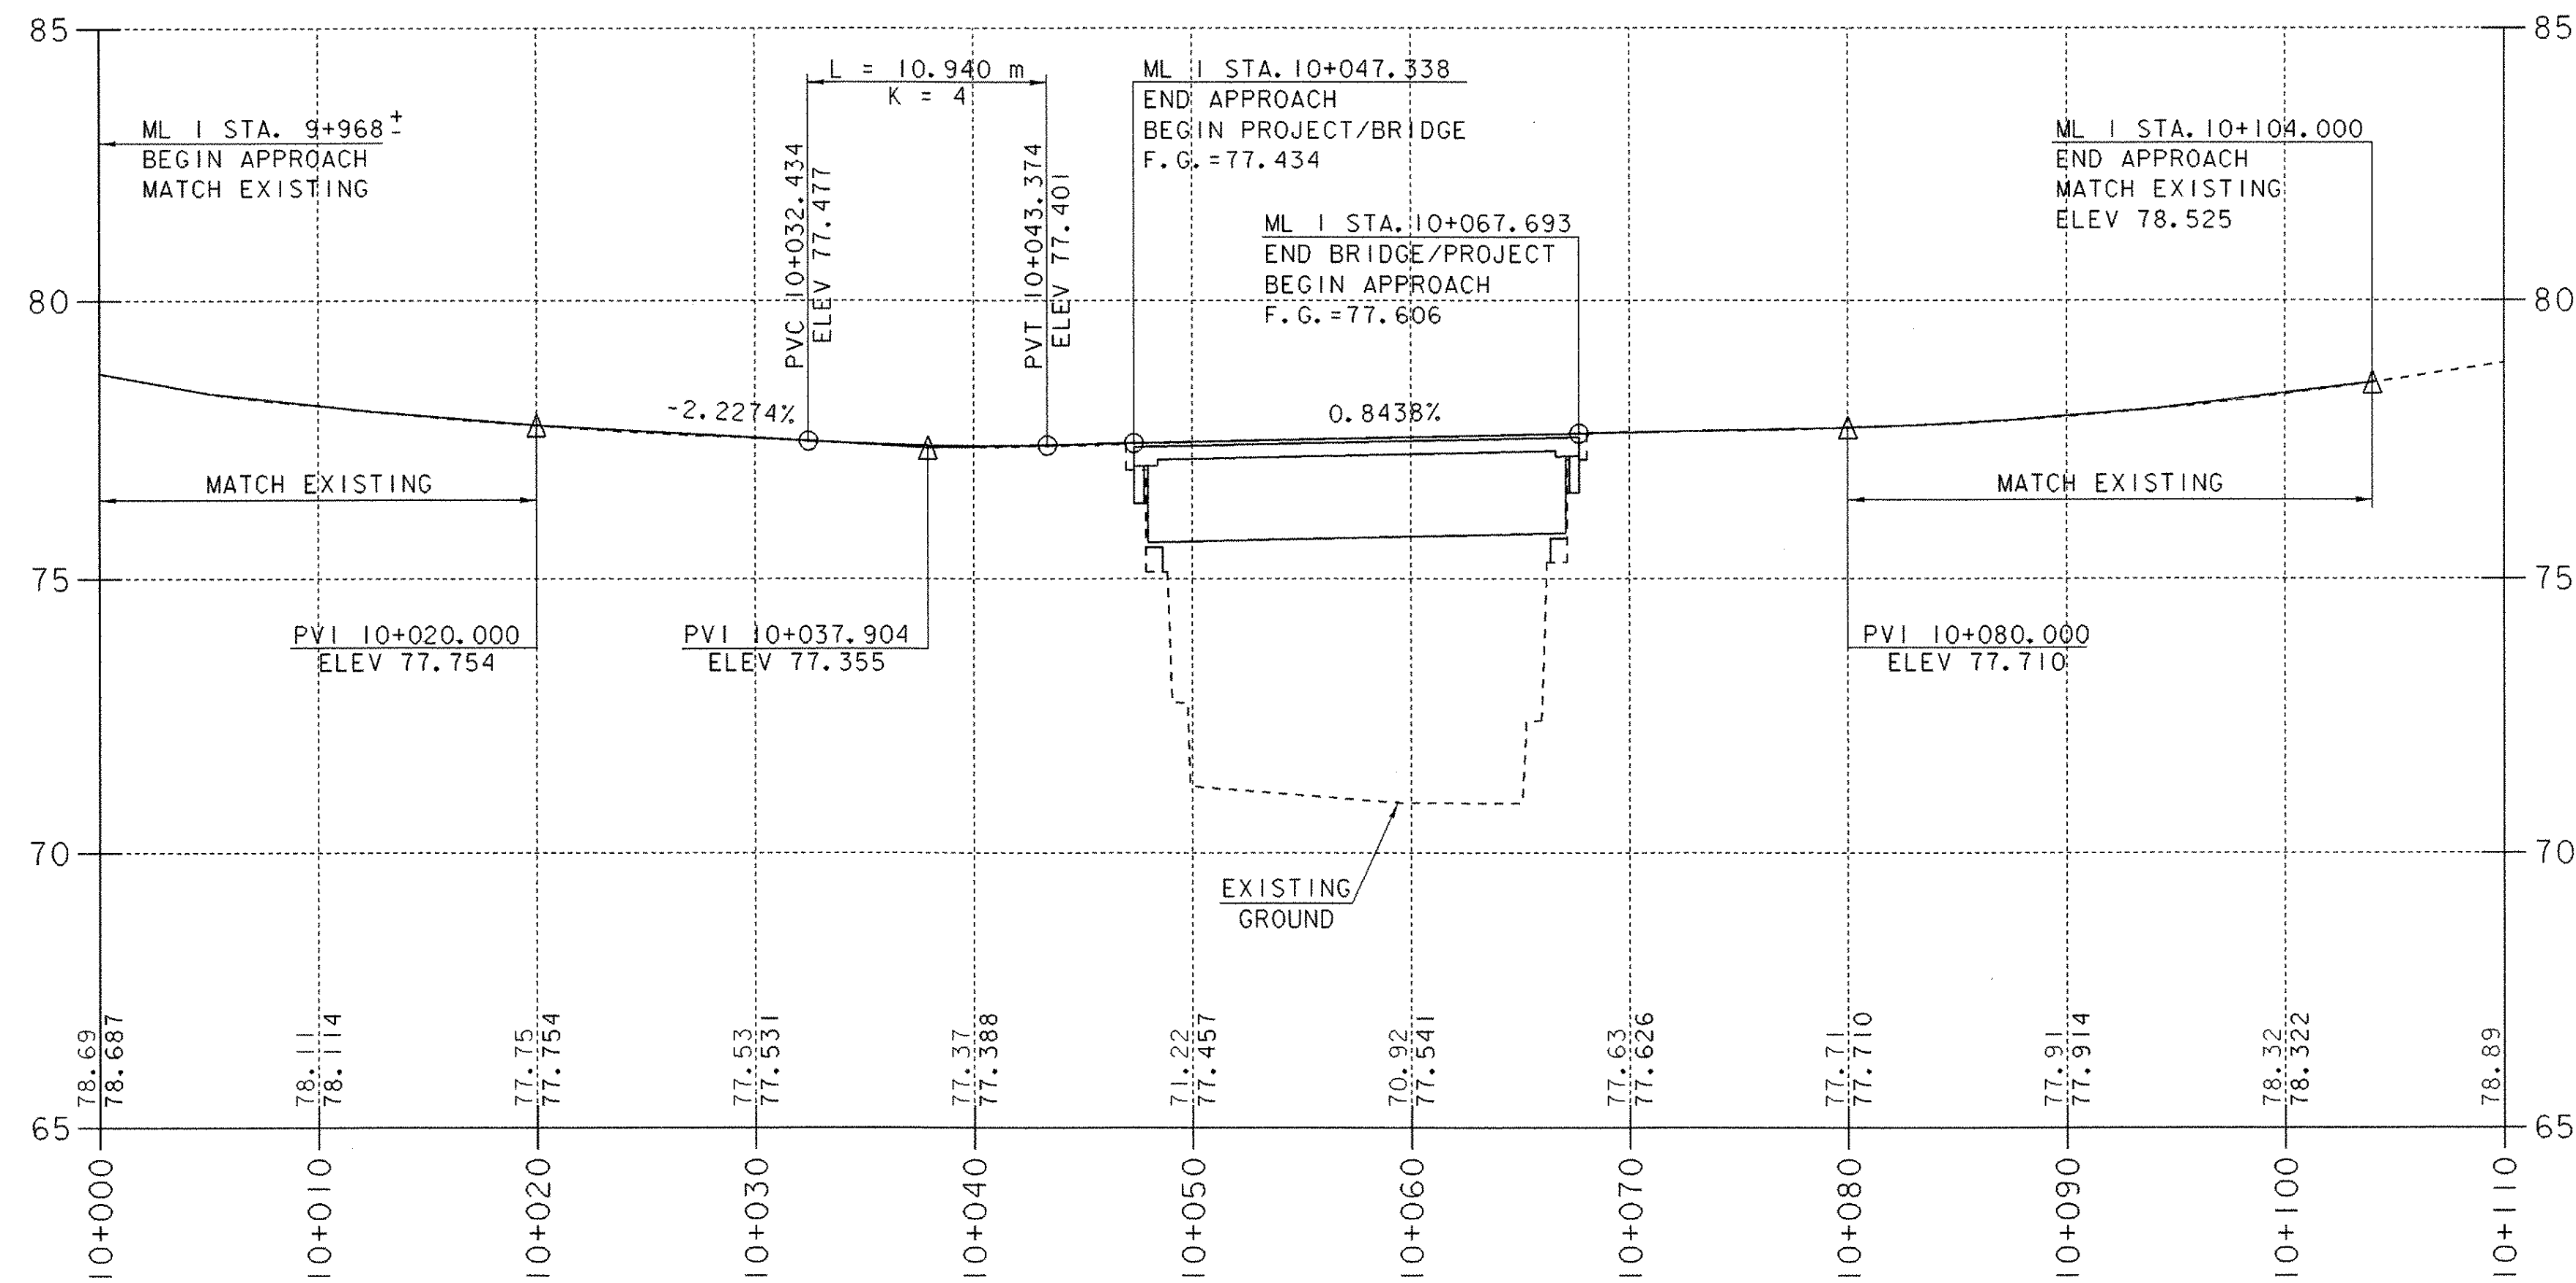


Profile Along Centerline Canal St. to Main St.

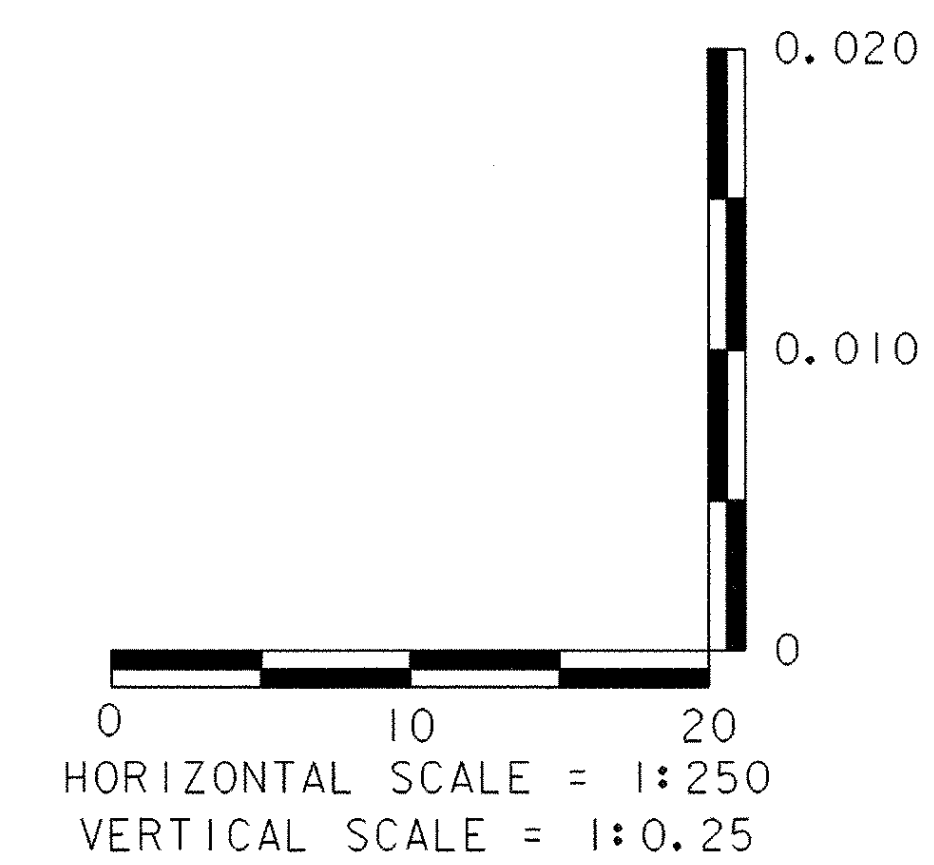

NOTE:
ELEVATIONS TO THE NEAREST HUNDREDTH ARE
EXISTING GROUND ALONG PROPOSED CENTERLINE.
ELEVATIONS TO THE NEAREST THOUSANDTH ARE
FINISH GRADE ALONG PROPOSED CENTERLINE.

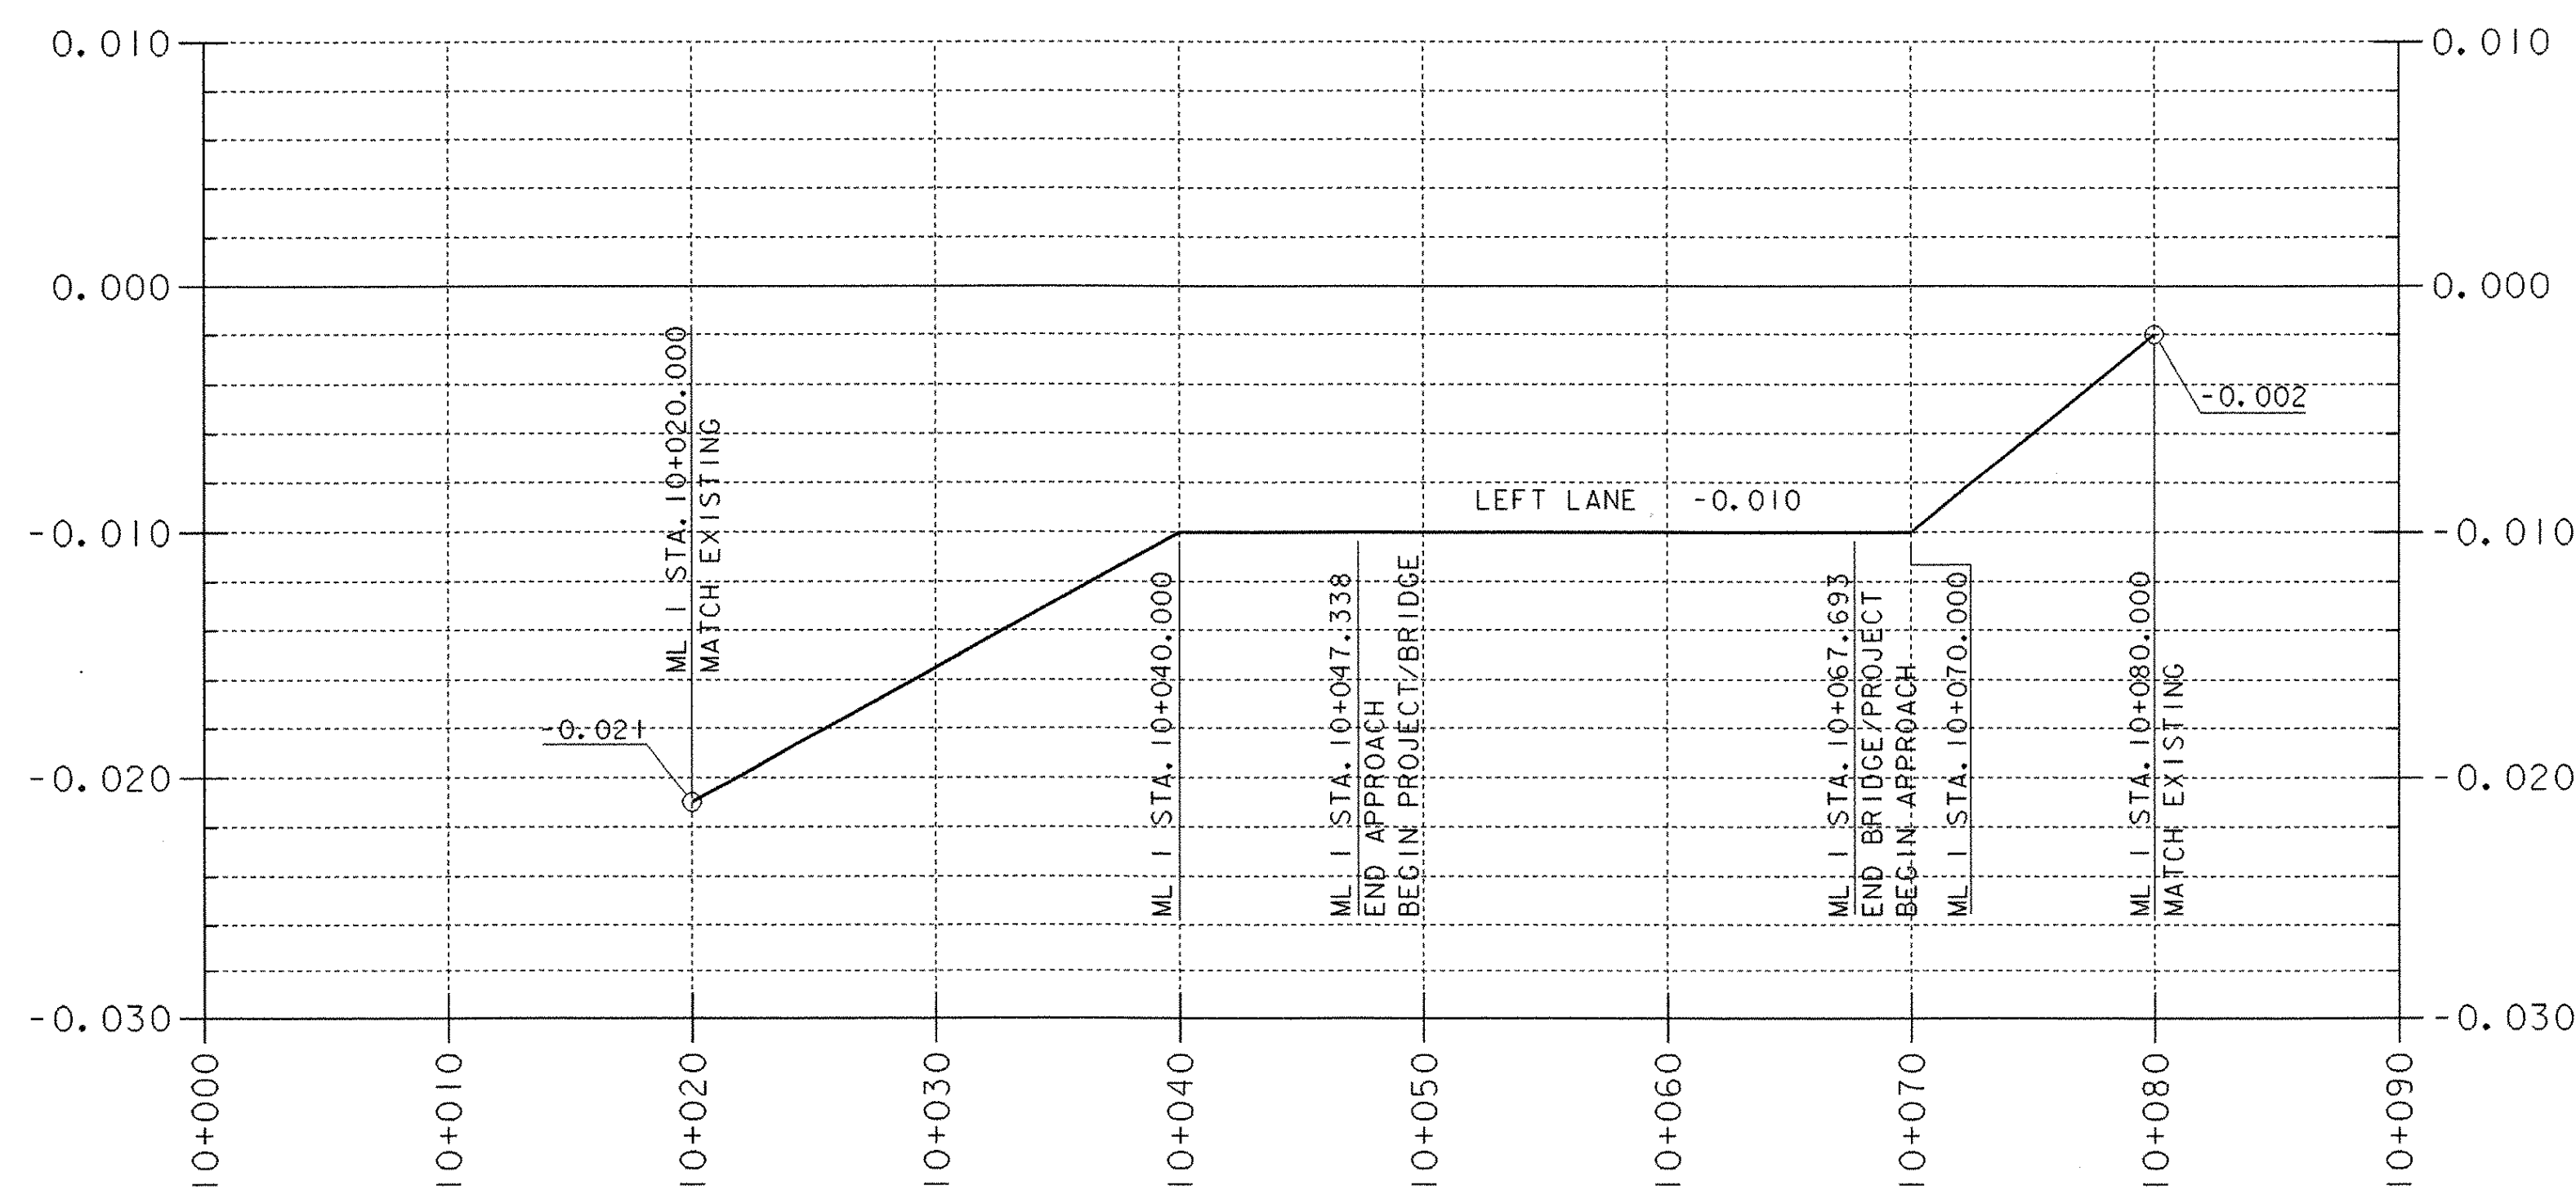

Banking Diagram For Left Travel Lane - Canal St. to Main St.

PROFILE & BANKING DIAGRAM (1)

PROJECT NAME:	BRATTLEBORO	PLLOT DATE:	06-FEB-2003
PROJECT NUMBER:	BHF 2000 (17)	DRAWN BY:	G. ROY
FILE NAME:	94j078\Structures\sj078pfl	CHECKED BY:	T. SUMNER
PROJECT MANAGER:	R. R. WHITCOMB	SHEET	10 OF 71
DESIGNED BY:	G. ROY		