



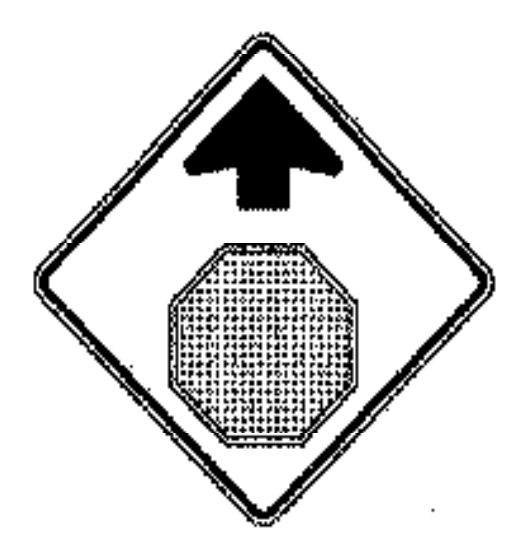

LEGEND

- SA = STOP AHEAD
- NLT = NO LEFT TURN
- DNE = DO NOT ENTER
- WW = WRONG WAY
- OWL = ONE WAY LEFT
- OWR = ONE WAY RIGHT
- S3W = STOP W/ 3-WAY PLAQUE
- S3WDR = STOP W/ 3-WAY PLAQUE/NORTH US 5 DETOUR RIGHT
- S3WDL = STOP W/ 3-WAY PLAQUE/NORTH US 5 DETOUR LEFT
- EDT = END DETOUR
- NSDL = NORTH US 5 DETOUR LEFT
- N5DR = NORTH US 5 DETOUR RIGHT
- N5D = NORTH US 5 DETOUR
- N5ED = NORTH US 5 END DETOUR
- S5DL = SOUTH US 5 DETOUR LEFT
- S5DR = SOUTH US 5 DETOUR RIGHT
- S5D = SOUTH US 5 DETOUR
- S5DL/S5DR = NORTH US 5 DETOUR LEFT/SOUTH US 5 DETOUR
- 5DL = US 5 DETOUR LEFT
- 5D = US 5 DETOUR
- DASN = DETOUR AHEAD NORTH US 5
- DASS = DETOUR AHEAD SOUTH US 5

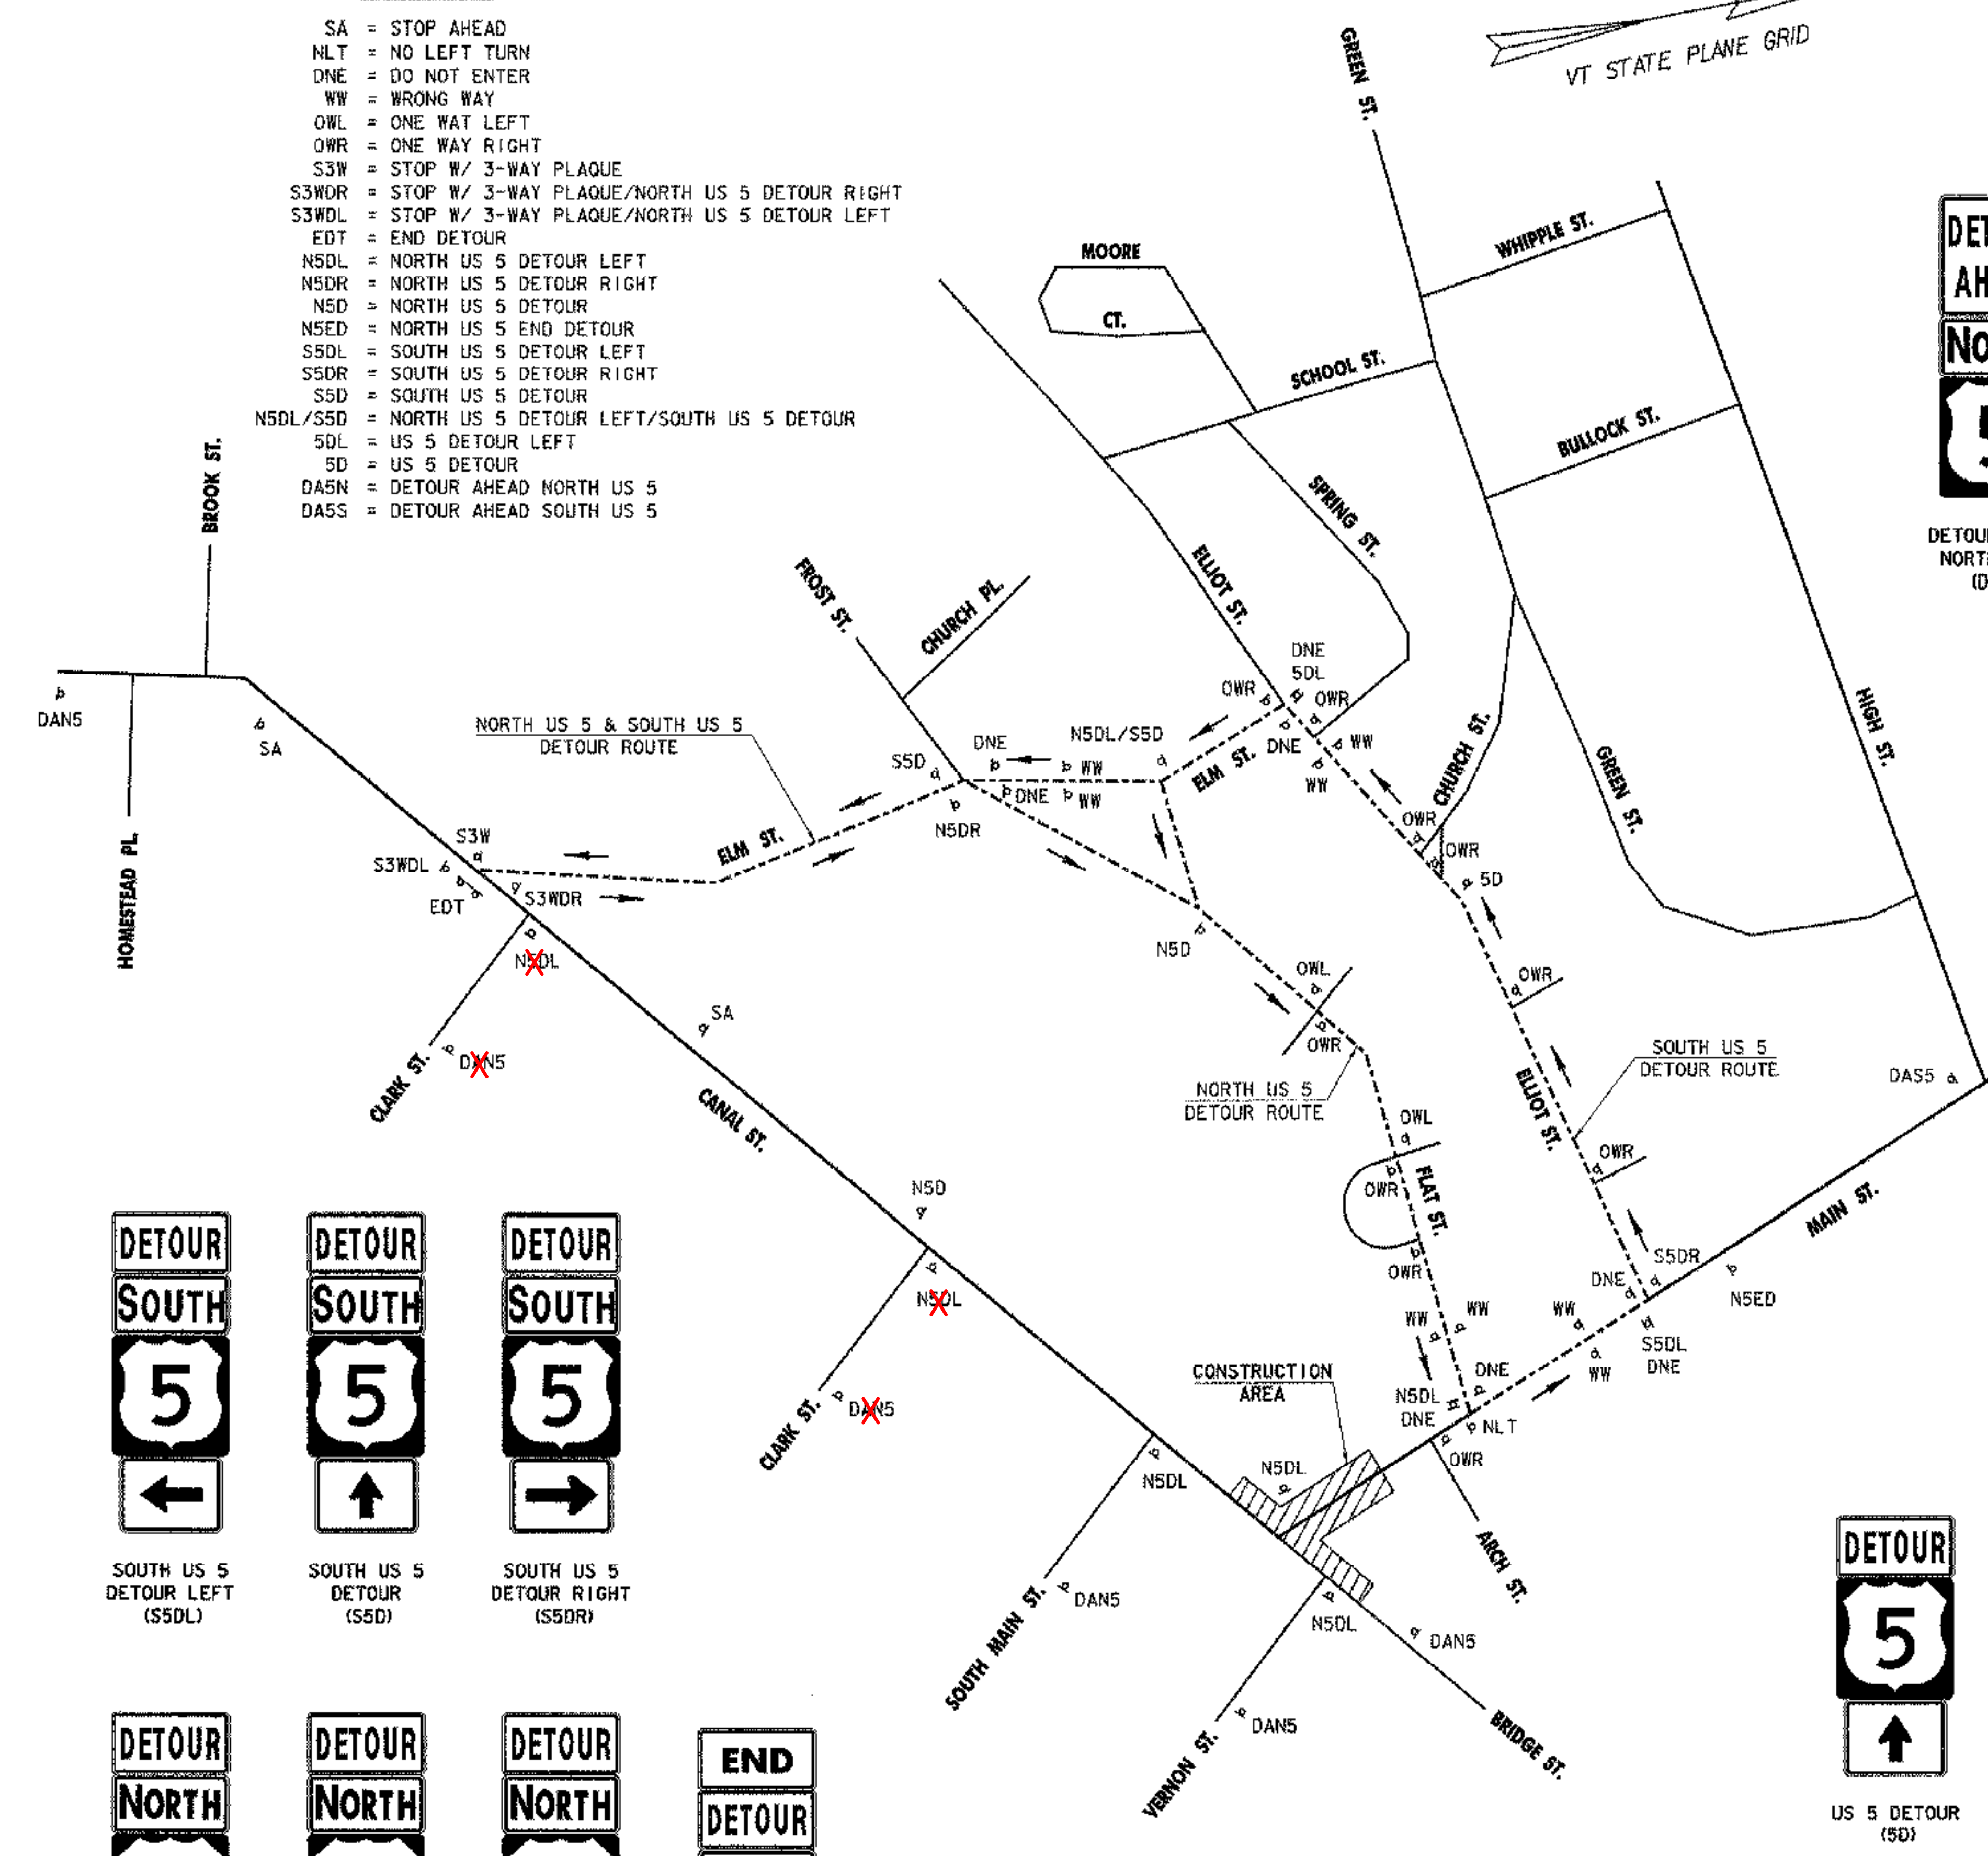

STOP AHEAD (SA)



NO LEFT TURN (NLT)



DO NOT ENTER (DNE)




WRONG WAY (WW)




ONE WAY LEFT (OWL)



ONE WAY RIGHT (OWR)

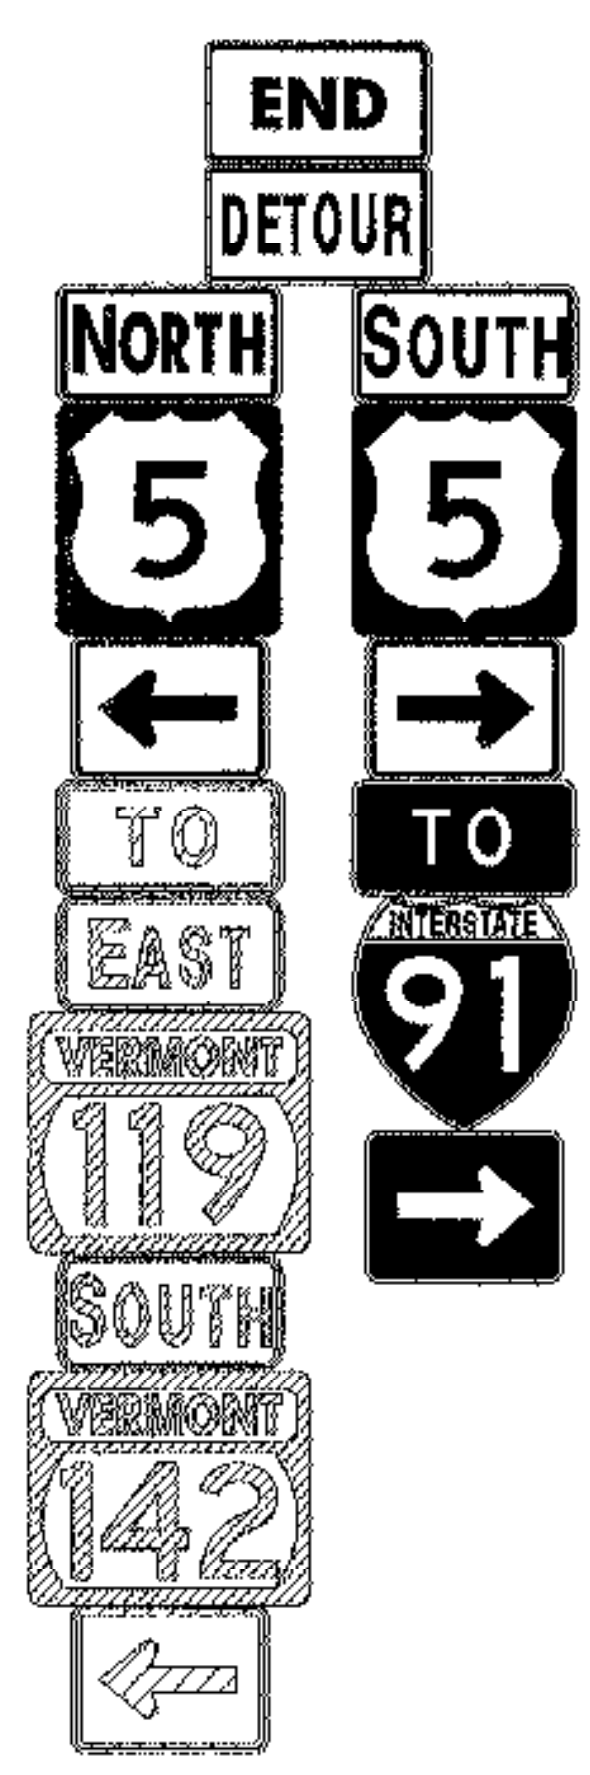

END DETOUR (EDT)

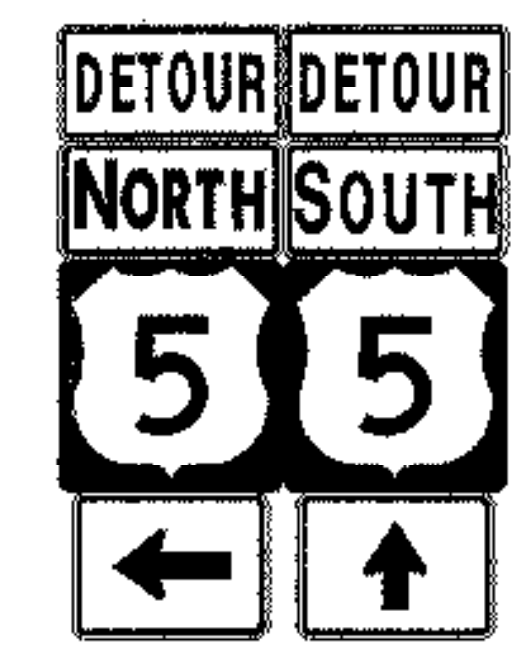

NORTH US 5 DETOUR LEFT SOUTH US 5 DETOUR (N5DL/S5DL)



SOUTH US 5 DETOUR LEFT (S5DL)



SOUTH US 5 DETOUR (S5D)



SOUTH US 5 DETOUR RIGHT (S5DR)



NORTH US 5 DETOUR LEFT (N5DL)



NORTH US 5 DETOUR (N5D)



NORTH US 5 DETOUR RIGHT (N5DR)



NORTH US 5 END DETOUR (N5ED)



DETOUR AHEAD NORTH US 5 (DANS)



DETOUR AHEAD SOUTH US 5 (DASS)



STOP W/ 3-WAY PLAQUE (S3W)



US 5 DETOUR (5D)



US 5 DETOUR LEFT (5DL)

DETOUR SIGNING

PROJECT NAME:	BRATTLEBORO		
PROJECT NUMBER:	BHF 2000 (17)		
FILE NAME:	94J078\Structures\sj078ds.1	PLOT DATE:	24-MAY-2004
PROJECT MANAGER:	R. R. WHITCOMB	DRAWN BY:	G. ROY
DESIGNED BY:	G. ROY	CHECKED BY:	T. SUMNER
		SHEET	16B OF 71

DATE	BY	REVISION
04/22/2003	VAQT	MODIFIED SIGNS FOR DETOUR DUE TO BRIDGE CLOSURE.