


**LEGEND**

- RWA = ROAD WORK AHEAD (SEE STD. E-100M)
- RW500 = ROAD WORK 500 FT (SEE STD. E-100M)
- ERW = END ROAD WORK (SEE STD. E-100M)
- SDR = US 5 DETOUR RIGHT (SEE DETAIL BELOW)
- ED = END DETOUR (SEE DETAIL BELOW)

△-△ SEE CONSTRUCTION SIGN DETAIL (3)

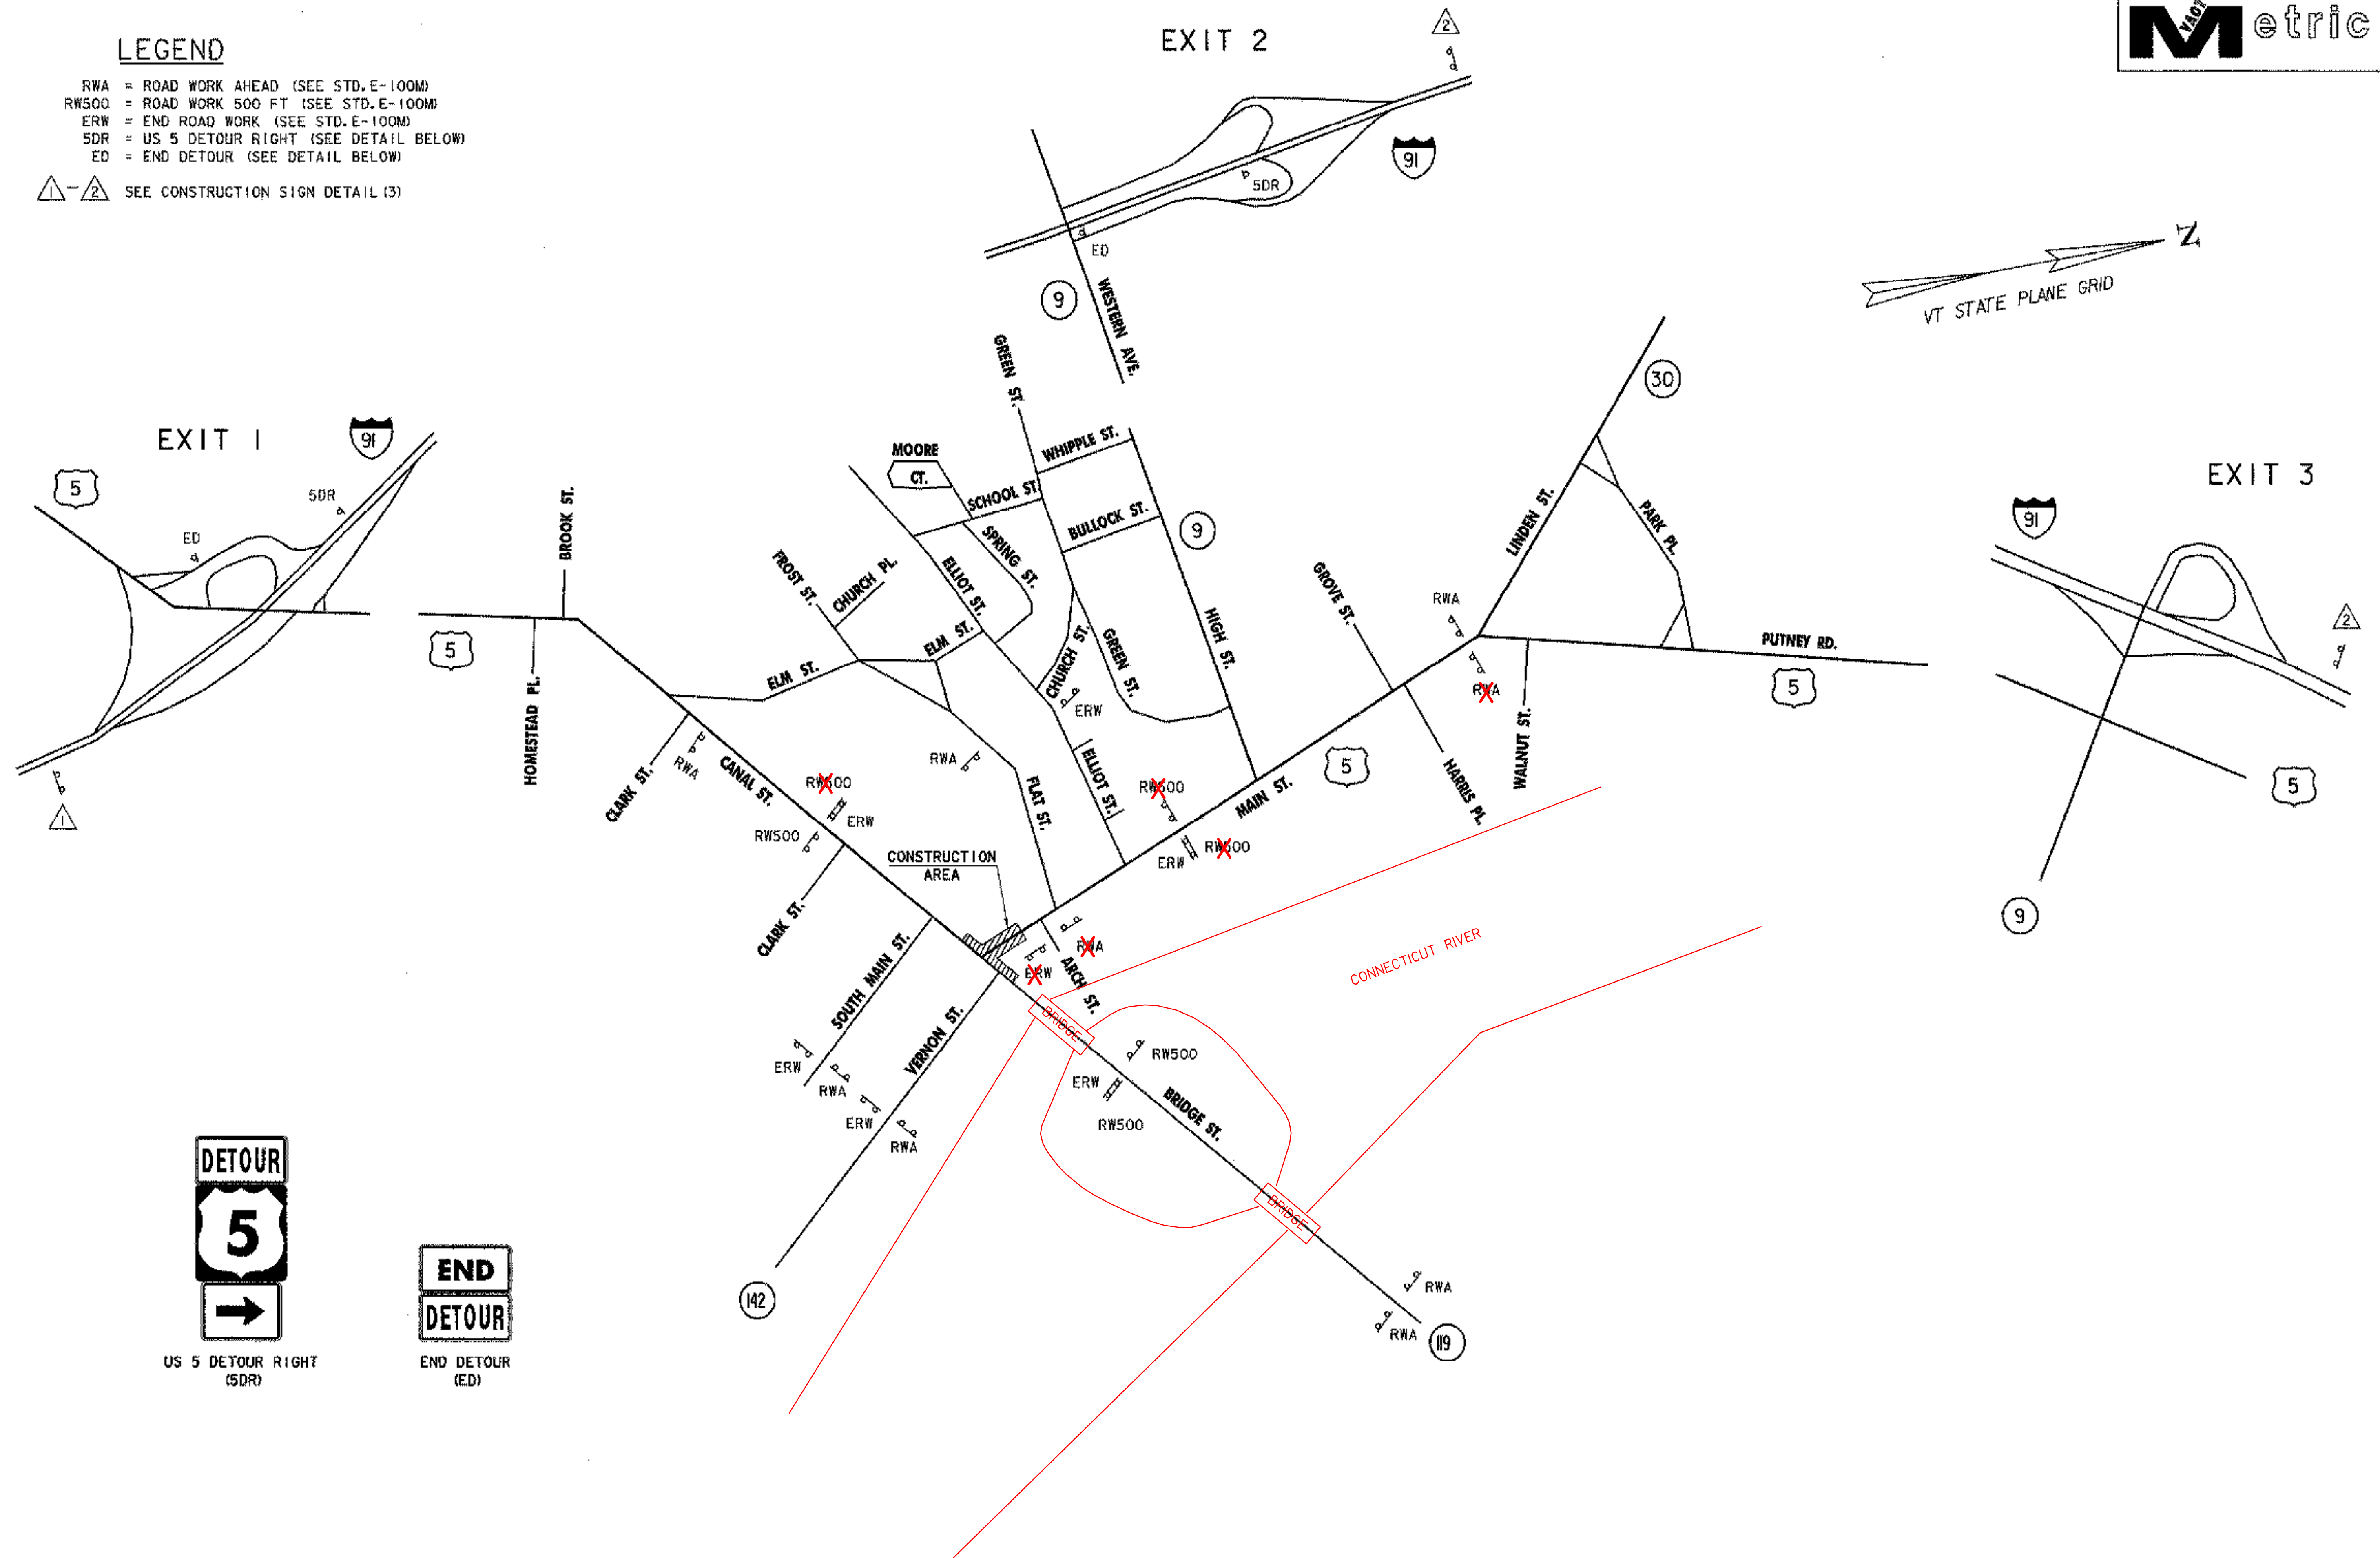

US 5 DETOUR RIGHT (SDR)



END DETOUR (ED)

**CONSTRUCTION APPROACH SIGNING**

PROJECT NAME: BRATTLEBORO  
 PROJECT NUMBER: BHF 2000 (17)

DATE	BY	REVISION
04/22/2003	VAOT	MODIFIED SIGNS FOR DETOUR DUE TO BRIDGE CLOSURE.

FILE NAME: 94J078\Structures\94J078cas.1 PLOT DATE: 24-MAY-2004  
 PROJECT MANAGER: R. R. WHITCOMB DRAWN BY: G. ROY  
 DESIGNED BY: G. ROY CHECKED BY: T. SUMNER  
 SHEET 16A OF 71