



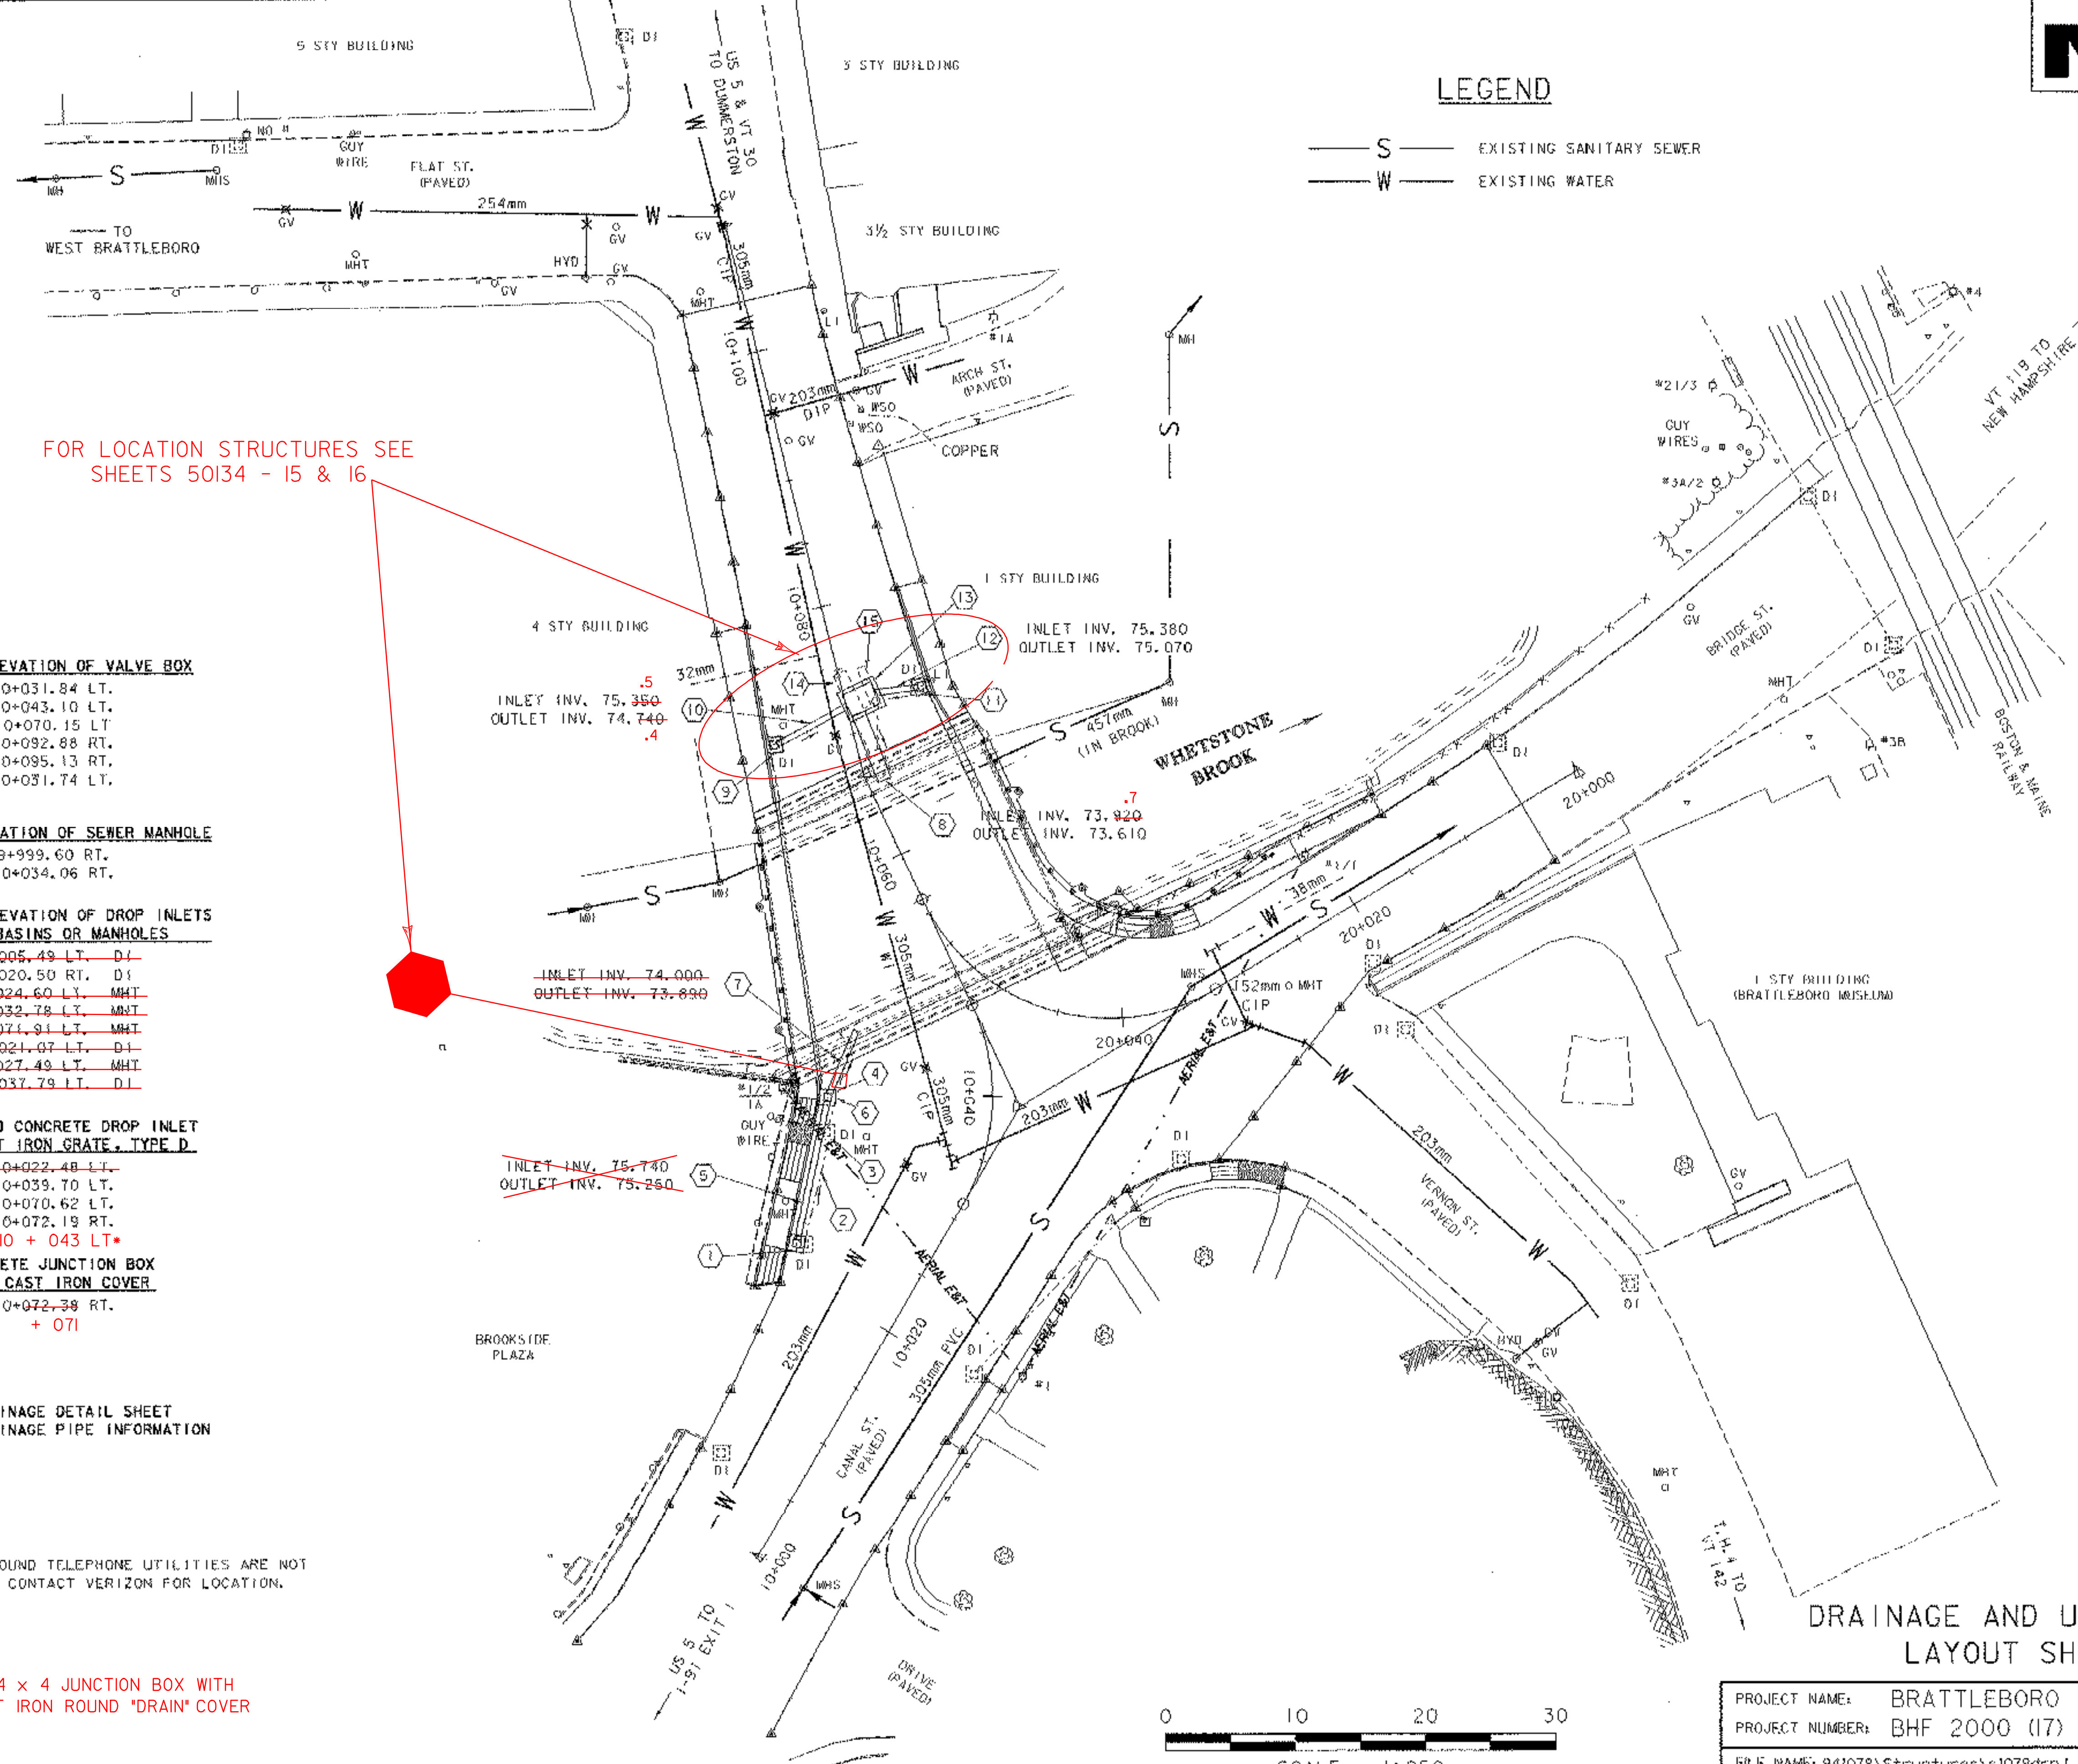

LEGEND

- S — EXISTING SANITARY SEWER
- W — EXISTING WATER

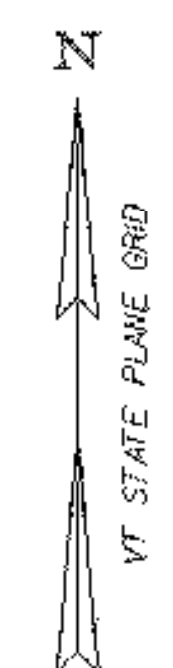

FOR LOCATION STRUCTURES SEE SHEETS 50134 - 15 & 16

**ADJUST ELEVATION OF VALVE BOX**  
 10+031.84 LT.  
 10+043.10 LT.  
 10+070.15 LT.  
 10+092.88 RT.  
 10+095.13 RT.  
 20+031.74 LT.

**CHANGE ELEVATION OF SEWER MANHOLE**  
 9+999.60 RT.  
 20+034.06 RT.

**CHANGING ELEVATION OF DROP INLETS CATCH BASINS OR MANHOLES**  
~~10+005.49 LT. D1~~  
~~10+020.50 RT. D1~~  
~~10+024.60 LT. MHT~~  
~~10+032.78 LT. MHT~~  
~~10+071.91 LT. MHT~~  
~~20+021.07 LT. D1~~  
~~20+027.49 LT. MHT~~  
~~20+037.79 LT. D1~~


**REINFORCED CONCRETE DROP INLET WITH CAST IRON GRATE, TYPE D**  
~~10+022.48 LT.~~  
 10+039.70 LT.  
 10+070.62 LT.  
 10+072.19 RT.  
 10 + 043 LT\*

**CONCRETE JUNCTION BOX WITH CAST IRON COVER**  
 10+072.39 RT.  
 + 071

SEE DRAINAGE DETAIL SHEET FOR DRAINAGE PIPE INFORMATION

NOTE:  
 UNDERGROUND TELEPHONE UTILITIES ARE NOT SHOWN. CONTACT VERIZON FOR LOCATION.

\* 4 x 4 JUNCTION BOX WITH CAST IRON ROUND 'DRAIN' COVER

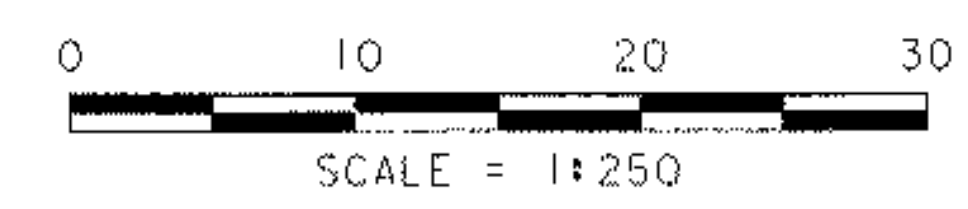

DRAINAGE AND UTILITIES LAYOUT SHEET

PROJECT NAME:	BRATTLEBORO	FILE NAME:	94\078\structures\5\078drn.d	PLOT DATE:	06-FEB-2003
PROJECT NUMBER:	BHF 2000 (17)	PROJECT MANAGER:	R. R. WHITCOMB	DRAWN BY:	G. ROY
		DESIGNED BY:	G. ROY	CHECKED BY:	T. SUMNER
				SHEET	28 OF 71