



NOTE:


CONCRETE CAP SHALL BE PLACED OVER ENTIRE WIDTH OF LAID-UP STONE WALL AS DETERMINED IN THE FIELD AND A MINIMUM OF 2000 AS SHOWN.

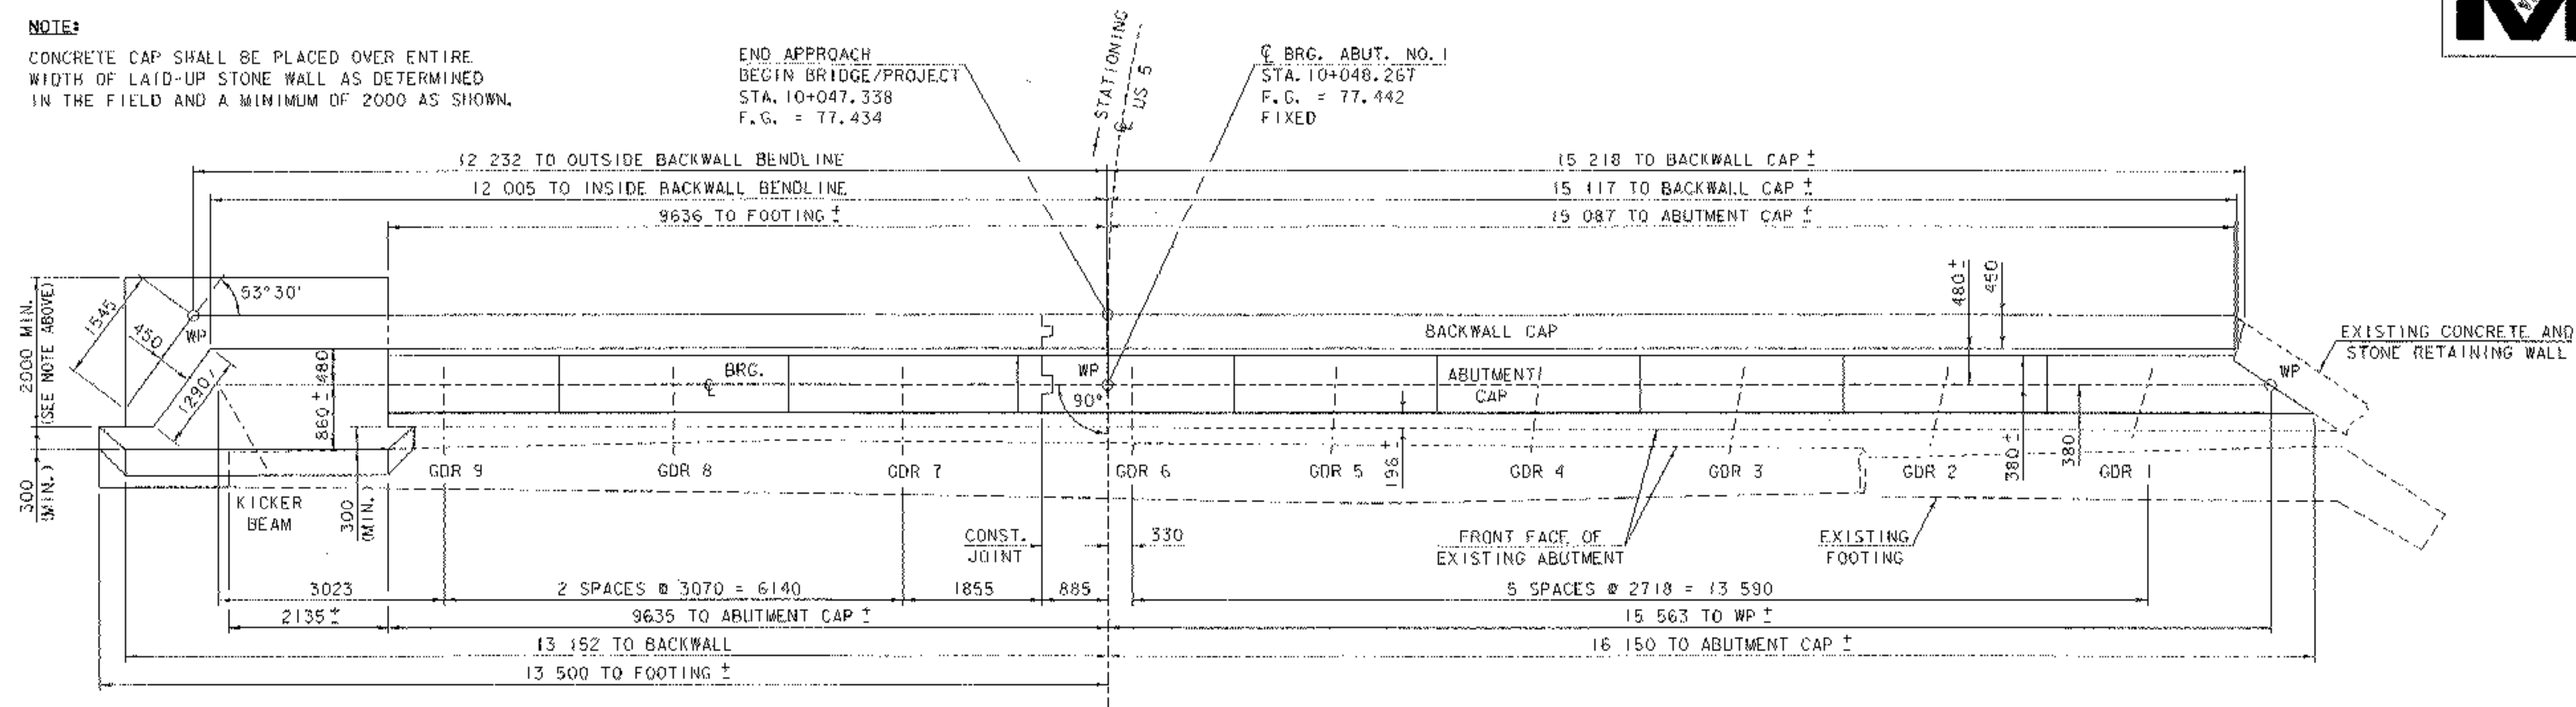


ABUTMENT NO. 1 PLAN

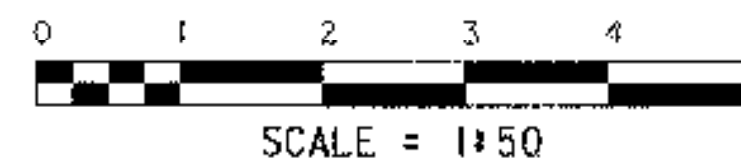

- * THESE ELEVATIONS ARE TO BE DETERMINED IN THE FIELD AFTER THE STRUCTURAL STEEL HAS BEEN ERECTED.
- ** THESE ARE APPROXIMATE LOCATIONS. ACTUAL LOCATIONS WILL BE DEPENDENT ON FIELD CONDITIONS.
- *** FILL VOIDS AROUND PIPE TO A DEPTH OF 300mm INTO ABUTMENT WITH CONCRETE, HIGH PERFORMANCE CLASS B OR MORTAR, TYPE IV.
- PUT NO PIPE THRU ABUTMENT, BUILT 4' x 4' JCT. BOX @ BACK OF ABUTMENT THAT OUTLETED THRU EXISTING HOLE

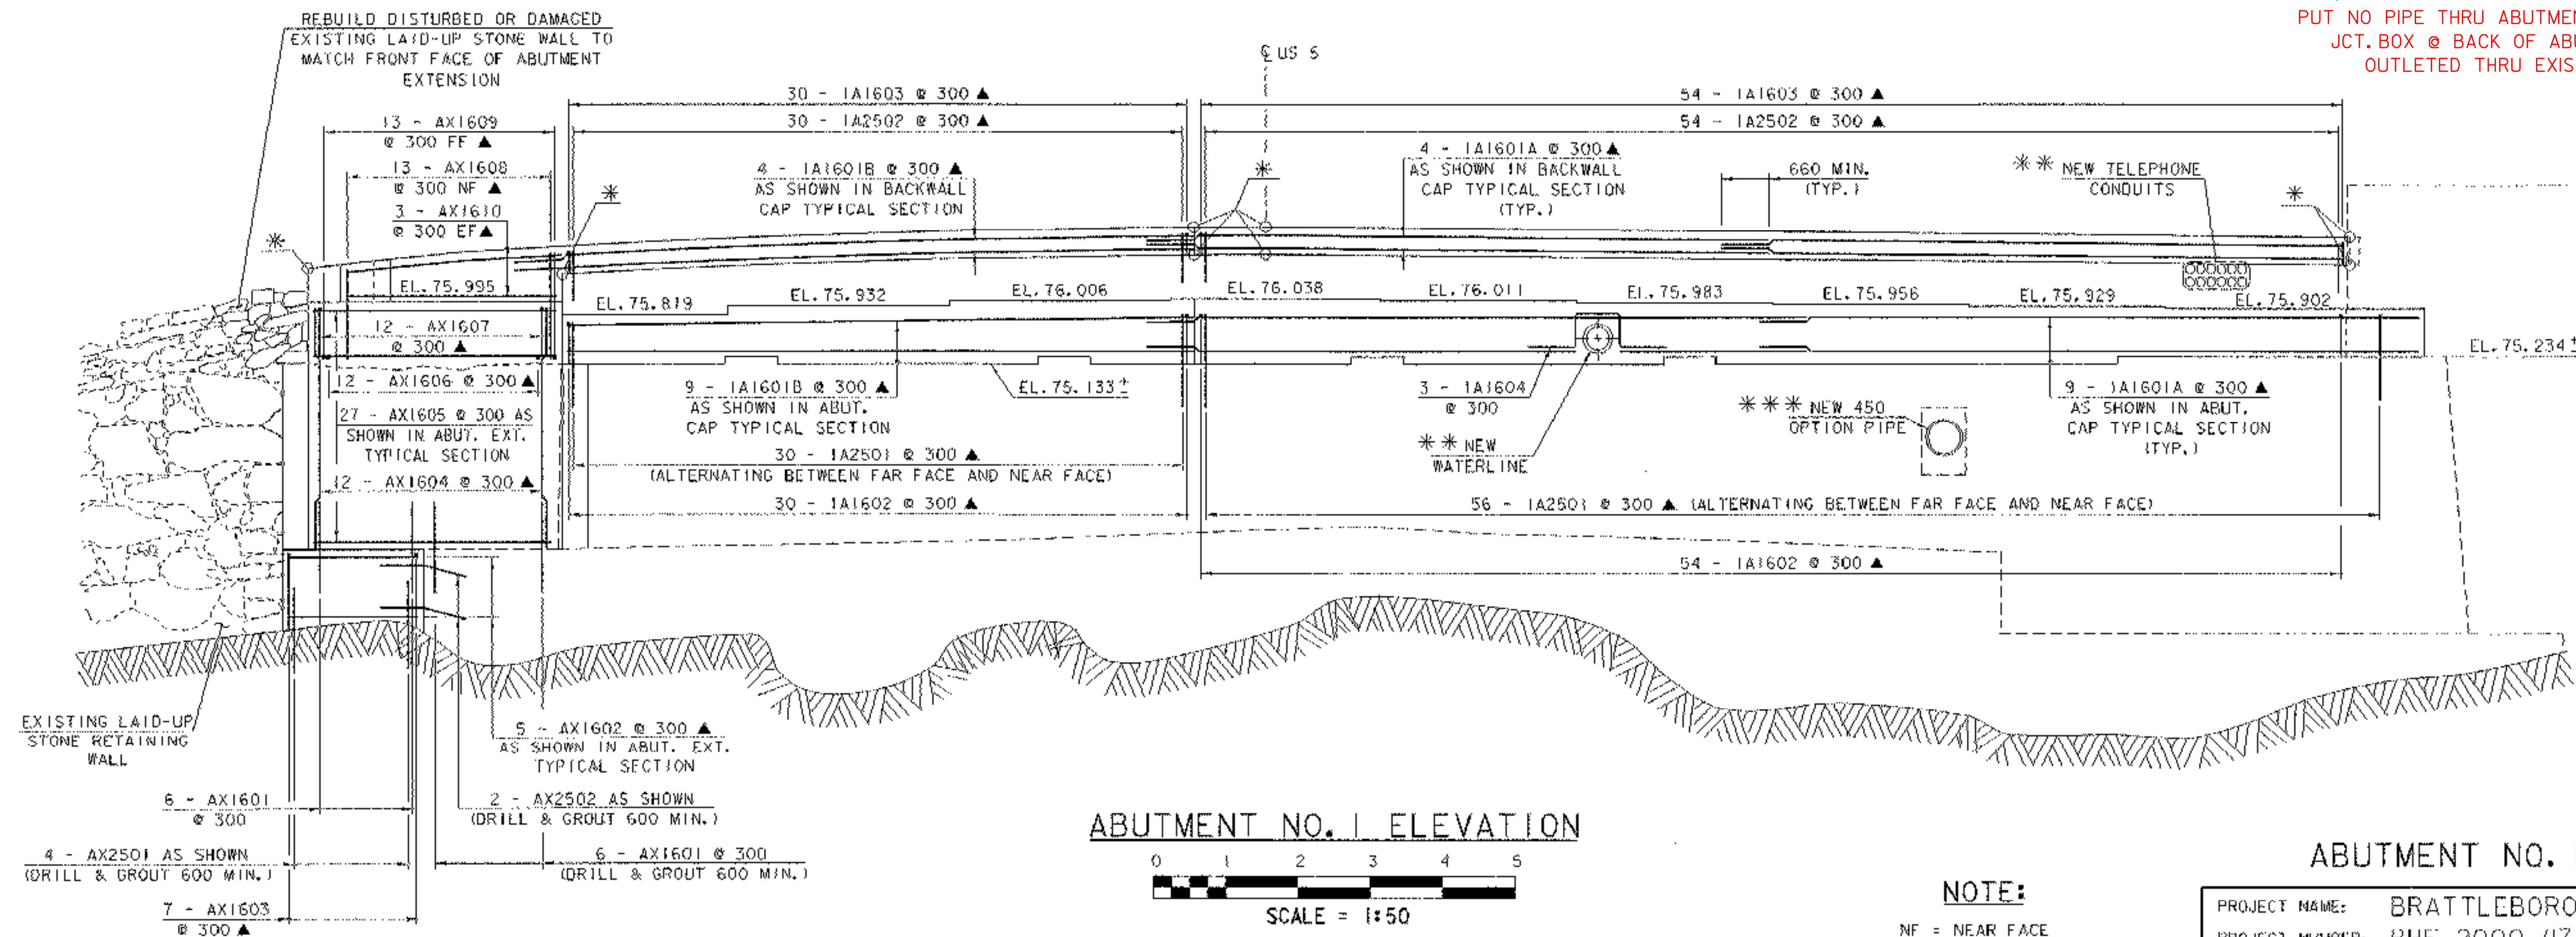

ABUTMENT NO. 1 ELEVATION

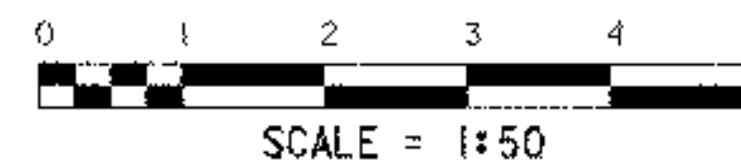

NOTE:

- NF = NEAR FACE
- FF = FAR FACE
- EF = EACH FACE
- ▲ = CUT TO FIT IN FIELD
- 75 CLR. UNLESS OTHERWISE SPECIFIED ON THE PLANS.

ABUTMENT NO. 1 DETAILS

PROJECT NAME:	BRATTLEBORO	PLOT DATE:	06-FEB-2003
PROJECT NUMBER:	BHF 2000 (17)	DRAWN BY:	S. SCRIBNER
FILE NAME:	947078\Structures\947078ab1	CHECKED BY:	T. SUMNER
PROJECT MANAGER:	R.R. WHITCOMB	SHEET	52 OF 71
DESIGNED BY:	T. SUMNER		