

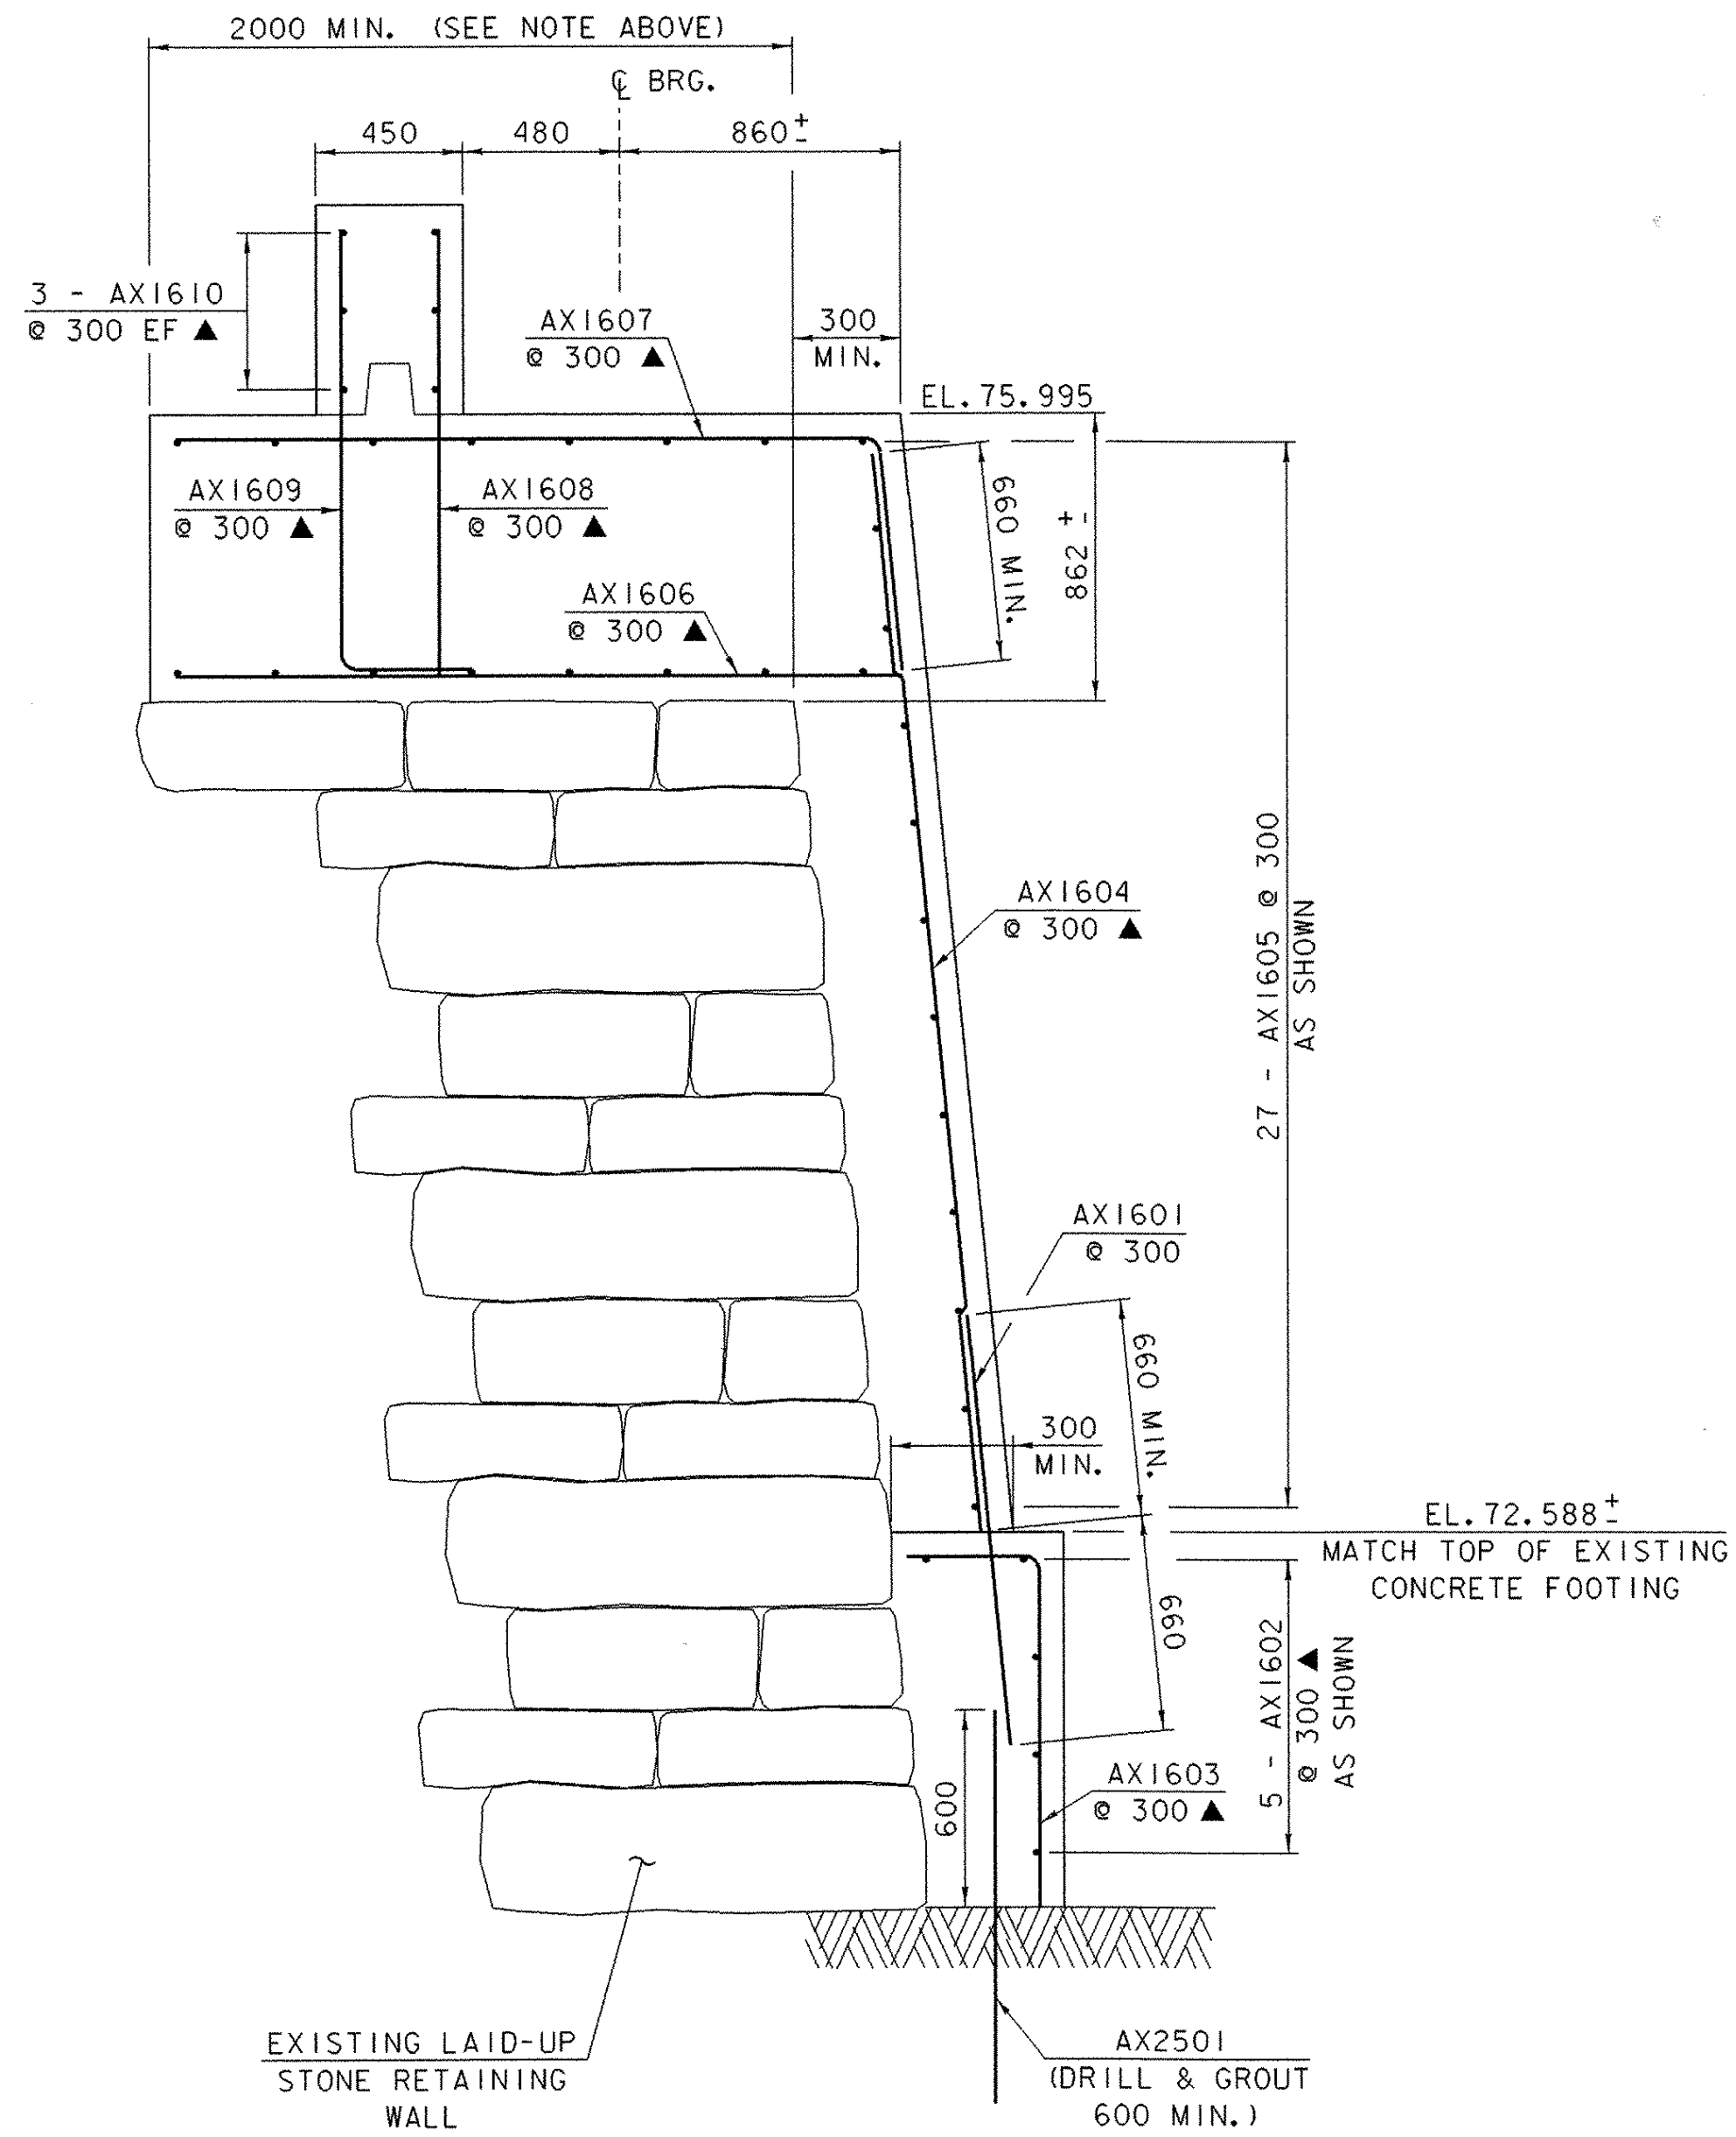


NOTE:


CONCRETE CAP SHALL BE PLACED OVER ENTIRE WIDTH OF LAID-UP STONE WALL AS DETERMINED IN THE FIELD AND A MINIMUM OF 2000 AS SHOWN.

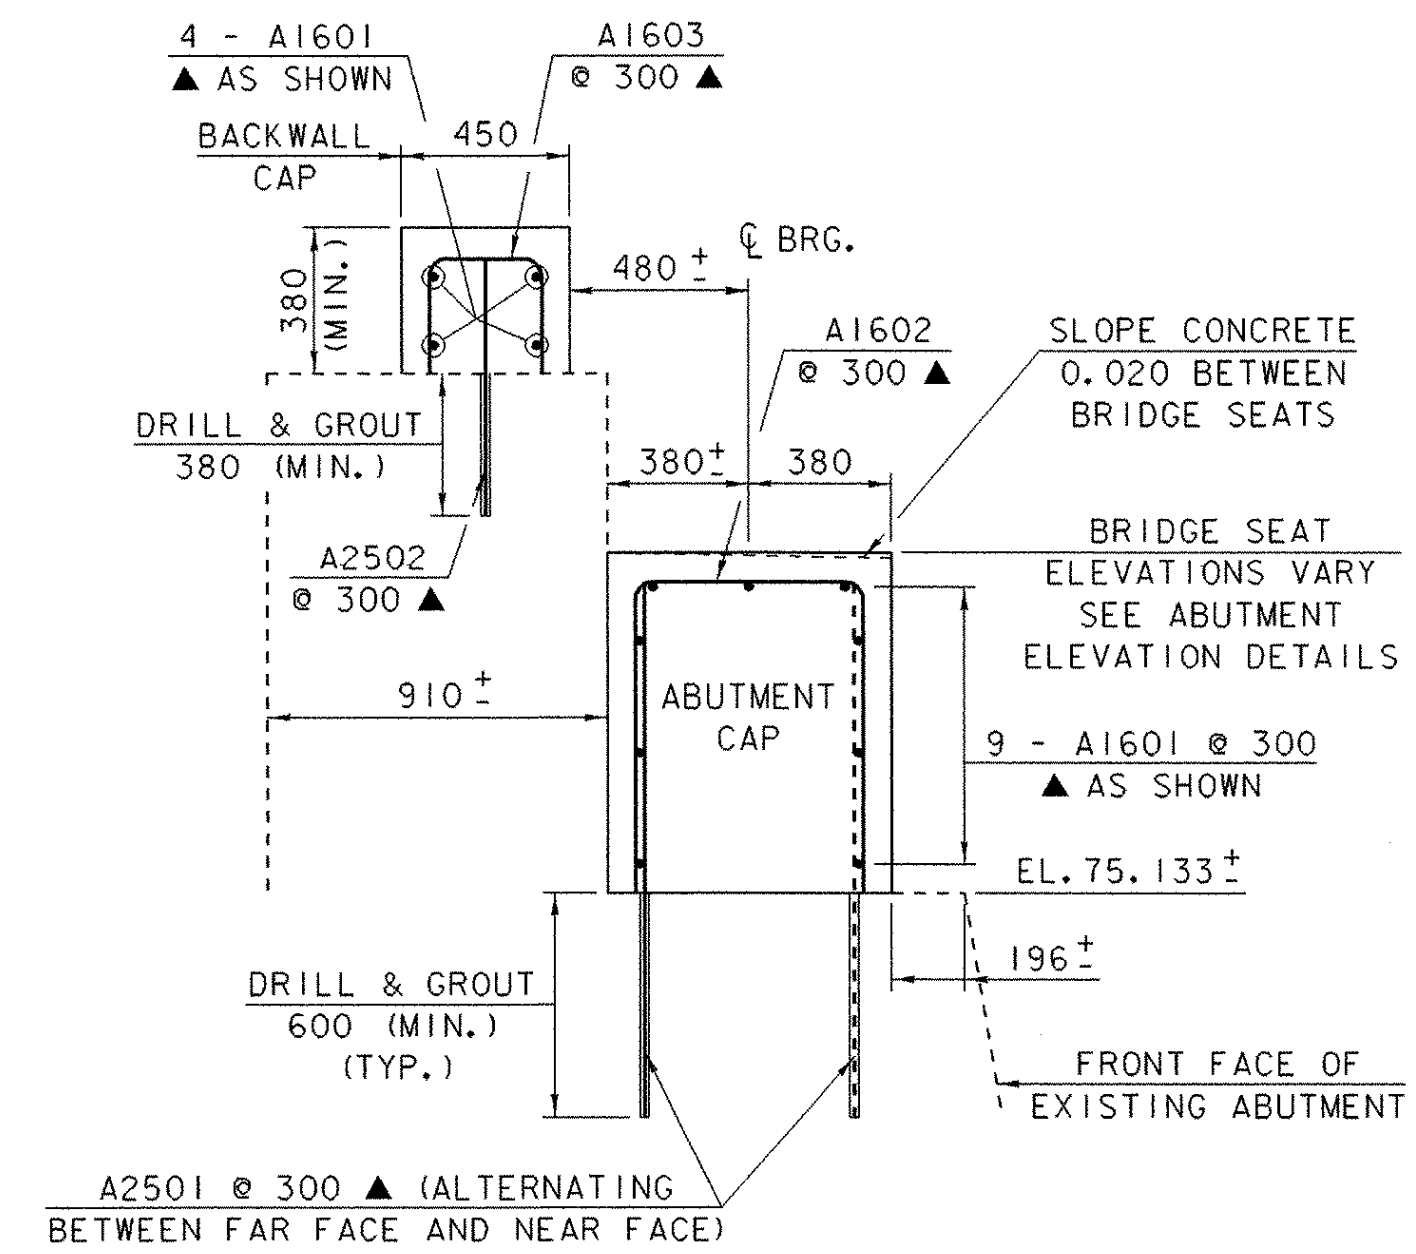

ABUTMENT EXTENSION TYPICAL SECTION

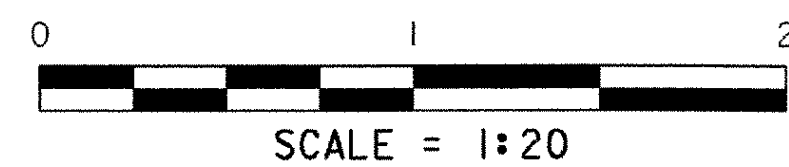

ABUTMENT CAP AND BACKWALL CAP TYPICAL SECTION

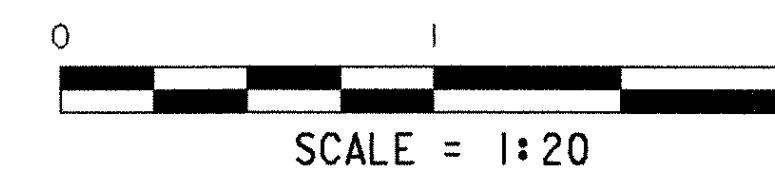

NOTE:

NF = NEAR FACE
 FF = FAR FACE
 EF = EACH FACE
 ▲ = CUT TO FIT IN FIELD
 75 CLR. UNLESS OTHERWISE SPECIFIED ON THE PLANS.

ABUTMENT TYPICAL SECTIONS

PROJECT NAME:	BRATTLEBORO
PROJECT NUMBER:	BHF 2000 (17)
FILE NAME:	94J078\Structures\sj078abt.1
PROJECT MANAGER:	R. R. WHITCOMB
DESIGNED BY:	T. SUMNER
PLOT DATE:	06-FEB-2003
DRAWN BY:	S. SCRIBNER
CHECKED BY:	T. SUMNER
SHEET	54 OF 71