



SECTION A-A

75.30 = BOTTOM H2O LINE @ IO+073 & @ 0.45 LT. CL

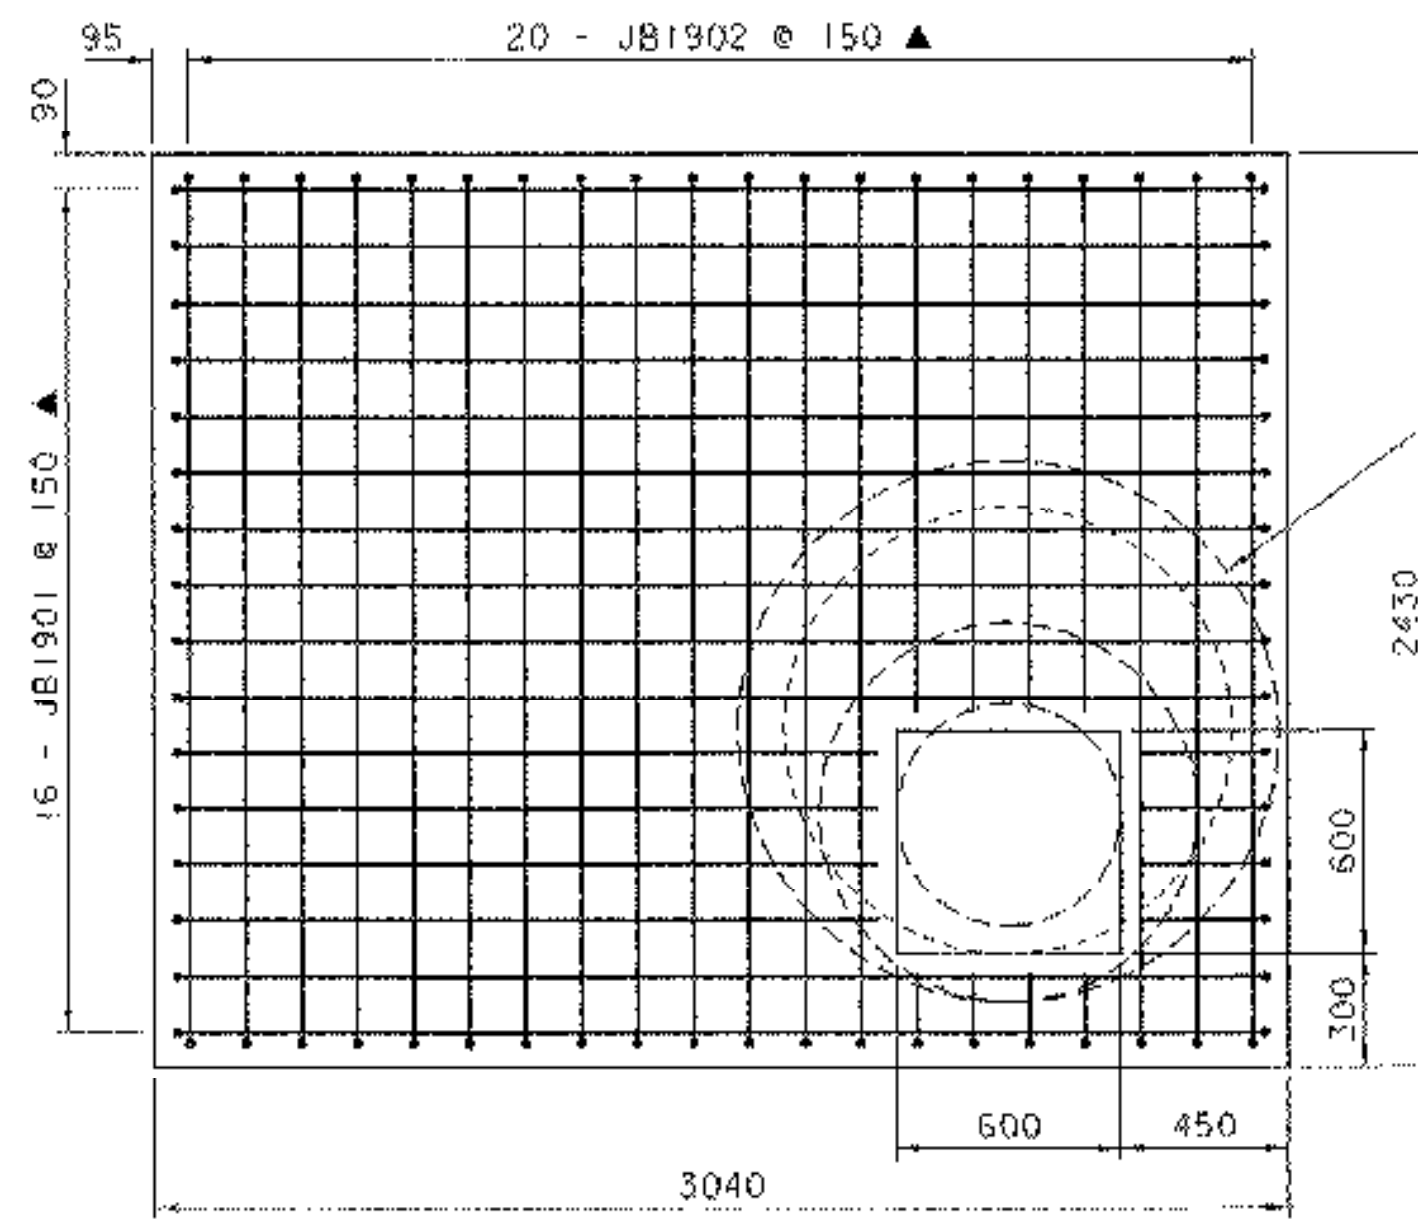

PLAN VIEW OF ADAPTER TOP

LOCATED IN SW CORNER OF JCT BOX, NOT SE OUTLINE OF PRECAST REINFORCED CONCRETE MANHOLE

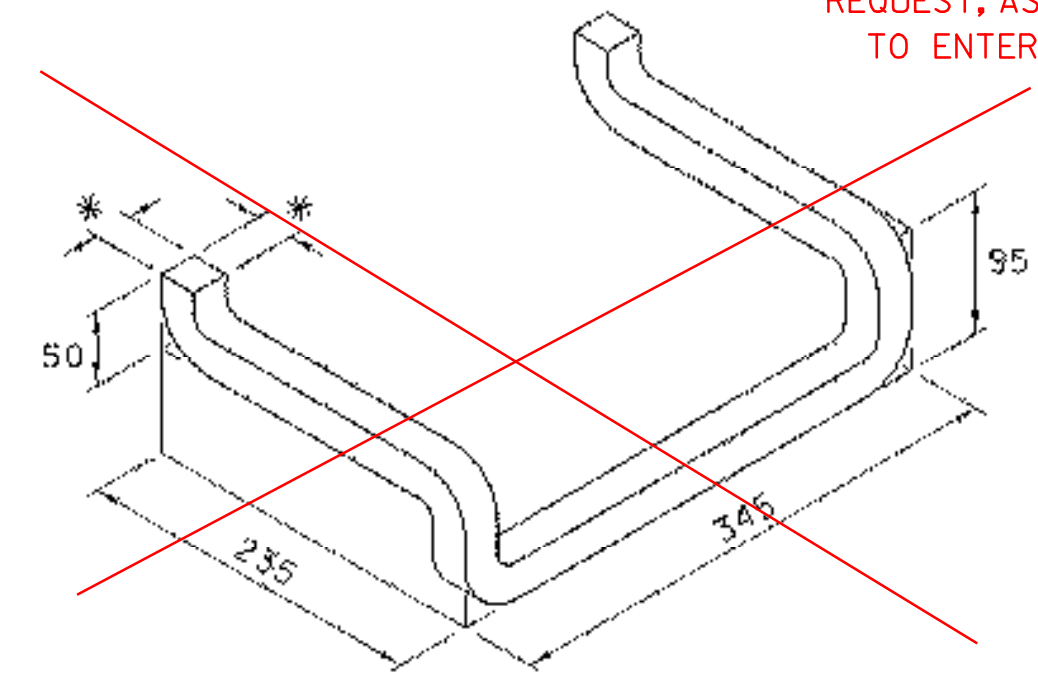


ALUMINUM STEP-DROP FRONT


(NOT TO SCALE)

\* - INDIVIDUAL METAL RINGS SHALL BE A MINIMUM DIMENSION OF 25mm AND SHALL BE PAINTED OR OTHERWISE TREATED TO RESIST CORROSION AND RUSTING.


STEPS REMOVED AS PER PUBLIC WORKS SUPT. STEVE BARRETT'S REQUEST, AS MUST USE A LADDER TO ENTER 'ENCLOSED SPACE'.

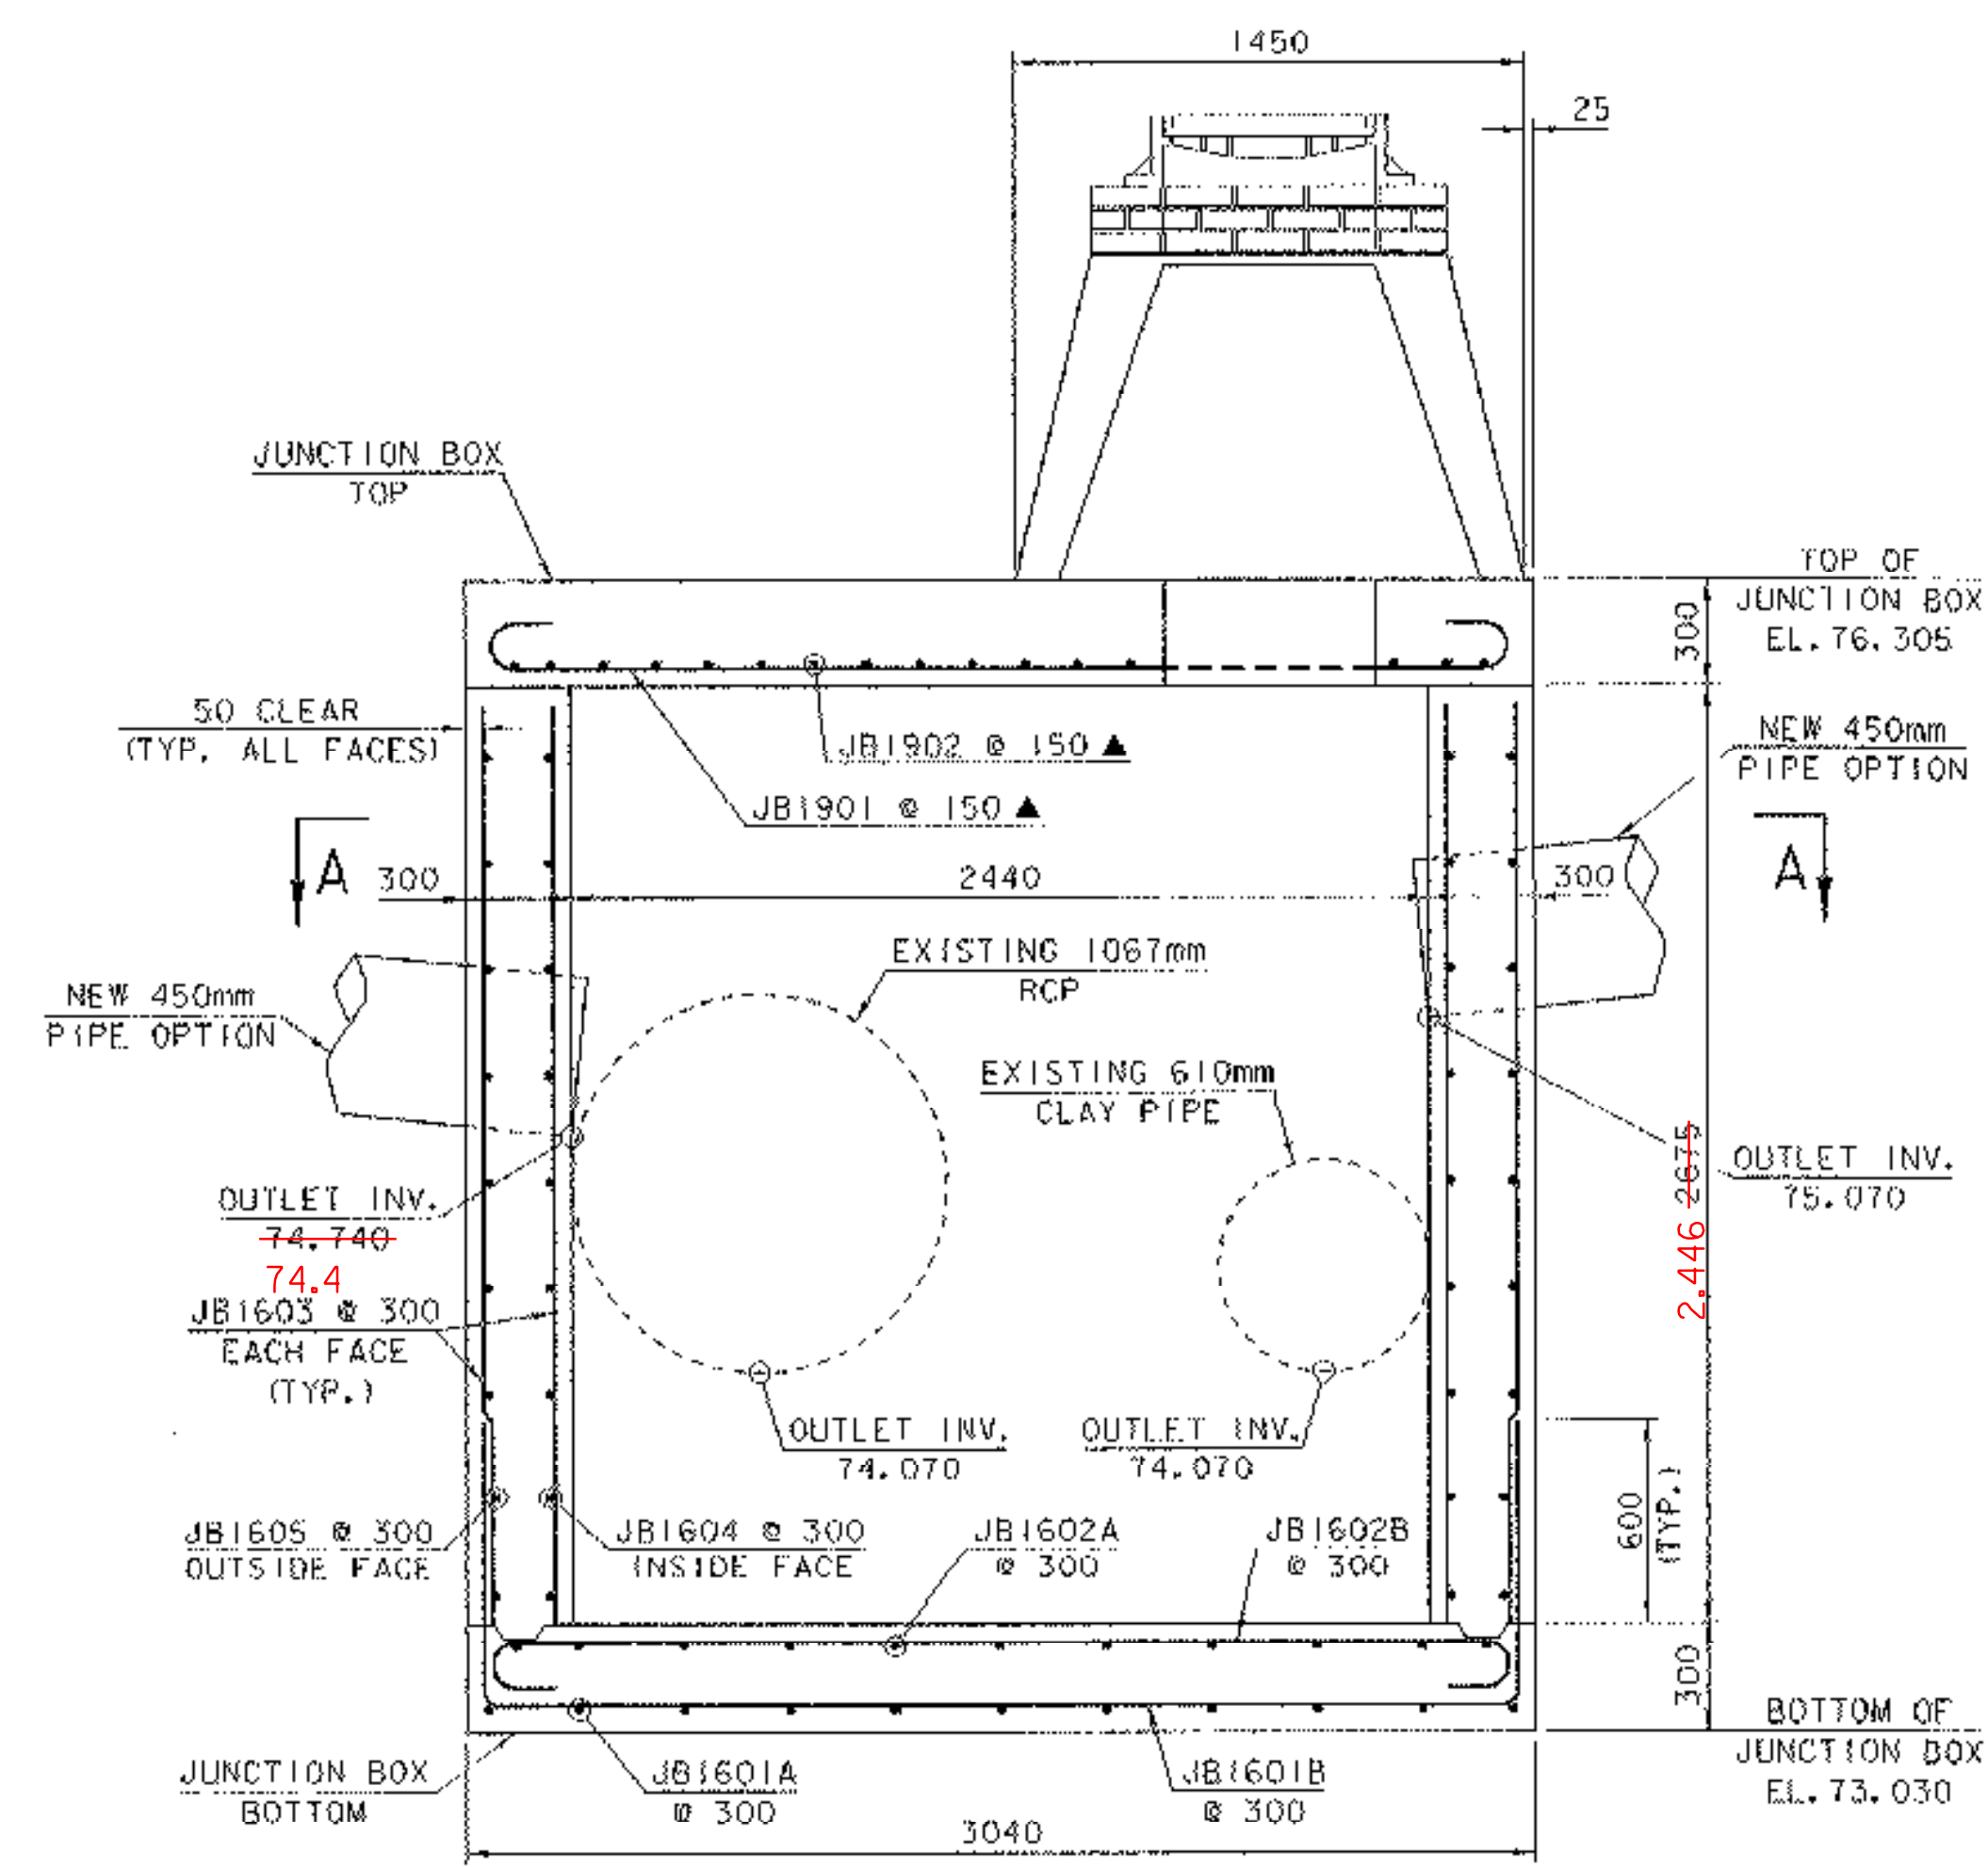


SECTION B-B

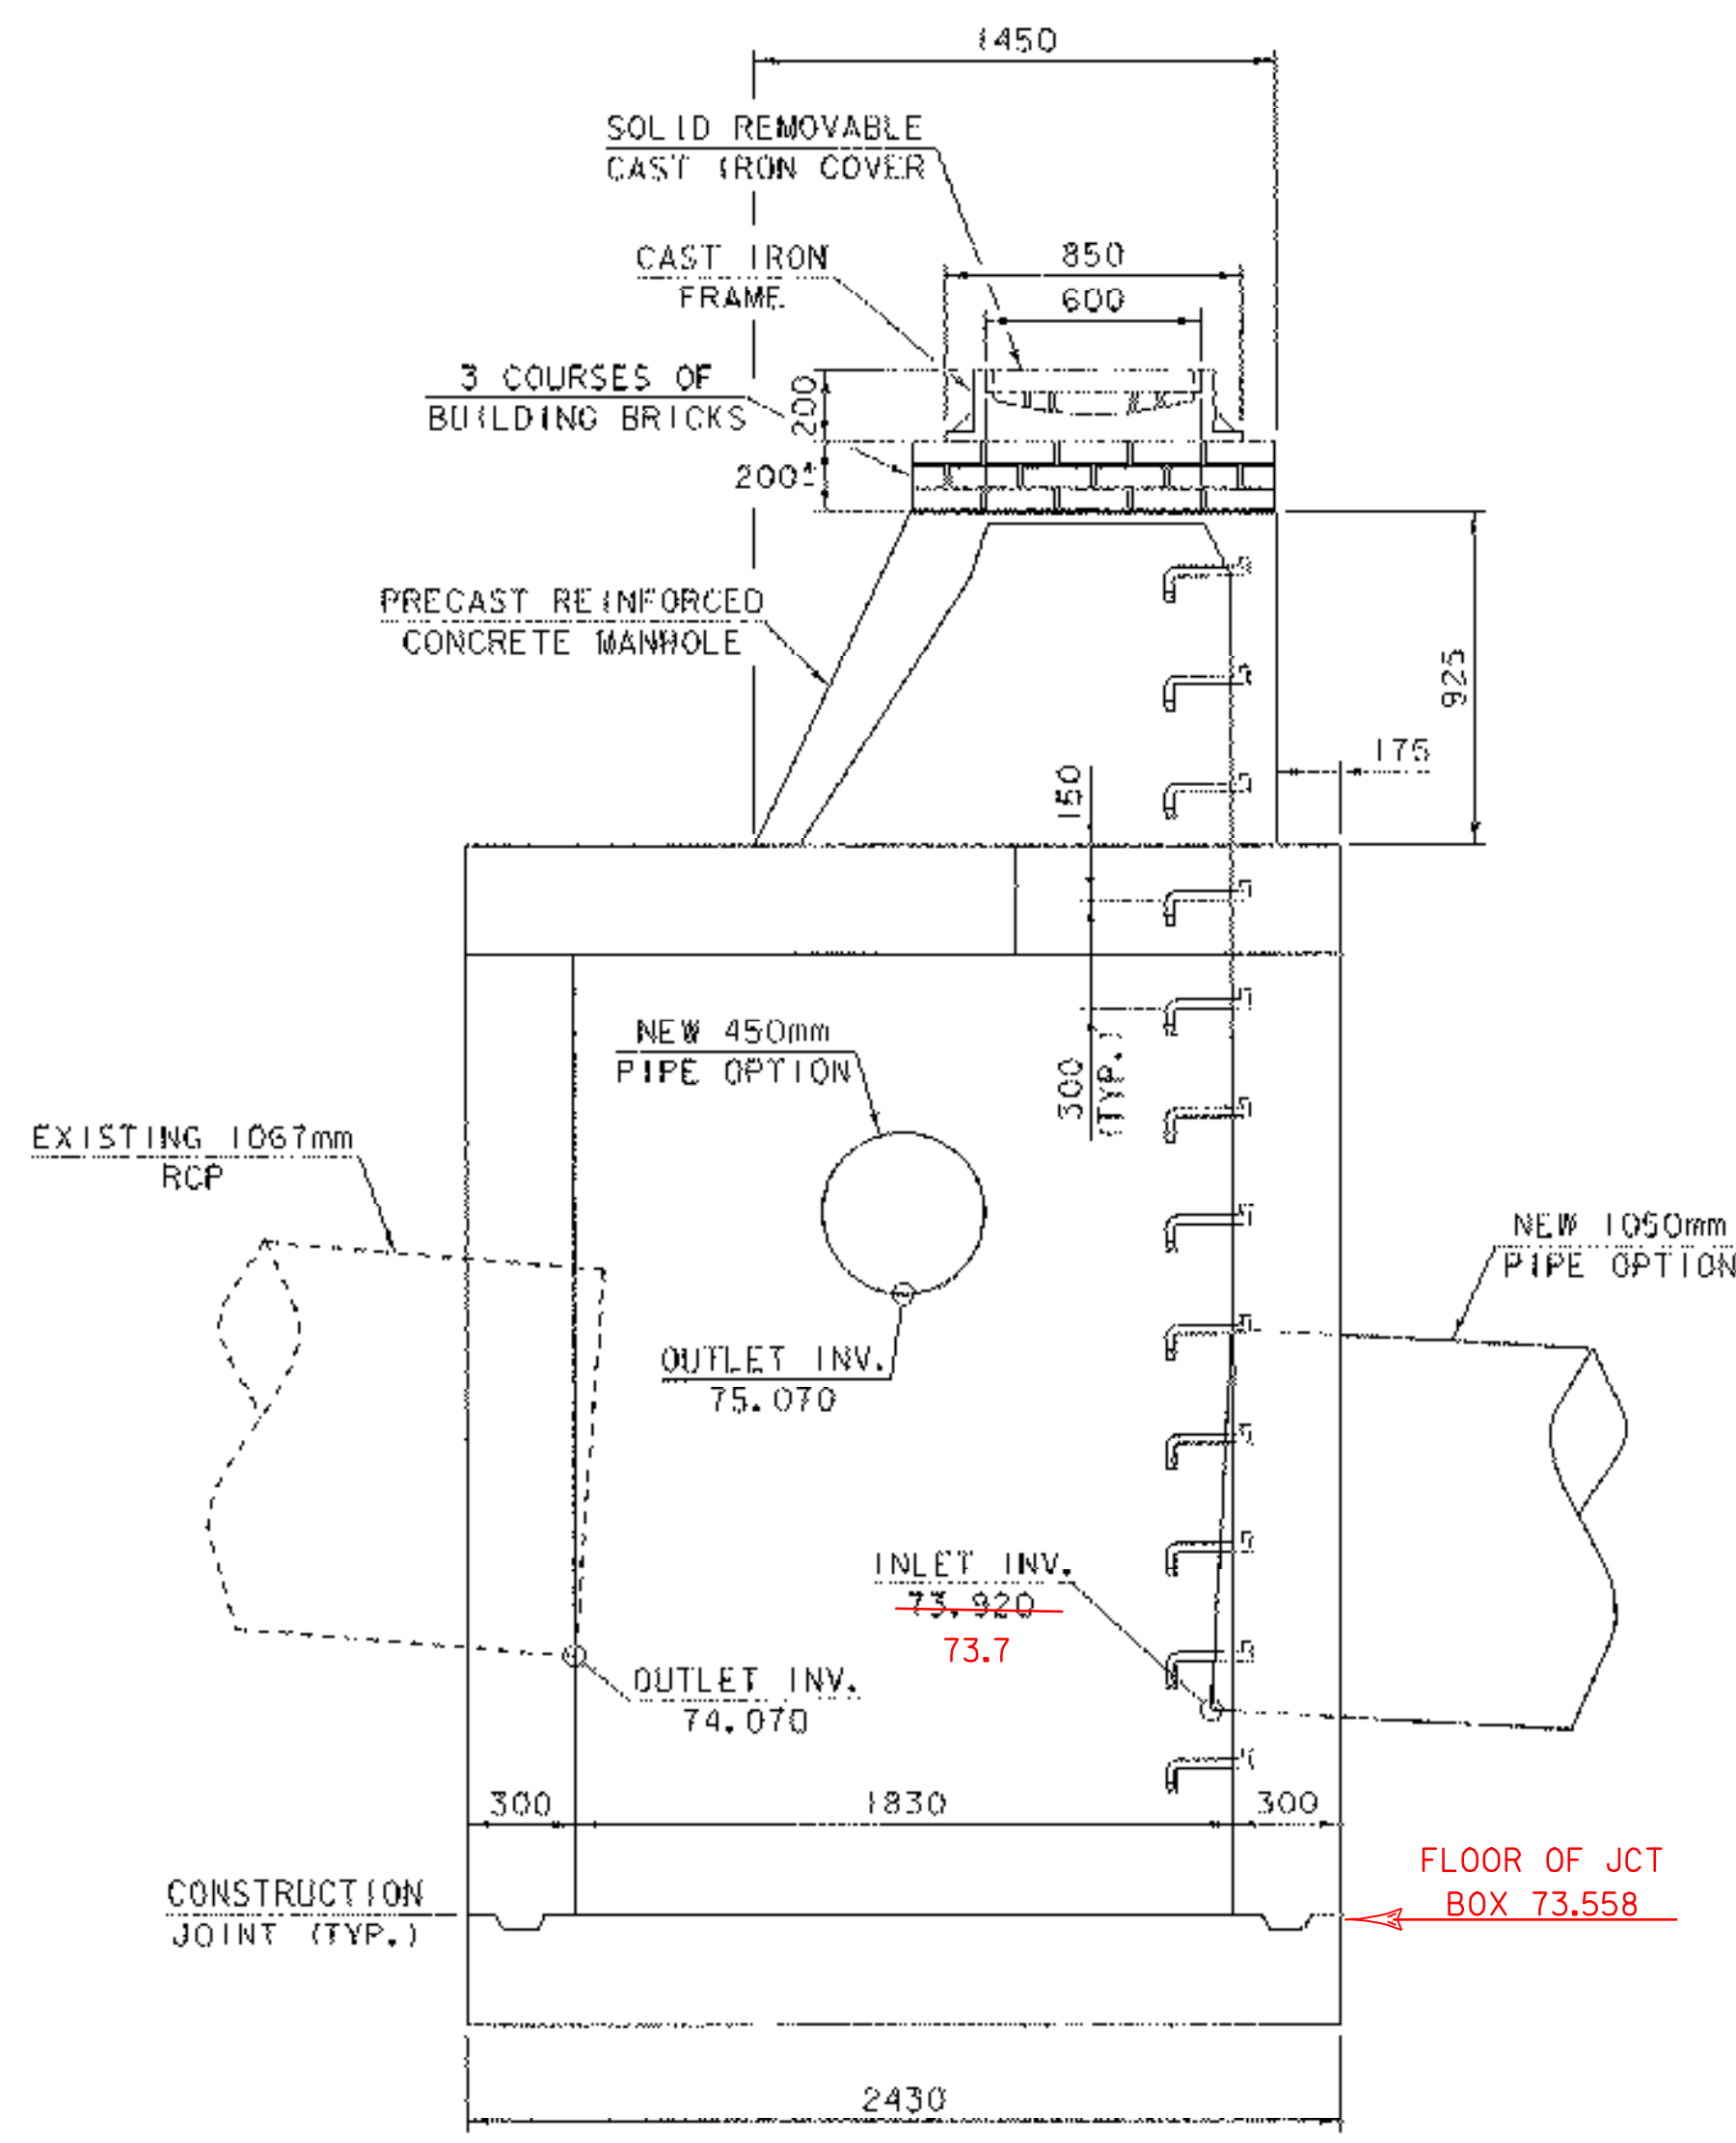

SECTION C-C

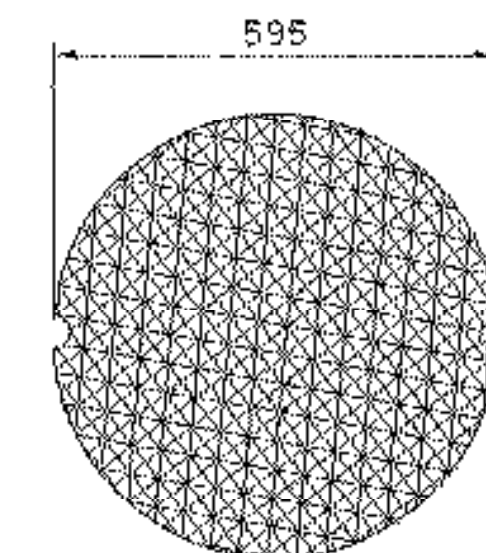

PLAN

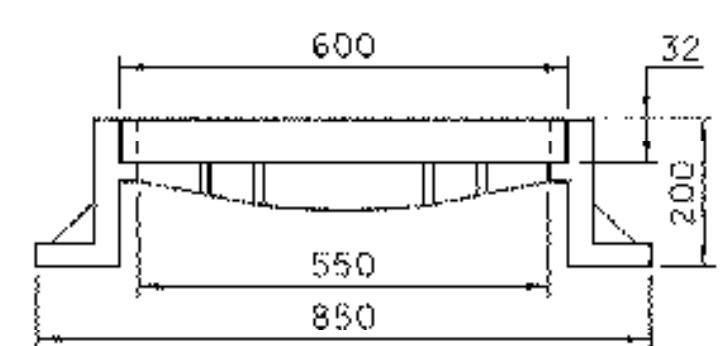

ELEVATION

CAST IRON COVER AND FRAME DETAILS (NOT TO SCALE)

NOTES

1. MORTAR TYPE II TO BE USED FOR JOINT FILLER AND LAYING OF BRICKS.
2. THE PRECAST REINFORCED CONCRETE MANHOLE SHALL BE PLACED ON THE JUNCTION BOX SO AS TO PROVIDE DIRECT ACCESS TO STEPS.
3. SEE REINFORCING STEEL SCHEDULE FOR REINFORCING BAR DETAILS

JUNCTION BOX DETAILS

PROJECT NAME:	BRATTLEBORO	FILE NAME:	94j078\Structures\j078jb.l	PLOT DATE:	06-FEB-2003
PROJECT NUMBER:	BHF 2000 (17)	PROJECT MANAGER:	R. R. WHITCOMB	DRAWN BY:	S. SCRIBNER
		DESIGNED BY:	T. SUMNER	CHECKED BY:	T. SUMNER
					SHEET 55 OF 71

