

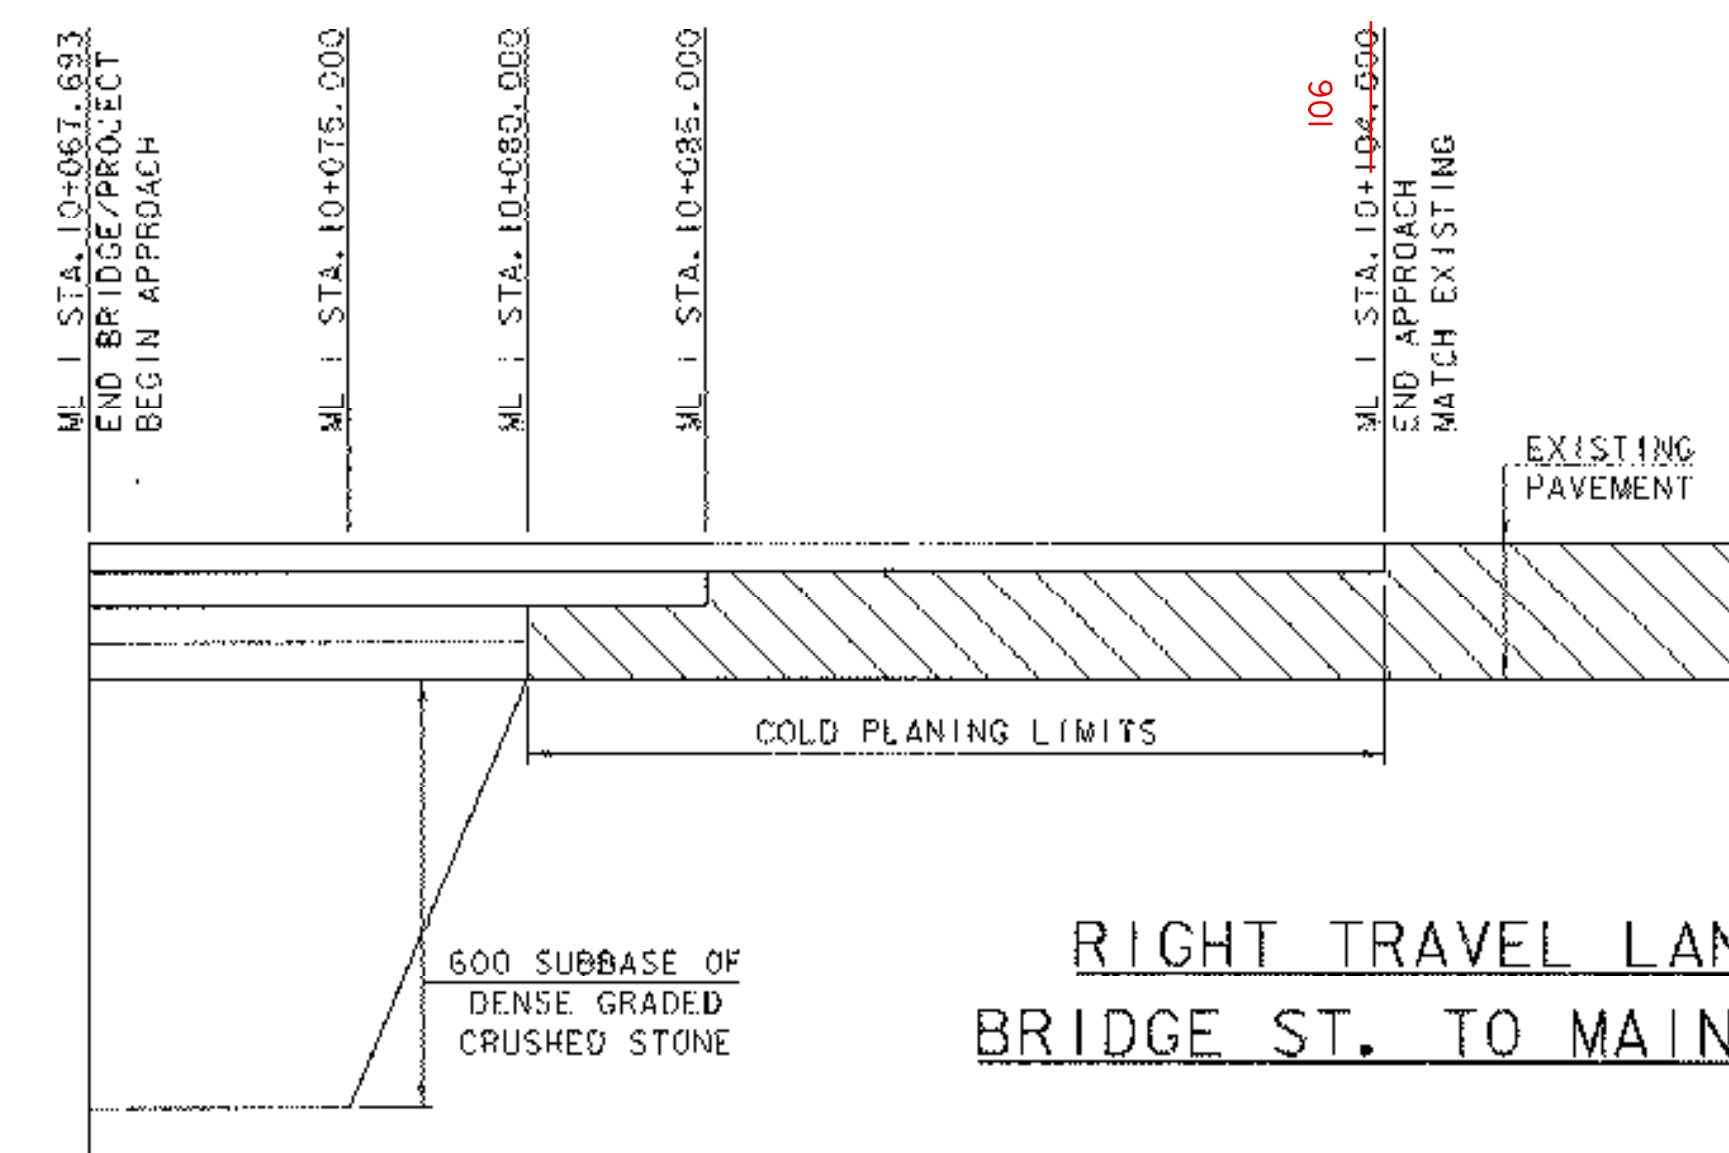



LEFT TRAVEL LANE
CANAL ST. TO MAIN ST.

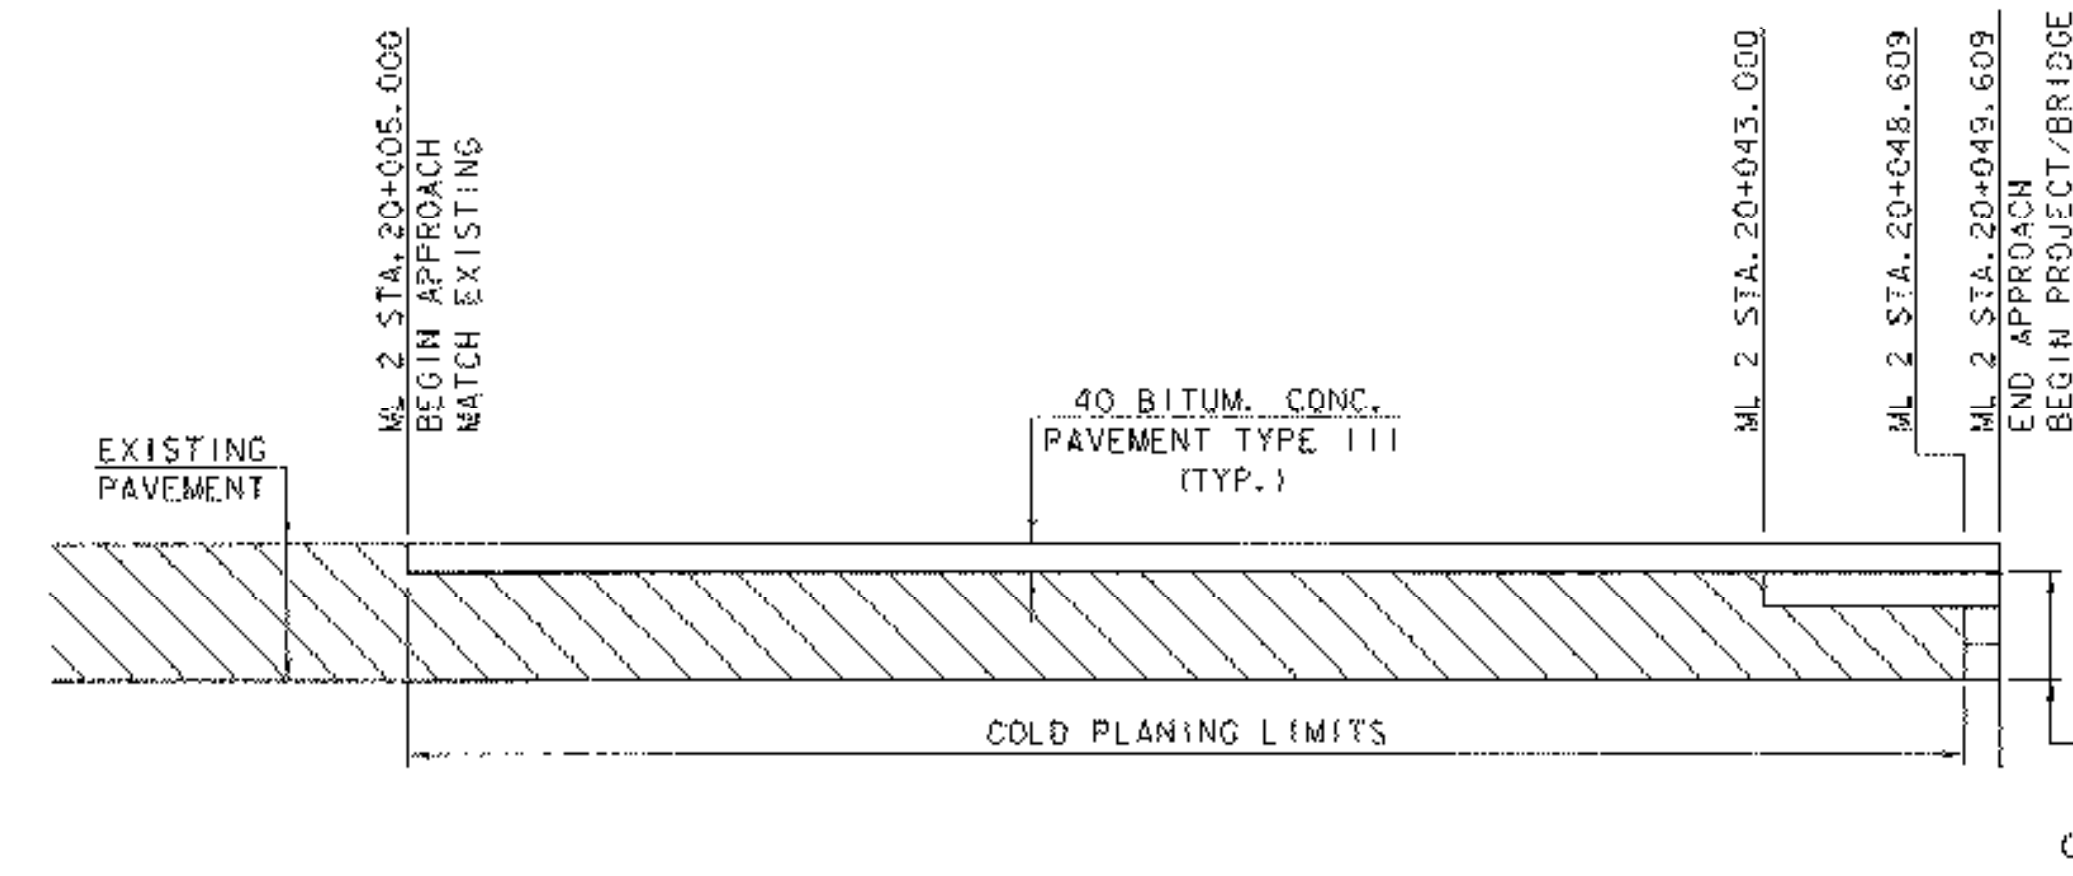

RIGHT TRAVEL LANE
BRIDGE ST. TO MAIN ST.

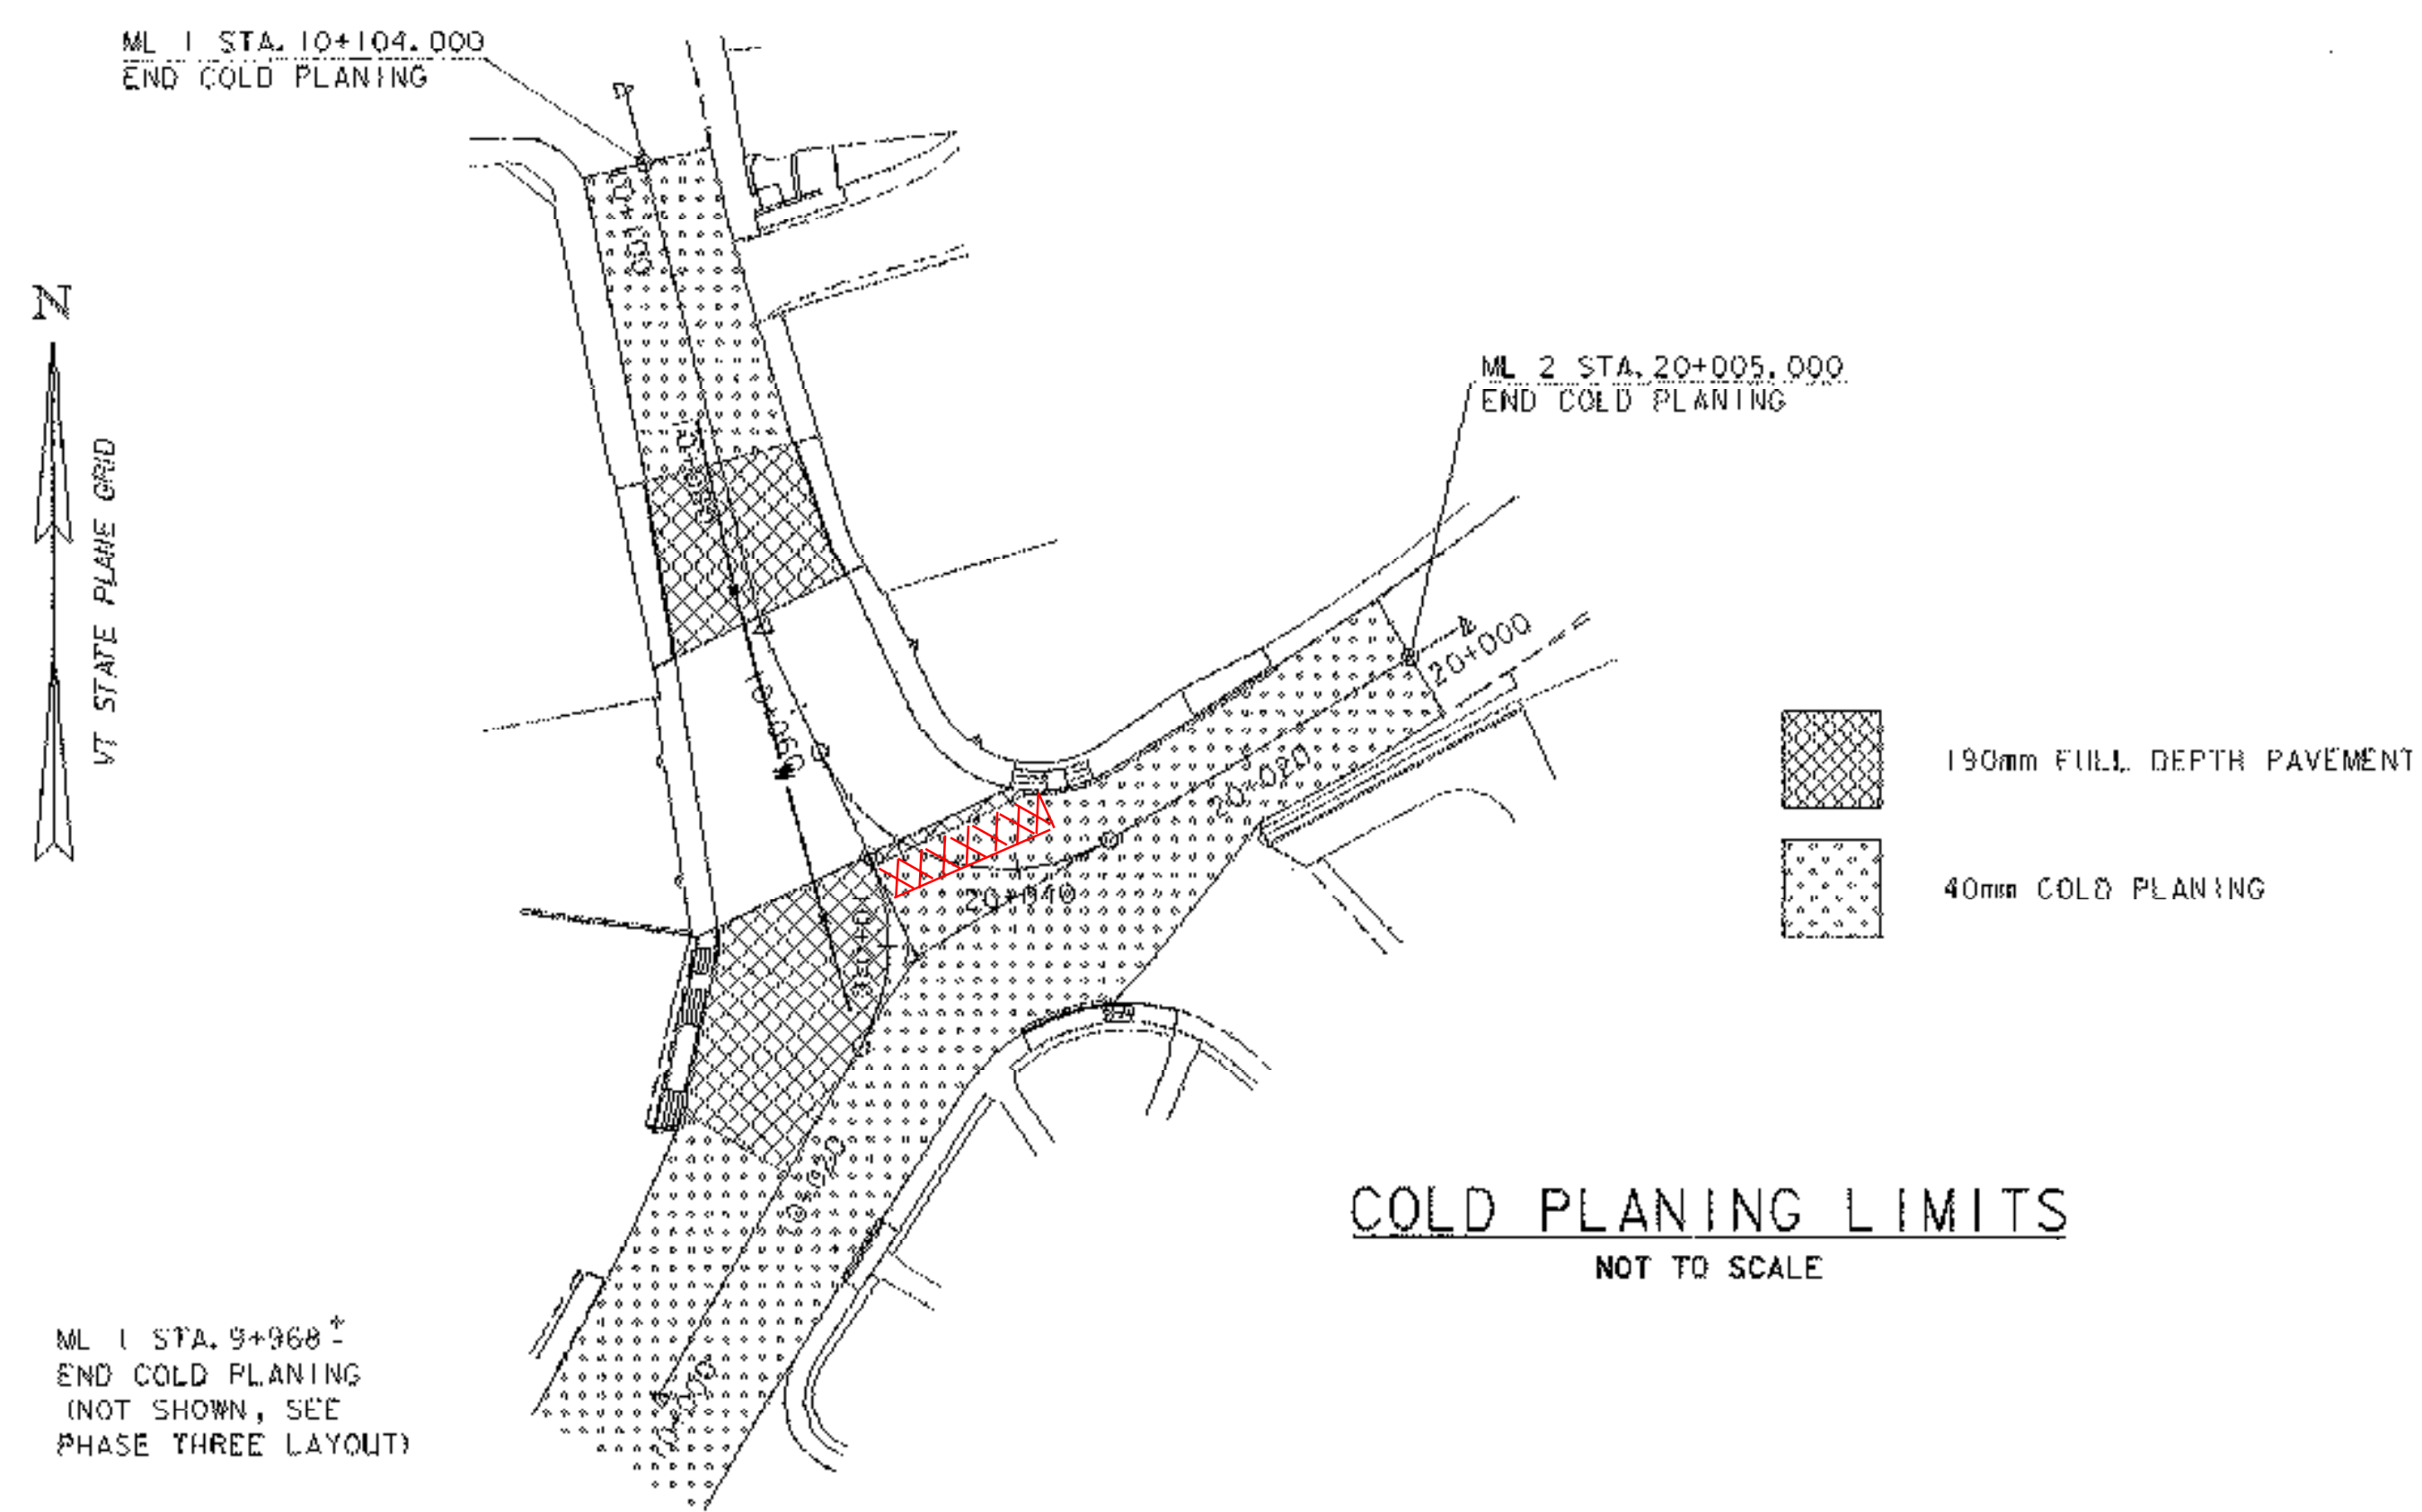

COLD PLANING LIMITS
NOT TO SCALE

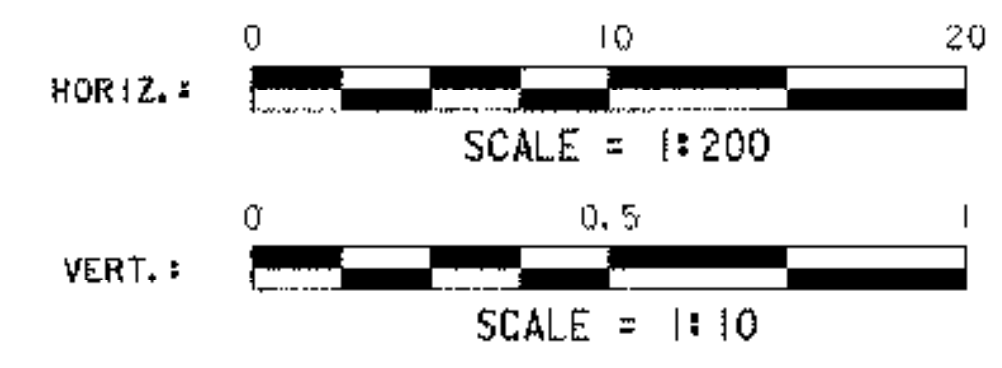

MATERIAL TRANSITION
& COLD PLANING DETAILS

PROJECT NAME:	BRATTLEBORO
PROJECT NUMBER:	BHF 2000 (17)
FILE NAME:	94\078\Structures\j078mat.d
PROJECT MANAGER:	R. R. WHITCOMB
DESIGNED BY:	G. ROY
PLOT DATE:	06-FEB-2003
DRAWN BY:	G. ROY
CHECKED BY:	T. SUMNER
SHEET	53 OF 71

ML 1 STA. 9+968.5
END COLD PLANING
(NOT SHOWN, SEE
PHASE THREE LAYOUT)