


ML 1 STA. 9+968 ±
 BEGIN APPROACH
 MATCH EXISTING

MAIN ST. CROSS SECTIONS (1)

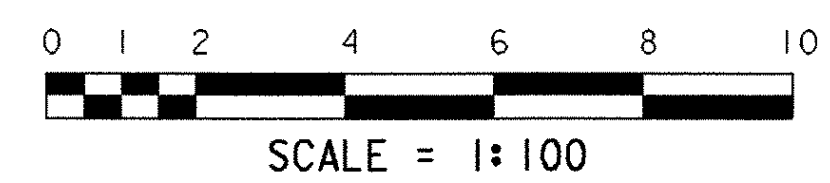

PROJECT NAME:	BRATTLEBORO	FILE NAME:	94J078\Structures\sj078m01.i	PLOT DATE:	06-FEB-2003
PROJECT NUMBER:	BHF 2000 (17)	PROJECT MANAGER:	R. R. WHITCOMB	DRAWN BY:	G. ROY
		DESIGNED BY:	G. ROY	CHECKED BY:	T. SUMNER
				SHEET	61 OF 71