


ML 1 STA. 10+047.338
END APPROACH
BEGIN PROJECT/BRIDGE

MAIN ST. CROSS SECTIONS (3)

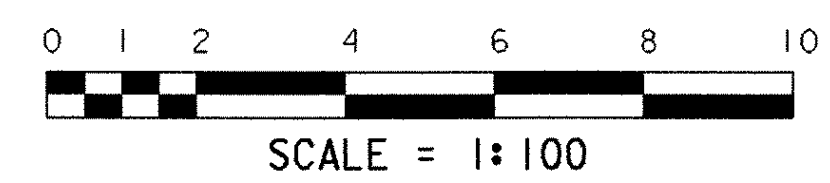

PROJECT NAME:	BRATTLEBORO	FILE NAME:	94j078\Structures\sj078m03.i	PLOT DATE:	06-FEB-2003
PROJECT NUMBER:	BHF 2000 (17)	PROJECT MANAGER:	R. R. WHITCOMB	DRAWN BY:	G. ROY
		DESIGNED BY:	G. ROY	CHECKED BY:	T. SUMNER
				SHEET	63 OF 71