


ML 2 STA. 20+005.000  
BEGIN APPROACH  
MATCH EXISTING

MAINLINE 2 CROSS SECTIONS (1)

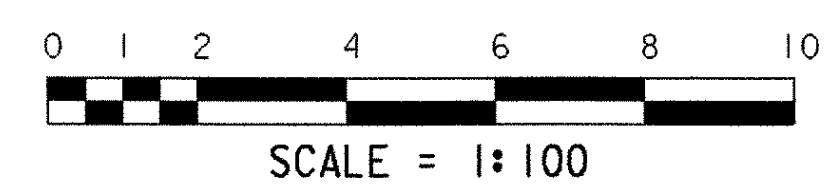

PROJECT NAME: BRATTLEBORO	PLOT DATE: 06-FEB-2003
PROJECT NUMBER: BHF 2000 (17)	DRAWN BY: G. ROY
FILE NAME: 94j078\Structures\sj078m05.i	CHECKED BY: T. SUMNER
PROJECT MANAGER: R. R. WHITCOMB	SHEET 65 OF 71
DESIGNED BY: G. ROY	