


ML 2 STA. 20+049.609
BEGIN BRIDGE

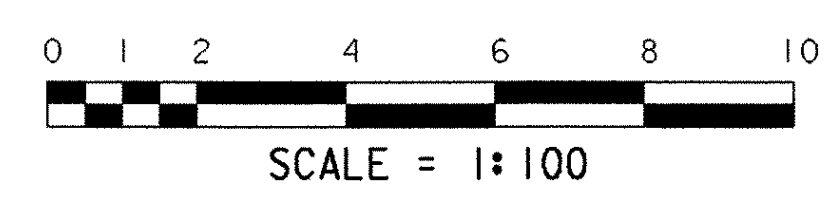

MAINLINE 2 CROSS SECTIONS (3)

PROJECT NAME:	BRATTLEBORO	PLOT DATE:	06-FEB-2003
PROJECT NUMBER:	BHF 2000 (17)	DRAWN BY:	G. ROY
FILE NAME:	94j078\Structures\sj078m07.1	CHECKED BY:	T. SUMNER
PROJECT MANAGER:	R. R. WHITCOMB	SHEET	67 OF 71
DESIGNED BY:	G. ROY		