



CHANNEL STA. 50+037.83 FAR RT.  
 BEGIN STRUCTURE EXCAVATION  
 GRANULAR BACKFILL FOR STRUCTURES

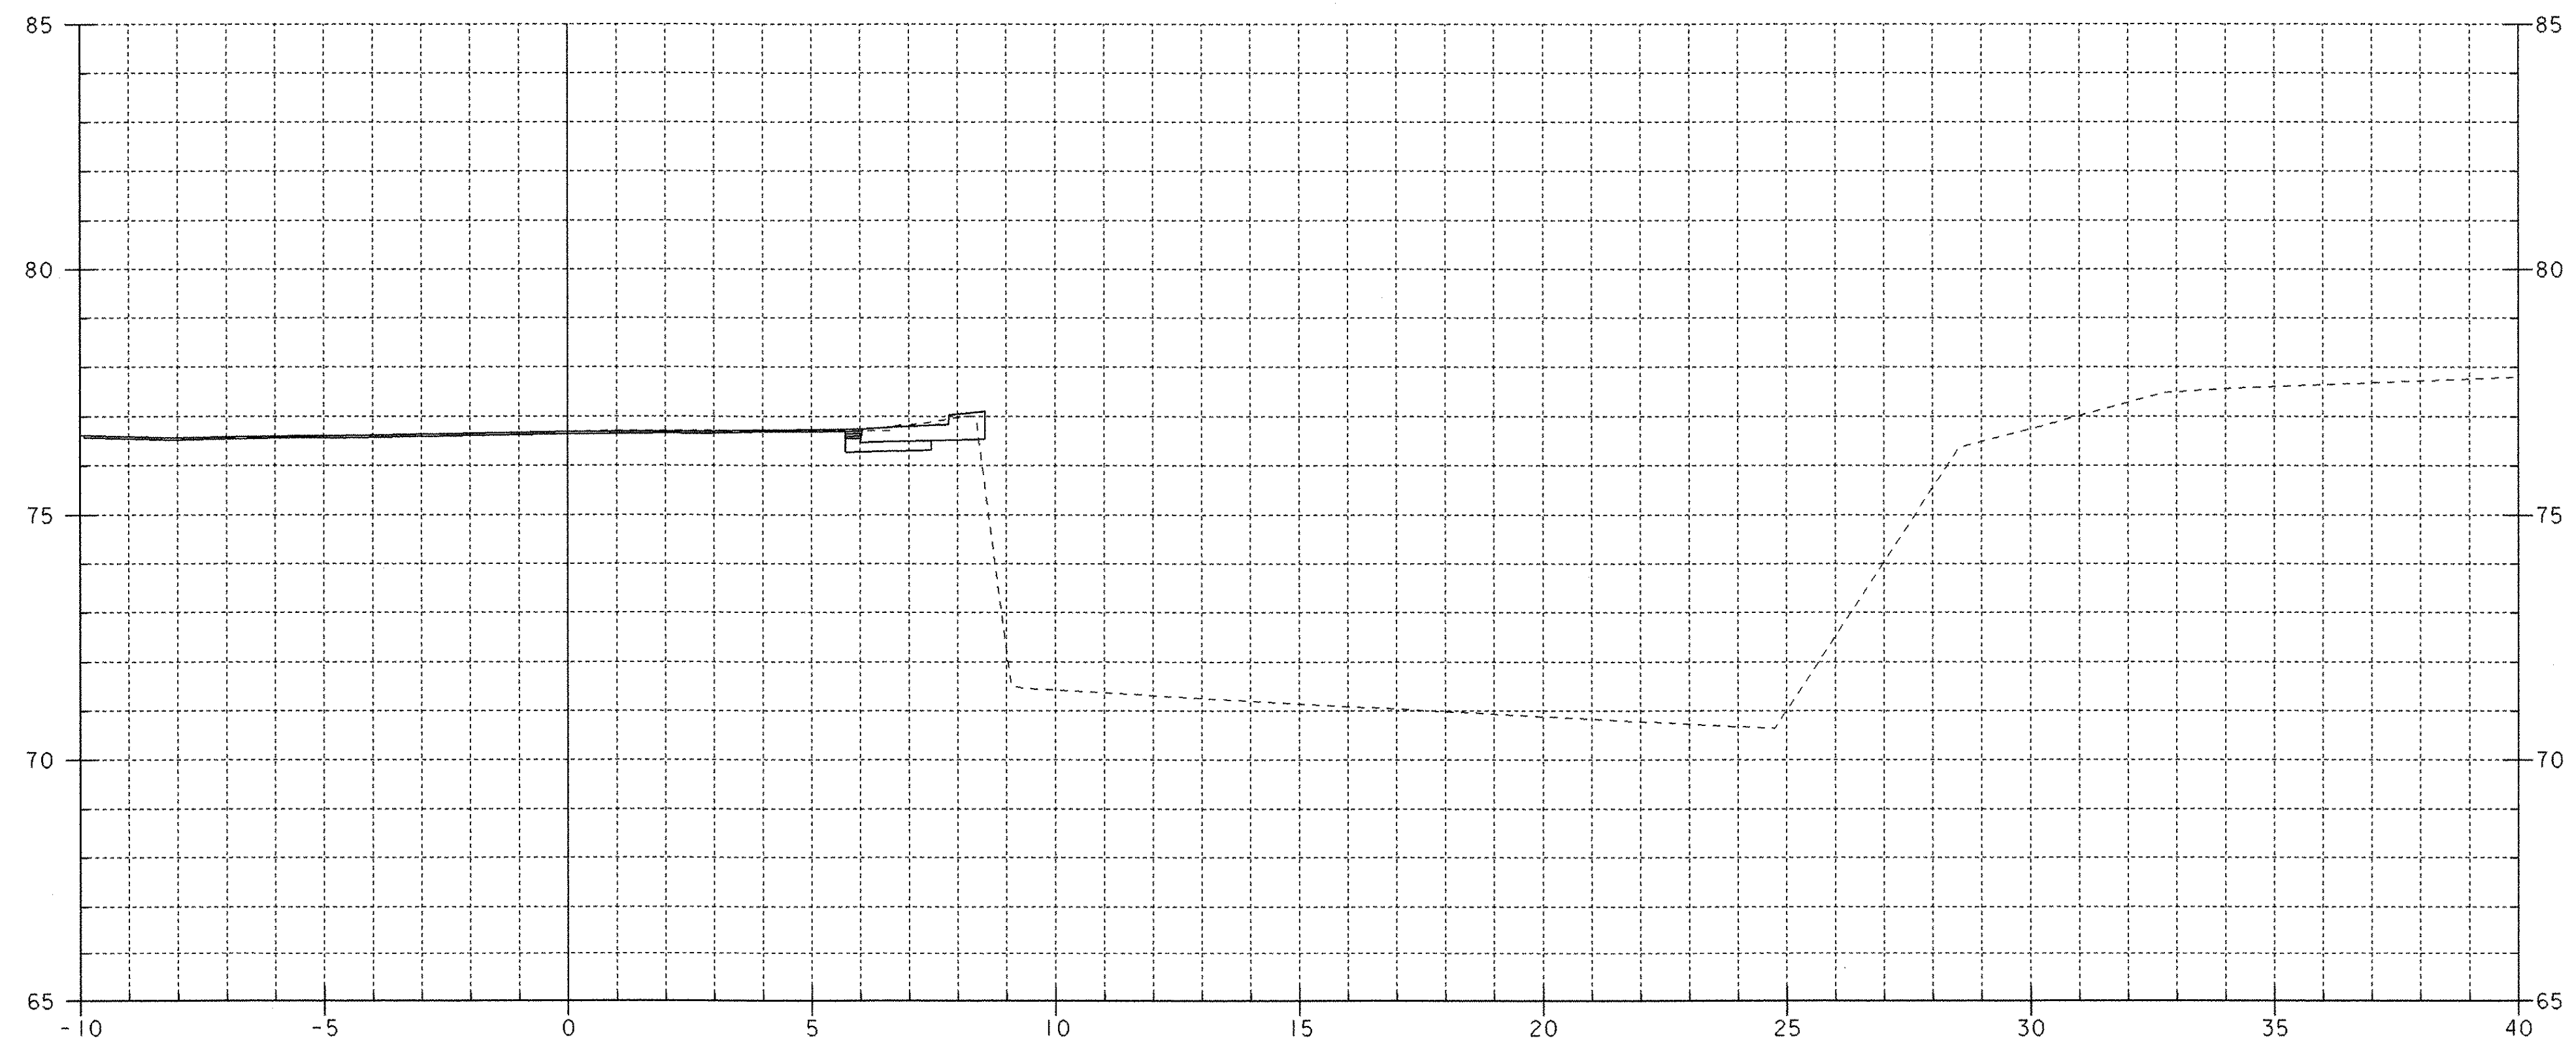

CHANNEL STA. 50+035.00 RT.  
 BEGIN STRUCTURE EXCAVATION  
 GRANULAR BACKFILL FOR STRUCTURES

NOTE:  
 SEE SHEET 60 FOR DRAINAGE  
 DETAILS AT END OF ABUT. NO. 2

CHANNEL CROSS SECTIONS (1)

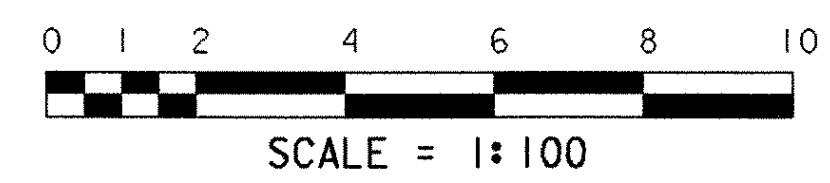

PROJECT NAME:	BRATTLEBORO	FILE NAME:	94j078\Structures\sj078c01.I	PLOT DATE:	06-FEB-2003
PROJECT NUMBER:	BHF 2000 (17)	PROJECT MANAGER:	R. R. WHITCOMB	DRAWN BY:	G. ROY
		DESIGNED BY:	G. ROY	CHECKED BY:	T. SUMNER
				SHEET	68 OF 71