



CHANNEL STA. 50+055.97 FAR RT.
 END STRUCTURE EXCAVATION
 GRANULAR BACKFILL FOR STRUCTURES

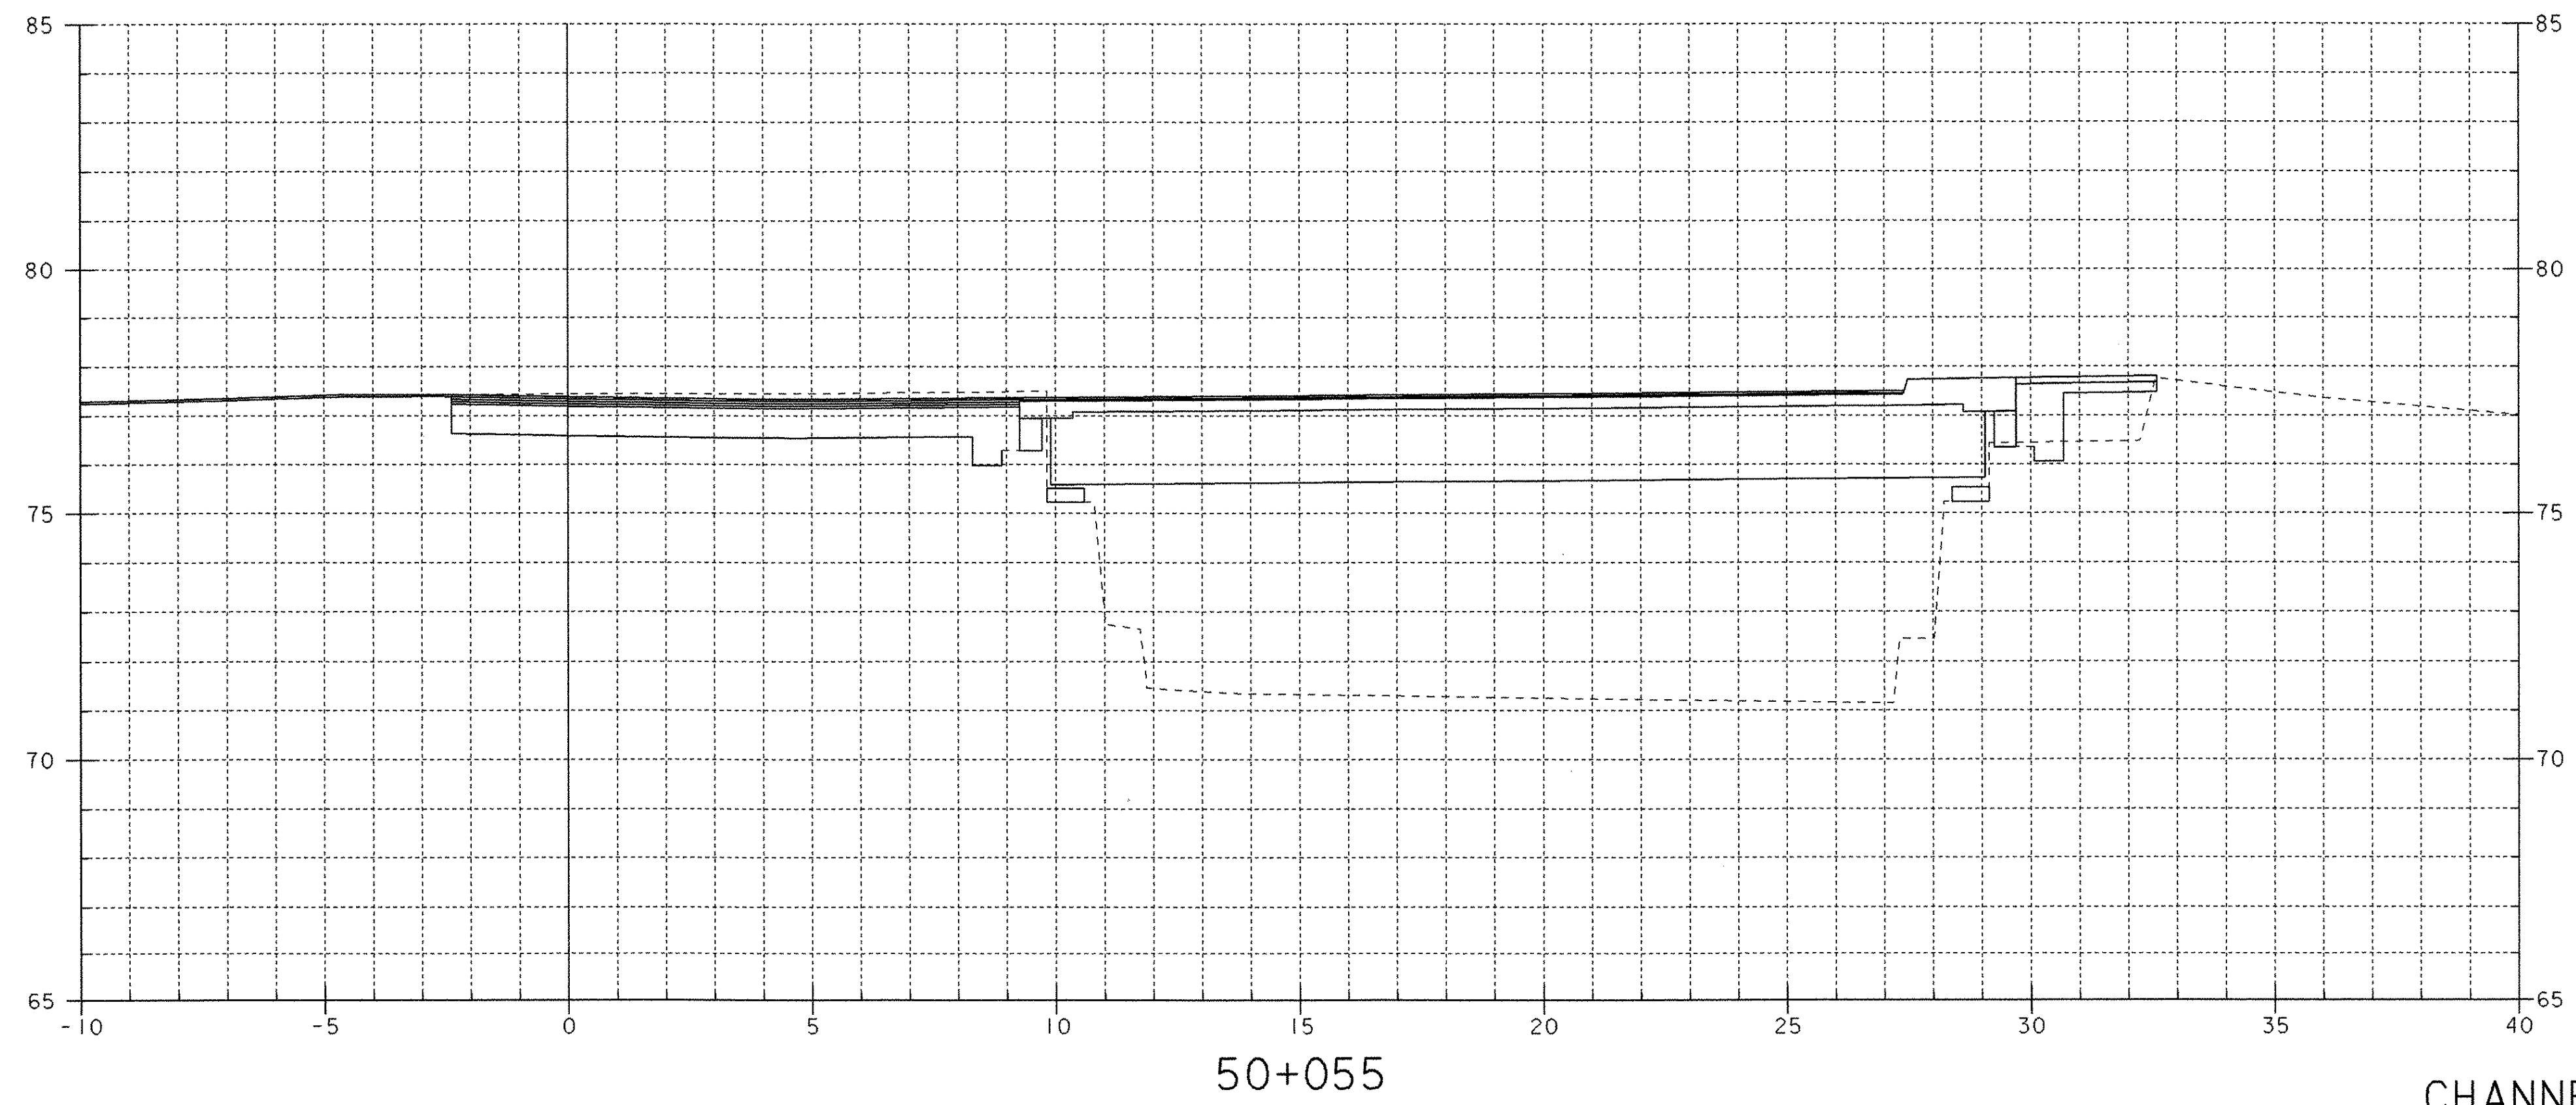

CHANNEL CROSS SECTIONS (3)

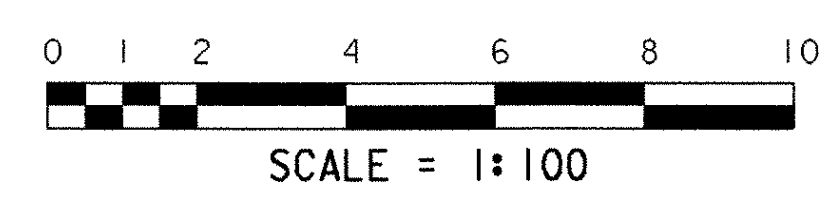

PROJECT NAME:	BRATTLEBORO	PLOT DATE:	06-FEB-2003
PROJECT NUMBER:	BHF 2000 (17)	DRAWN BY:	G. ROY
FILE NAME:	94J078\Structures\sj078c03.1	DESIGNED BY:	G. ROY
PROJECT MANAGER:	R. R. WHITCOMB	CHECKED BY:	T. SUMNER
		SHEET	70 OF 71