


CHANNEL STA. 50+064.69 RT.
 END STRUCTURE EXCAVATION
 GRANULAR BACKFILL FOR STRUCTURES

CHANNEL CROSS SECTIONS (4)

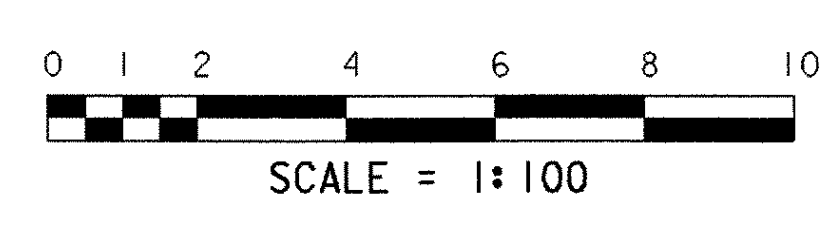

PROJECT NAME:	BRATTLEBORO	PROJECT NUMBER:	BHF 2000 (17)
FILE NAME:	94j078\Structures\sj078c04.i	PROJECT MANAGER:	R. R. WHITCOMB
DESIGNED BY:	G. ROY	PLLOT DATE:	06-FEB-2003
		DRAWN BY:	G. ROY
		CHECKED BY:	T. SUMNER
		SHEET	71 OF 71