


WHETSTONE
BROOK


CROSS SECTION THROUGH BRIDGE DECK
1" = 1'

NOTE: THE BRIDGE IS PERPENDICULAR TO THE CONCRETE WALL ON THE NORTH SIDE. THEREFORE SHORTEN THE SOUTH WEST BEAM.

PLAN VIEW
1" = 40'

**PEDESTRIAN BRIDGE
FOR THE MAIN STREET BRIDGE REPAIR
BRATTLEBORO, VT**

 BELL ENGINEERING CIVIL & ENVIRONMENTAL 17 ECHO COVE WAY SPOFFORD, NH 03462 (603) 363-9966	DATE: 5-01-03	PROJECT NUMBER 03-025
	DESIGNED BY: RONALD BELL, PE	DRAWN BY: RONALD BELL, PE
SCALE: AS SHOWN	SHEET 1 072	

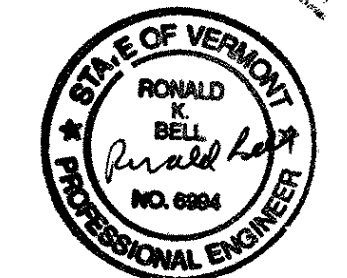

Rec'd. 5/5/03