

MARK "A"	QTY	(A)	(B)
xlc	2	74	4
xld	8	73	2

LINE 2
LINES 3 & 4

MARK "B"	QTY	(C)
xlg	2	95
xlh	1	122
xlk	1	111







LINE 1
LINE 2 (DROP 27)
LINE 2 (DROP 16)

MARK "C"	QTY	(D)
xln	3	95
xlp	3	117

LINE 1
LINE 2 (DROPS 24, 22 & 19)

MARK "D"	QTY	(E)
xlt	1	444
xlv	1	452

DROP 26
DROP 18

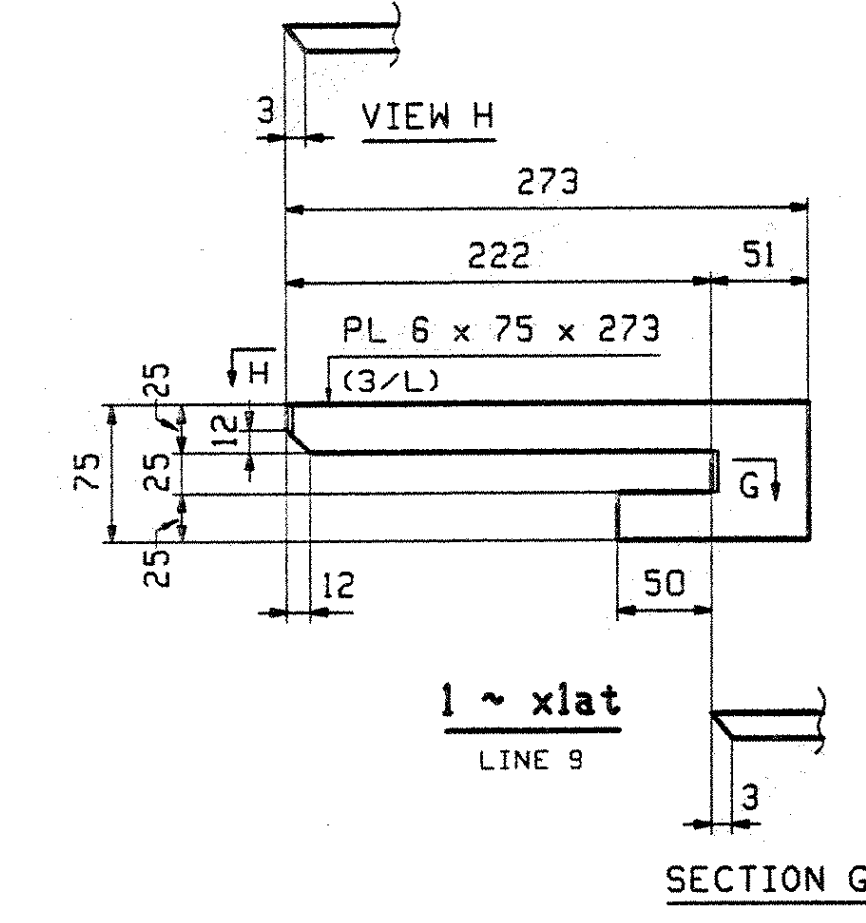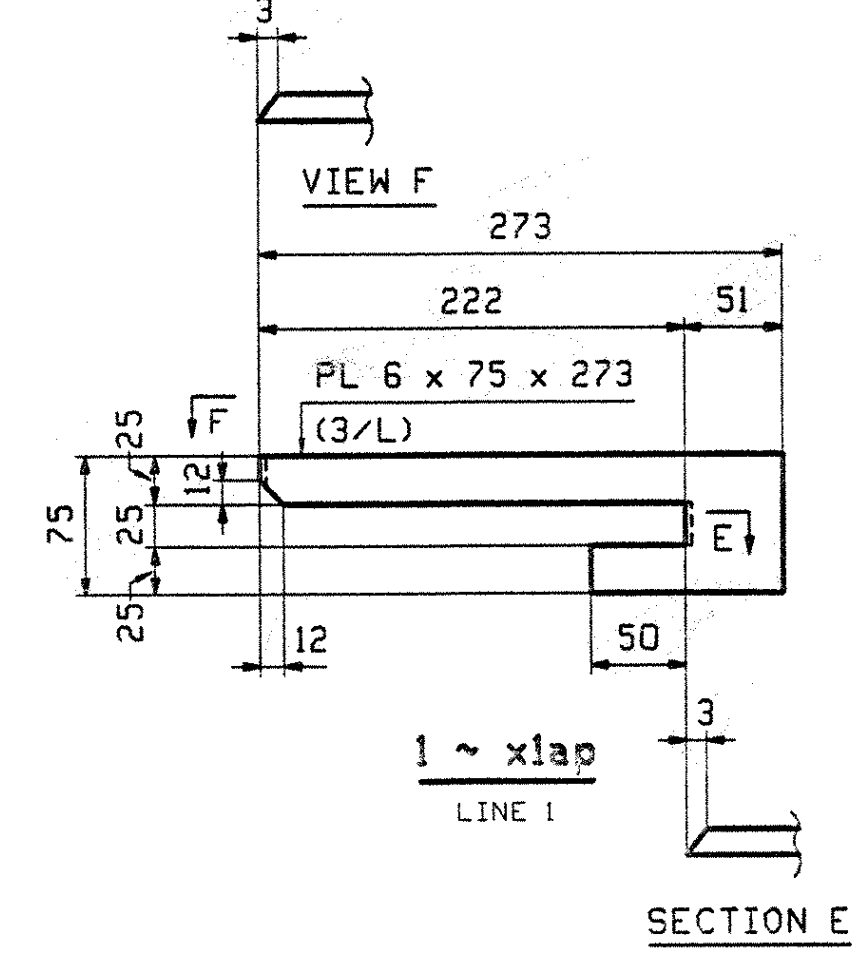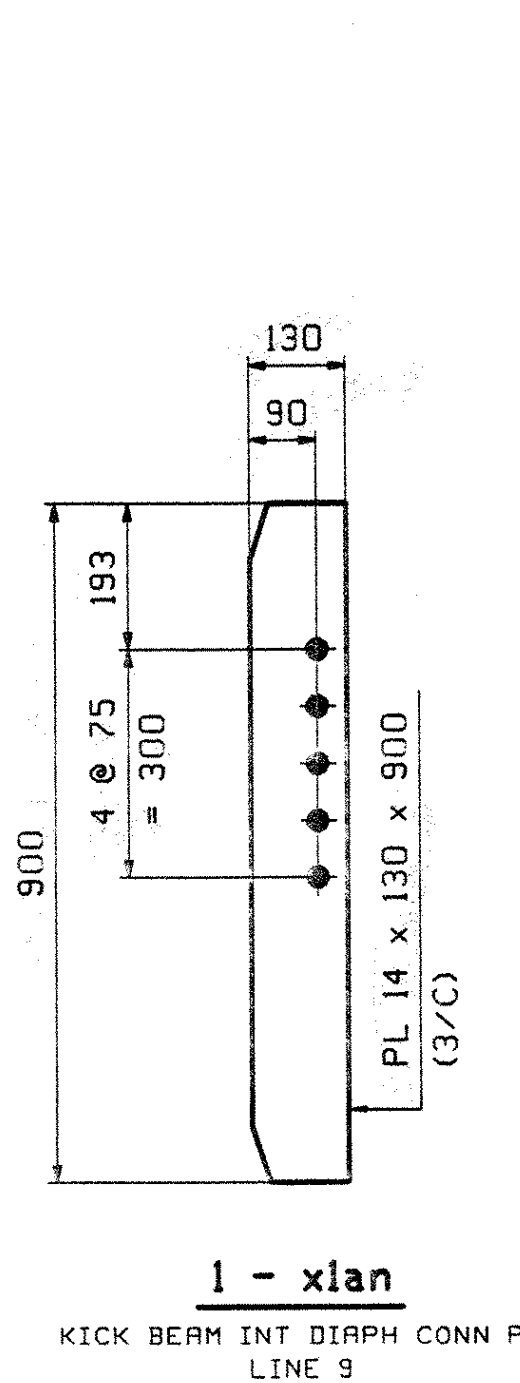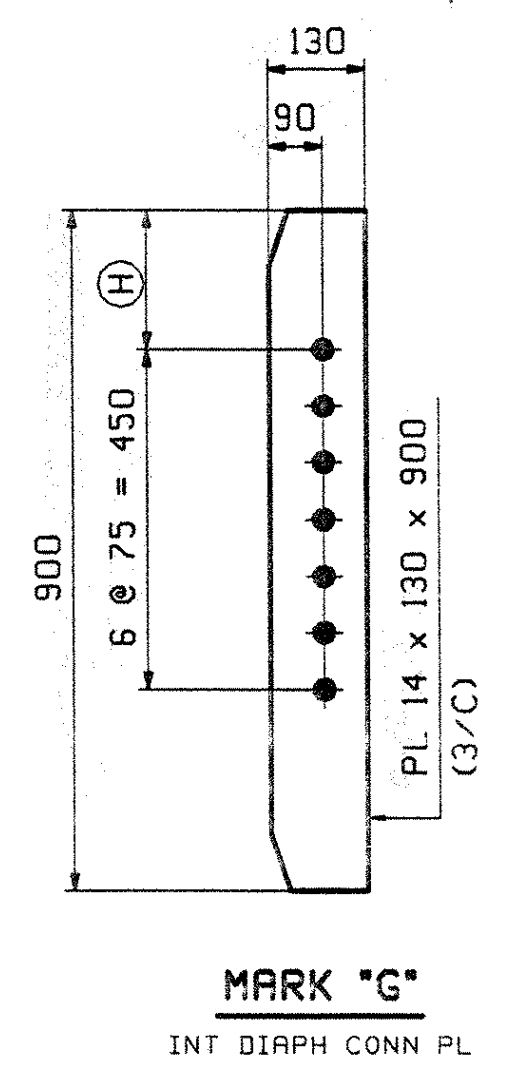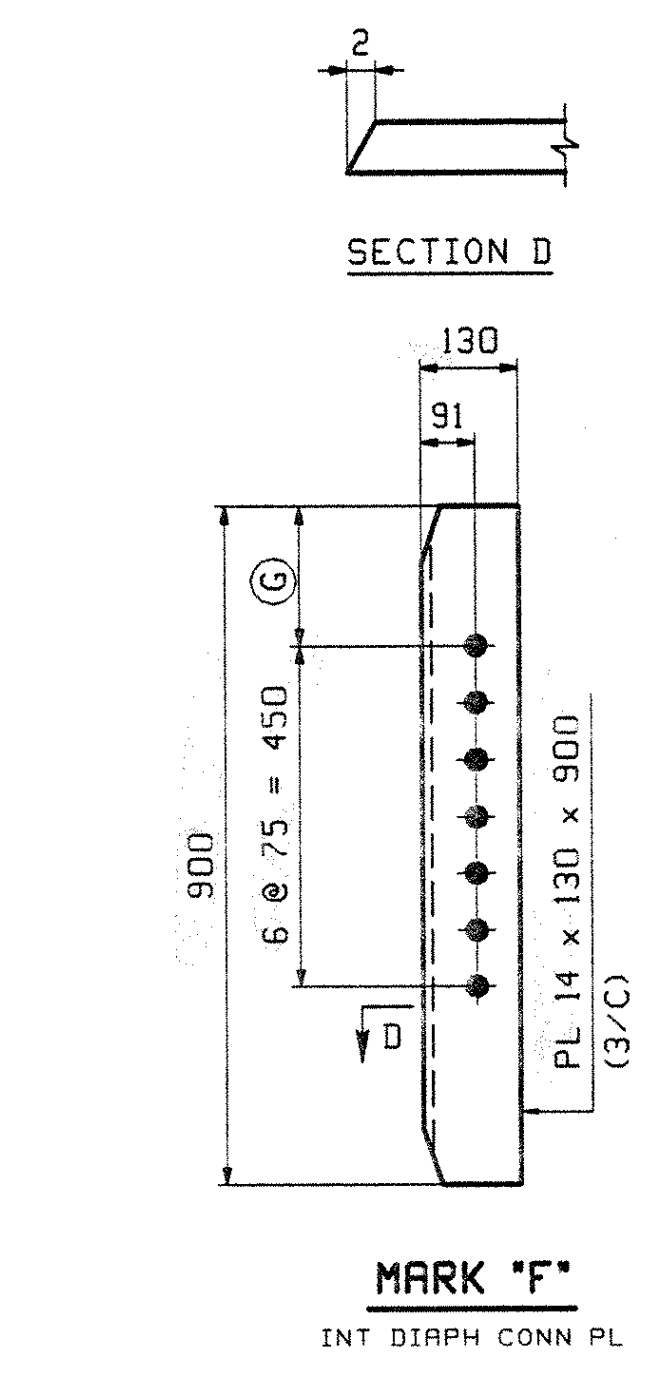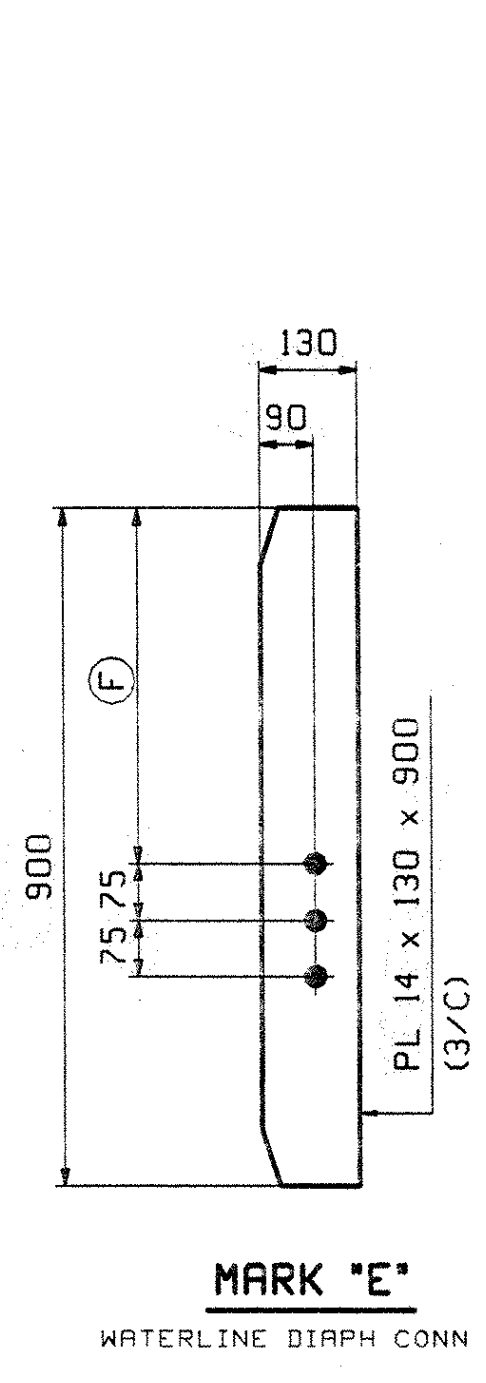

MARK "E"	QTY	(F)
xlw	3	470
xly	1	452

HIGH END (LINES 5 & 6)
DROP 18 (LINE 5)

MARK "F"	QTY	(G)
xlaa	6	207
xlab	9	185

HIGH END (LINES 2, 3 & 4)
LOW END (LINES 2, 3 & 4)

MARK "G"	QTY	(H)
xlac	1	274
xlad	1	257
xlaf	1	249
xlag	2	239
xlah	1	229
xlak	9	207
xlam	12	185

DROP 89
DROP 72
DROP 54
DROP 54
DROP 44
DROP 19, 22 & 24
LOW END

NOTES:
1. ALL MATERIAL TO BE M270-345W.
2. FOR GENERAL NOTES SEE DRAWING GNI.
3. ALL BOLT HOLES SHALL BE $\frac{15}{16}$ " FOR $\frac{7}{8}$ " HSB.

OUT FOR APPROVAL	4-14-03								
ISSUED TO SHOP									
FIELD & OFFICE									

REV.	REMARKS	DATE	DWN	CHK	APP	Q.A.	NO.	DIA.	LGT	TYPE	WASHER
	MATERIAL: M270M-345W										
	ELECTRODES:										
	HOLES:										
	SHOP BOLTS:										

SURFACE PREP. & PAINT:		-ALL STEEL SHALL BE BLAST CLEANED AND LEFT UNPAINTED.	
DESCRIPTION:	GIRDER STANDARDS	DRAWN BY	DATE
JOB:	US 5 OVER WHETSTONE BROOK	JTB	03/20
	BRIDGE NO. 7	CHKD BY	
	BRATTLEBORO, VERMONT (WINDHAM COUNTY)	EPE	04/07
	CONTRACTOR: RENAUD BROTHERS	APPROV BY	
		SUPERVISOR	M. J. GATTI
PROJ NO.	BHF 2000(17)	Q.A.	
CUSTOMER:	VERMONT AGENCY OF TRANSPORTATION		
CASCO BAY STEEL STRUCTURES, INC.		JOB NO.	DRG. NO.
75 SPRING HILL ROAD		194	X1
PHONE (207) 282-7360		SACO, MAINE 04072	
		FAX. (207) 282-1179	
		REV.	△

V.A.O.T. RECEIVED
OK'D BY S.S.S. OK'D BY JWP
4/17/03 4/15/03
APR 15 2003
RESUBMIT APPROVED X
BY DATE