
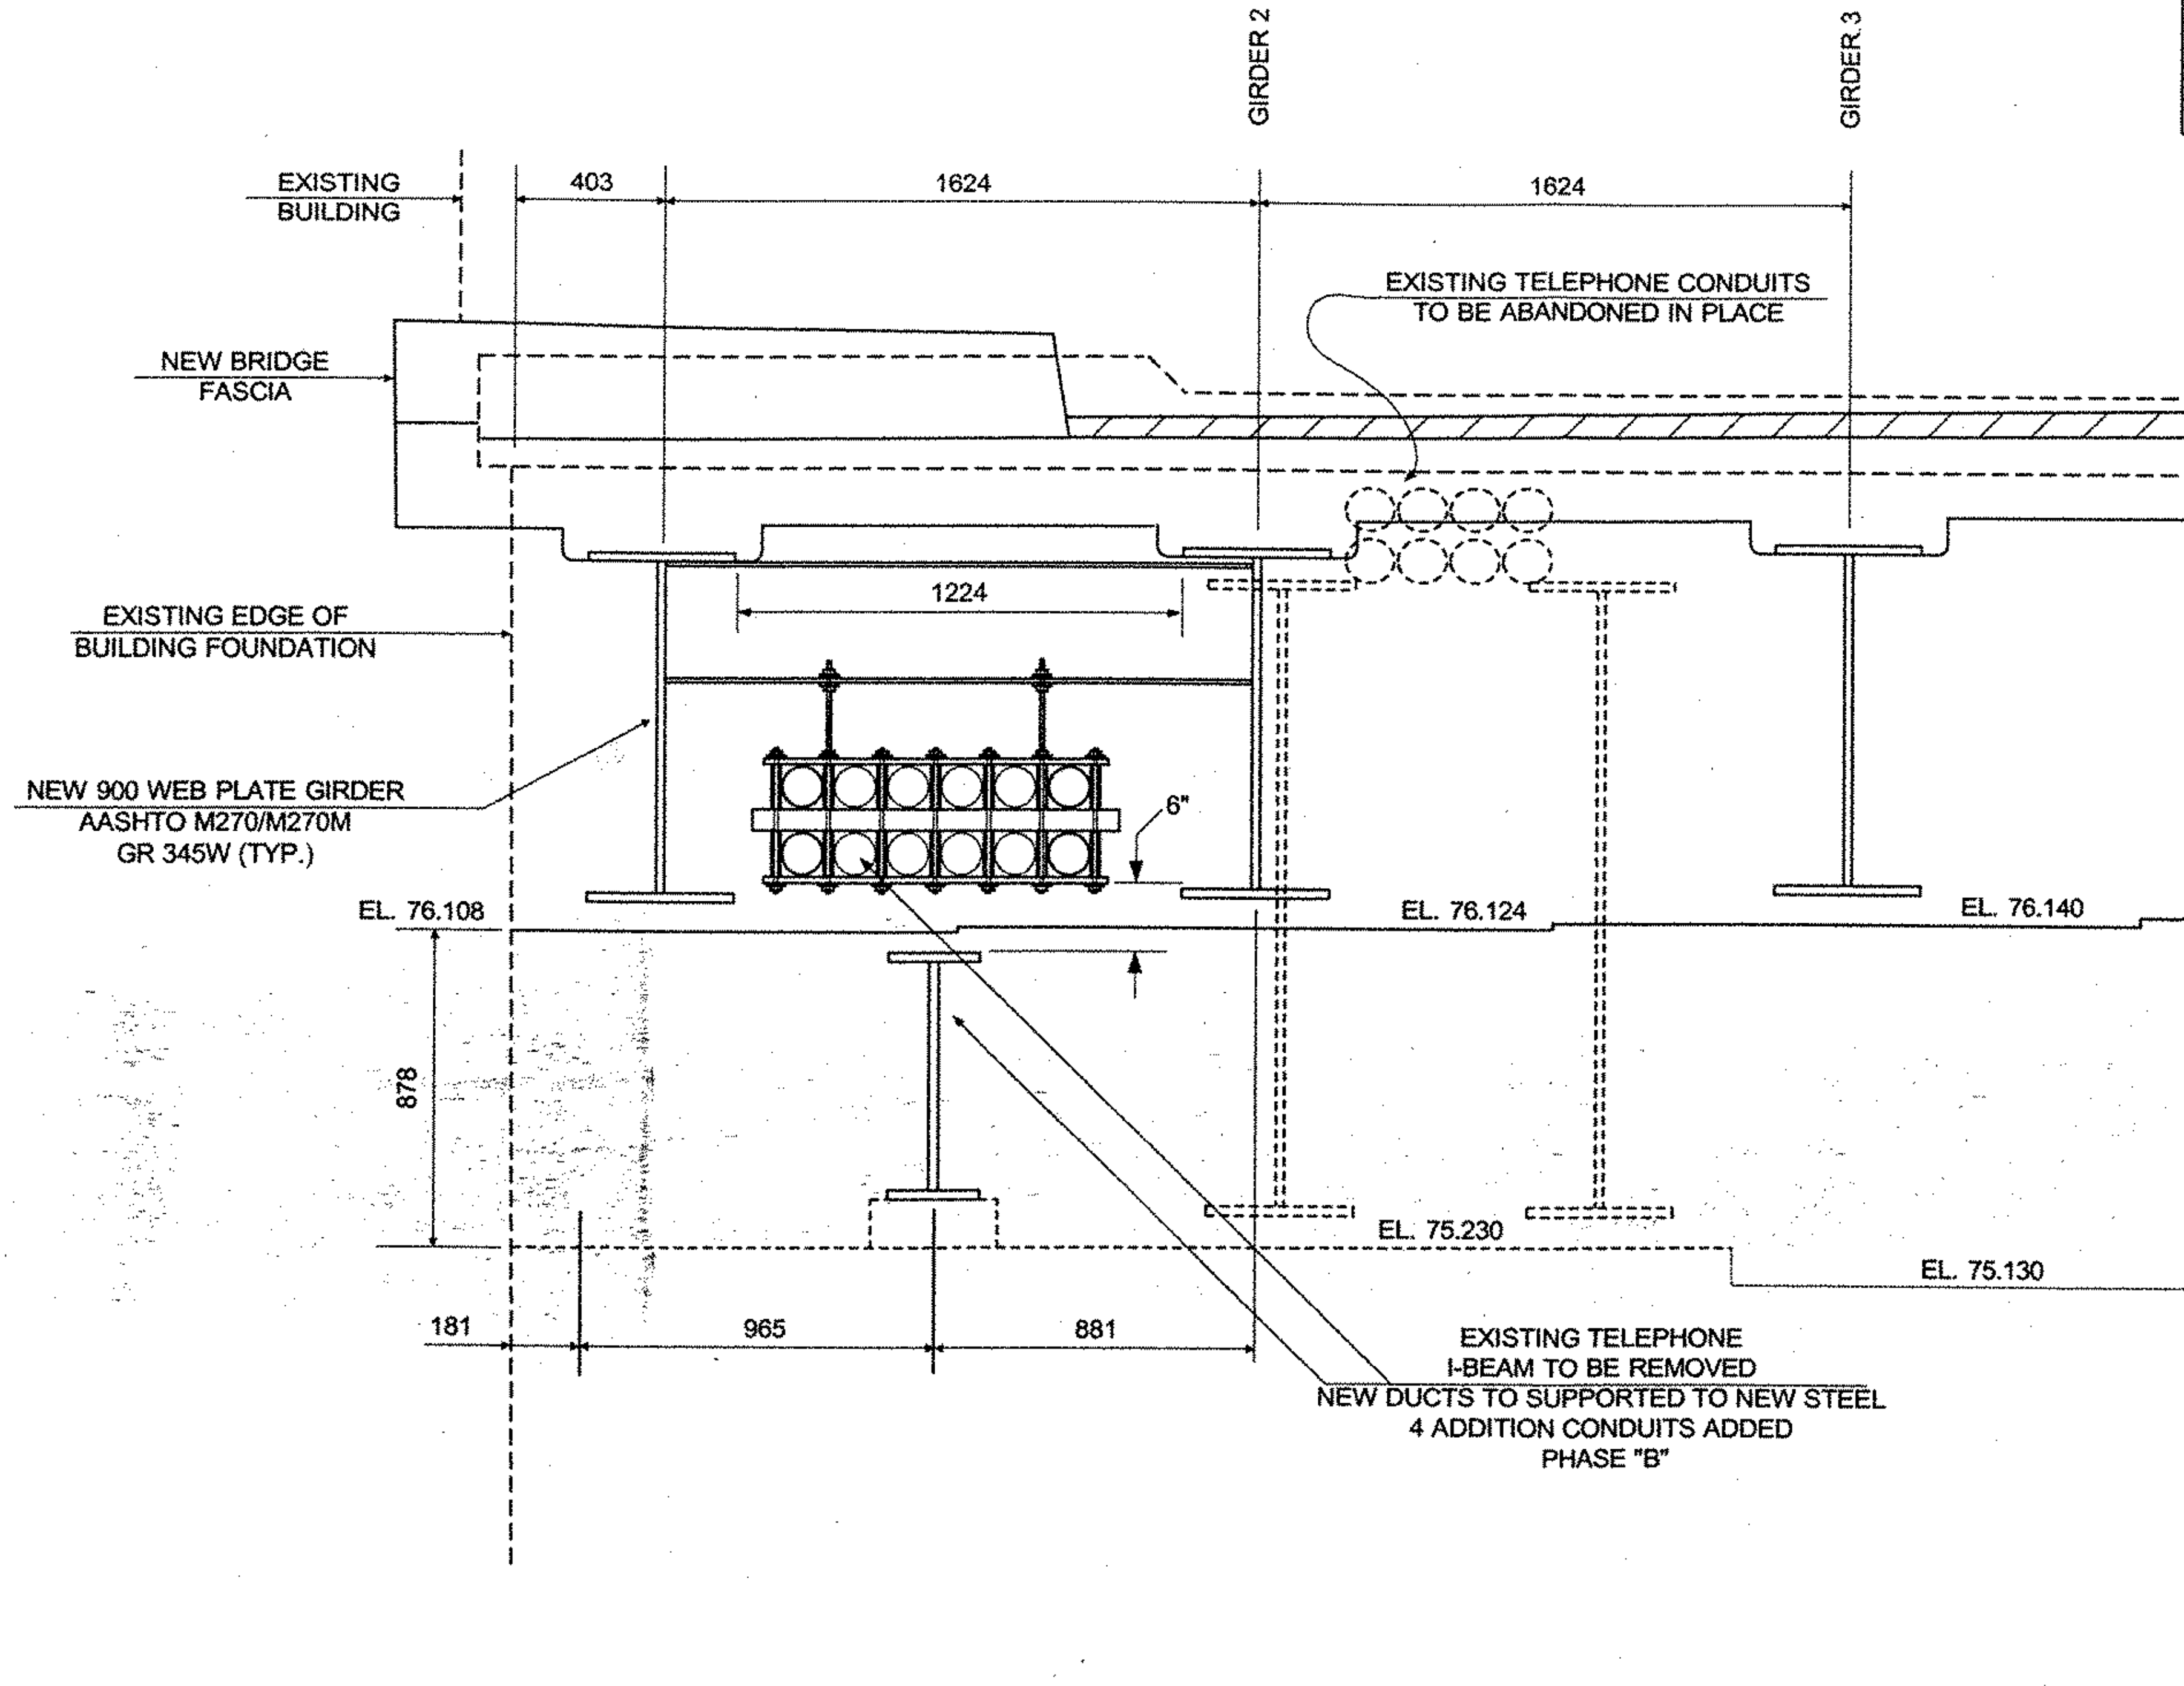


WORK ORDER

7AA01S **VERIZON**

Notice: Not for Use/disclosure outside of VERIZON without written agreement

	SAFETY NOTES: INPUT	MOD/REV NO.	DATE	EWO NO. 7AA01S
	SIGNATURE DATE	PRINT 15 OF		
	PREPARED BY: NEIL E. SNYDER			
	C.O. /EXCHANGE NAME: BRATTLEBORO			
PRE CT YES <input type="checkbox"/> NO <input checked="" type="checkbox"/>	UNDERGROUND	RECORD REF: INPUT		
PRIMARY VOLTAGE TO GROUND 7.2 KV MGN SYSTEM	BLOCK (NYT)	C.O. /EXCHANGE CODE: 4731		
CABLE PRESS. UNDER PRESS. YES <input type="checkbox"/> NO <input checked="" type="checkbox"/>	CONDUIT	MUNICIPALITY: BRATTLEBORO		
TRANSMISSION 26GA LIMIT YES <input type="checkbox"/> NO <input checked="" type="checkbox"/>	AMT. BRIDGE TAP	MANHOLE LOCATION MH# NA KF		



EXISTING AND PROPOSED TELEPHONE FACILITIES @ ABUTMENT NO. 2, LEFT SIDE
PHASE "B"

