

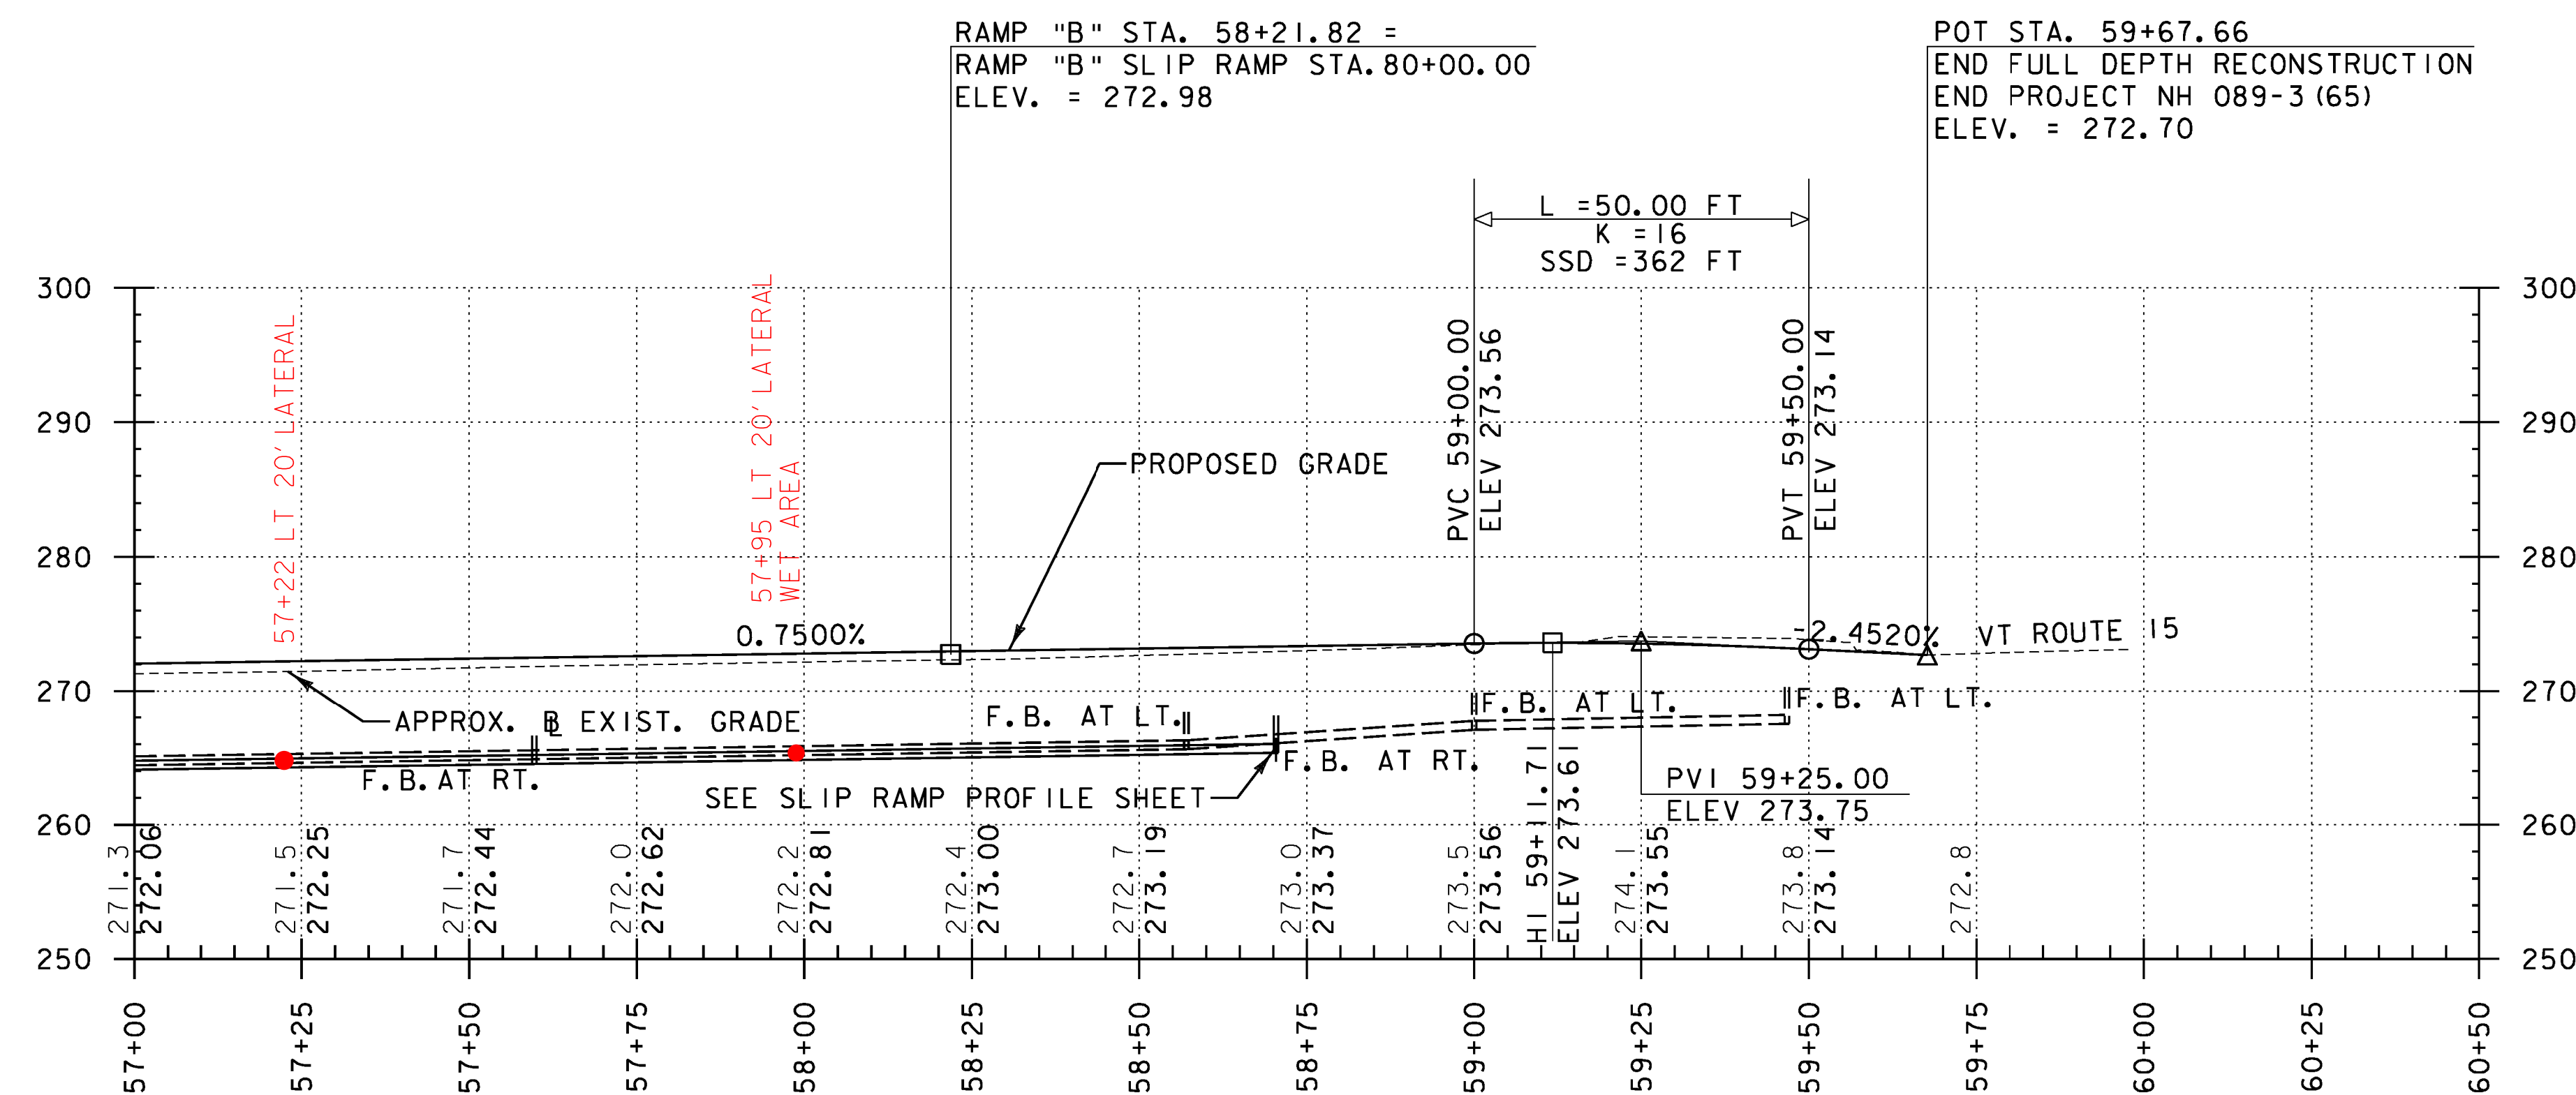


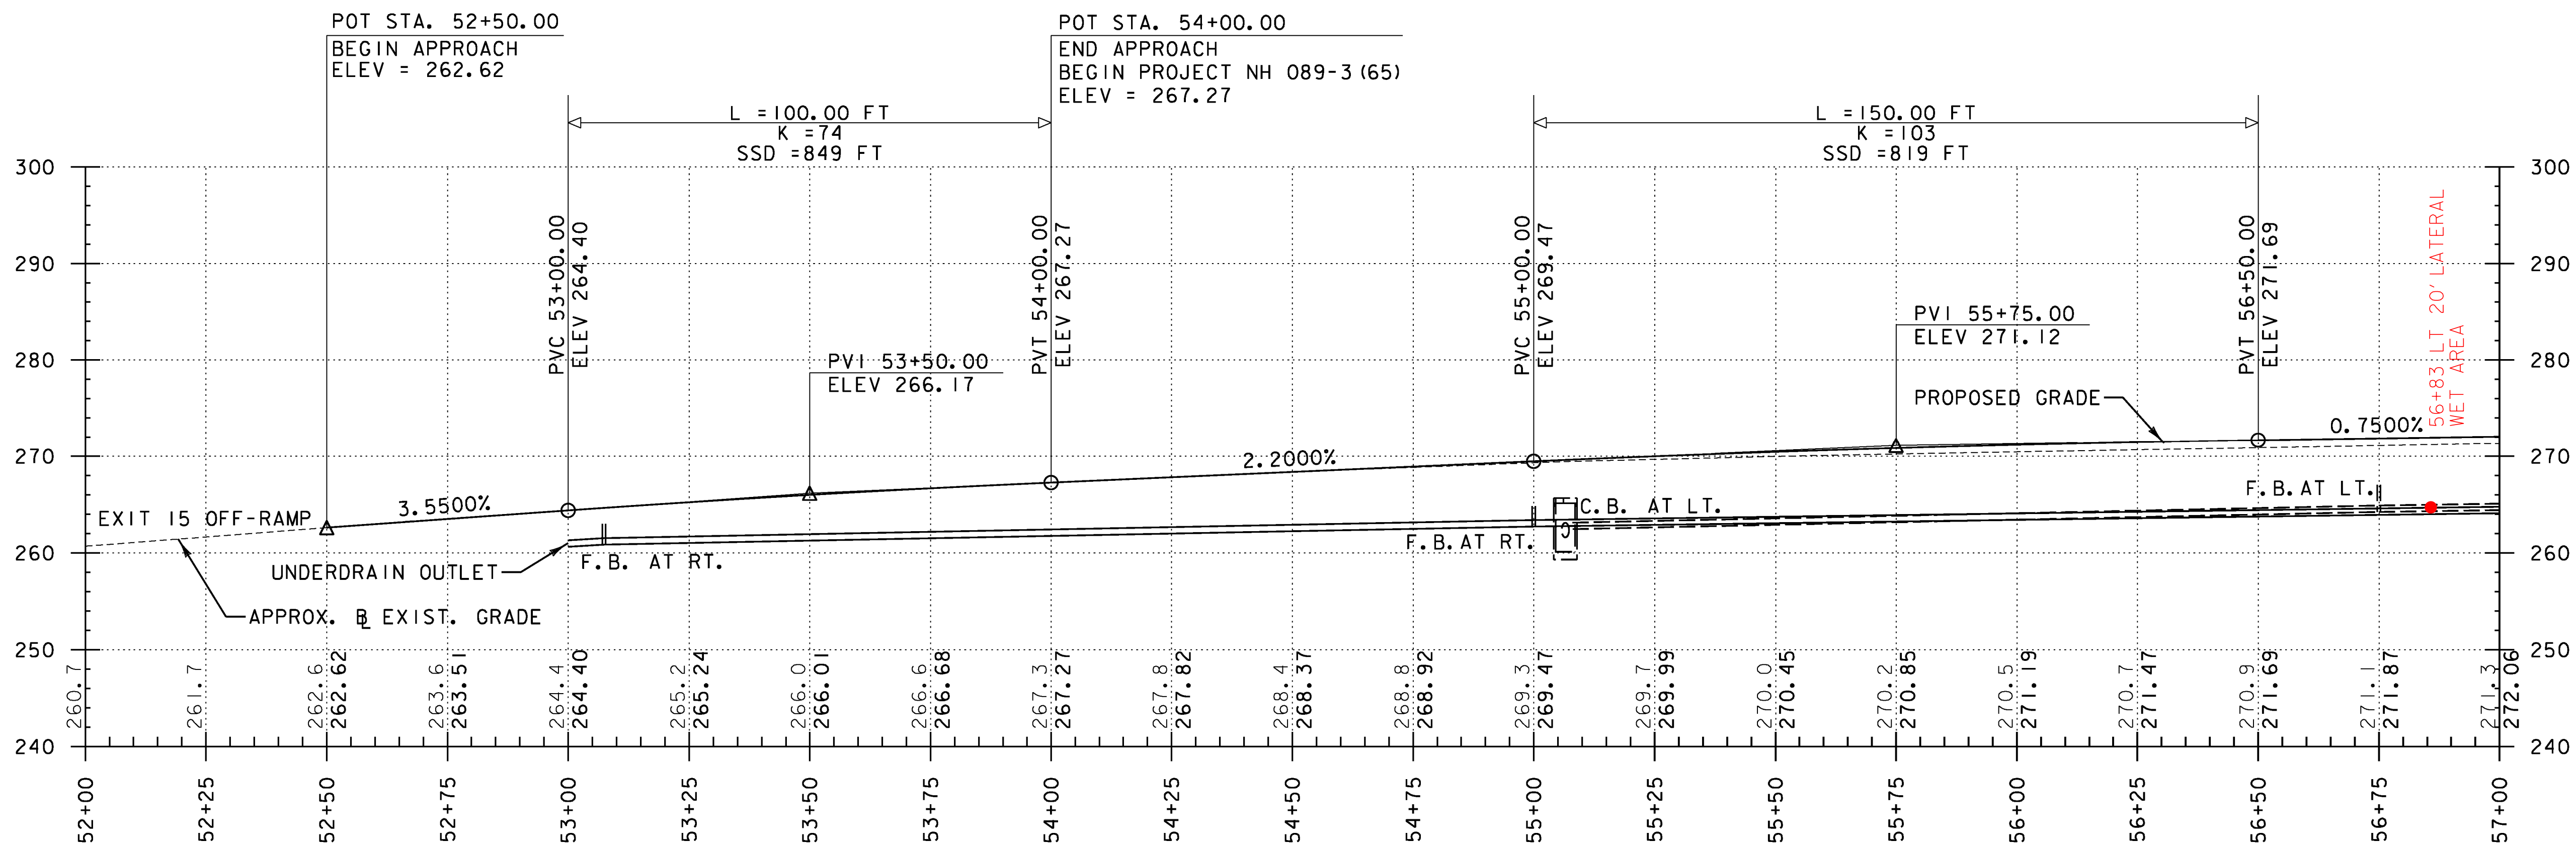

LEGEND	
	UNDERDRAIN ON RIGHT
	UNDERDRAIN ON LEFT
	F.B. FLUSHING BASIN
	C.B. CATCH BASIN
	LT. LEFT
	RT. RIGHT

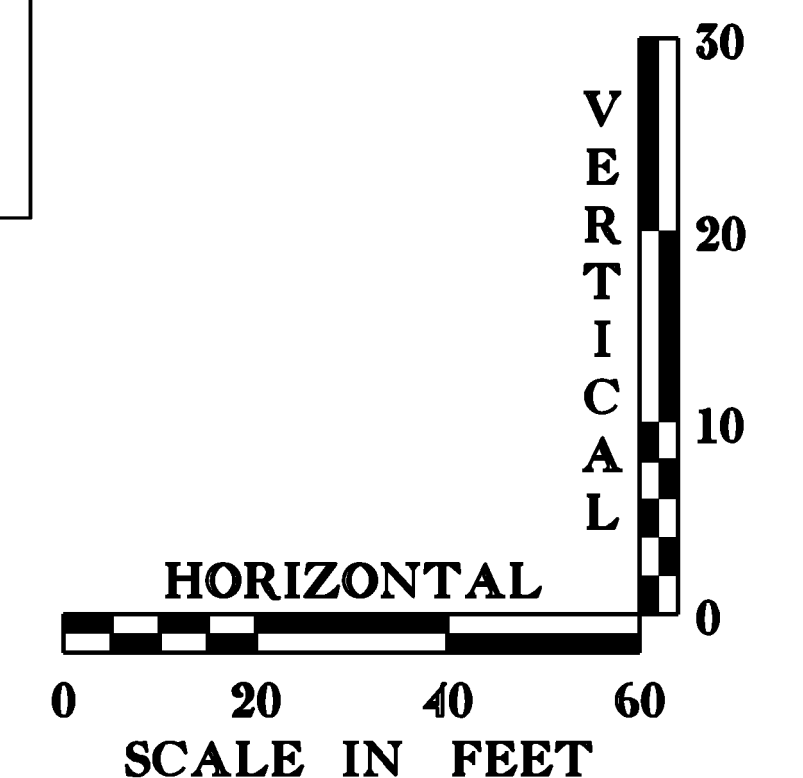

THE GRADES SHOWN TO THE NEAREST TENTH ARE THE ORIGINAL GROUND ELEVATIONS ALONG THE PROPOSED ALIGNMENT. THE GRADES SHOWN TO THE NEAREST HUNDREDTH ARE THE PROPOSED PROFILE GRADES FOR THE NEW ALIGNMENT.

PROJECT NAME: WINOOSKI	
PROJECT NUMBER: NH 089-3(65)	
FILE NAME: z94d198xsl.dgn	PLOT DATE: 2/22/2010
PROJECT LEADER: KEN UPMAL	DRAWN BY: A. ACHARYA
DESIGNED BY: A. ACHARYA	CHECKED BY: E. ATKINS
RAMP "B" PROFILE SHEET	SHEET 21 OF 67