


LEGEND	
=====	UNDERDRAIN ON RIGHT
-----	UNDERDRAIN ON LEFT
F.B.	FLUSHING BASIN
C.B.	CATCH BASIN
LT.	LEFT
RT.	RIGHT

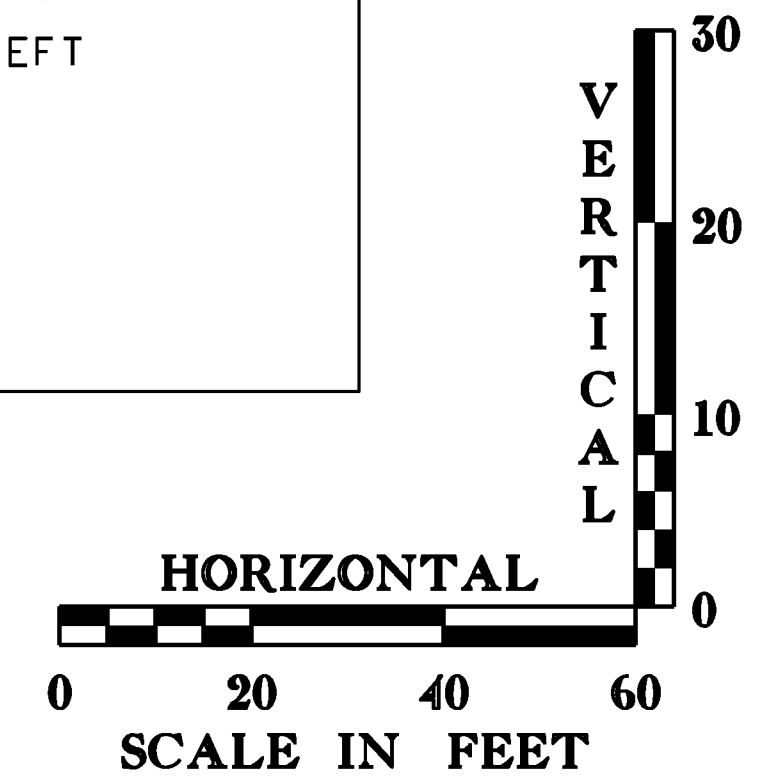

THE GRADES SHOWN TO THE NEAREST TENTH ARE THE ORIGINAL GROUND ELEVATIONS ALONG THE PROPOSED ALIGNMENT. THE GRADES SHOWN TO THE NEAREST HUNDREDTH ARE THE PROPOSED PROFILE GRADES FOR THE NEW ALIGNMENT.

PROJECT NAME: WINOOSKI	PLOT DATE: 2/22/2010
PROJECT NUMBER: NH 089-3(65)	DRAWN BY: A. ACHARYA
FILE NAME: z94a198xsl.dgn	CHECKED BY: E. ATKINS
DESIGNED BY: A. ACHARYA	SHEET 22 OF 67
SLIP RAMP PROFILE SHEET	