

EXISTING DRAINAGE

EXISTING DRAINAGE

EXISTING DRAINAGE

NEW DRAINAGE

8 INCH UNDERDRAIN


- 2 VT RTE 15 16+91.5 RT ~ VT RTE 15 15+86.2 RT
EXISTING PIPE ~ RETAIN
- 3 VT RTE 15 15+84.1LT
EXISTING DI ~ RETAIN
- 4 VT RTE 15 16+91.6 LT~VT RTE 15 16+91.5 RT
EXISTING PIPE ~ RETAIN
EXISTING DI @ VT RTE 15 16+91.6 LT ~ RETAIN

- 5 VT RTE 15 19+21.4 RT ~ VT RTE 15 16+91.5 RT
EXISTING PIPE ~ RETAIN
EXISTING DI @ VT RTE 15 16+91.5 RT ~ REHAB
- 6 VT RTE 15 19+21.2 LT ~ VT RTE 15 19+21.4 RT
EXISTING PIPE ~ RETAIN
EXISTING DI @ VT RTE 15 19+21.2 LT ~ RETAIN
- 7 VT RTE 15 20+42.7 RT~VT RTE 15 19+21.4 RT
EXISTING PIPE ~ RETAIN
EXISTING DI @ VT RTE 15 19+21.4 RT ~ REHAB.

- 8 VT RTE 15 20+67.2 LT ~ VT RTE 15 20+42.7 RT
EXISTING PIPE AND DI ~ RETAIN
- 9 SLIP RAMP 81+87.2 RT ~ SLIP RAMP 81+40.9 RT
EXISTING PIPE AND DI @ 81+87.2 RT ~ REMOVE
- 10 SLIP RAMP 81+40.9 RT~VT RTE 15 16+91.5 RT
EXISTING DI @ 81+40.9 RT ~ REMOVE

- 2 SLIP RAMP 81+87.3 RT ~ SLIP RAMP 81+40.9 RT
NEW 18" X 36" RCP/CPEP (SL) W/CB @ SLIP RAMP 81+87.3 RT
- 3 SLIP RAMP 81+40.9 RT ~ VT RTE 15 16+91.5 RT
NEW 18" X 54" RCP/CPEP (SL) W/CB @ SLIP RAMP 81+40.9 RT
NEW CONNECTION TO EXISTING DI @ VT RTE 15 16+91.5 RT

- SLIP RAMP 80+60.2 RT~RAMP "B" 57+59.7 RT
NEW 8"x11" UNDERDRAIN W/ FB
@ SLIP RAMP 80+60.2 RT
- SLIP RAMP 81+40.9 RT~SLIP RAMP 80+60.2 RT
NEW 8"x66" UNDERDRAIN W/
UNDERDRAIN FLUSHING ACCESS @ CB SLIP RAMP 81+40.9 RT
- RAMP "B" 58+59.0 LT ~ RAMP "B" 56+75.0 LT
NEW 8"x184" UNDERDRAIN W/ FB
@ RAMP "B" 58+59.0 LT
- RAMP "B" 58.98.3 LT~RAMP "B" 58+59.0 LT
NEW 8"x42" UNDERDRAIN W/ FB
@ RAMP "B" 59+00.0 LT
- RAMP "B" 59+46.7 LT ~RAMP "B" 59+00.0 LT
NEW 8"x46" UNDERDRAIN W/ FB
@ RAMP "B" 59+46.7 LT

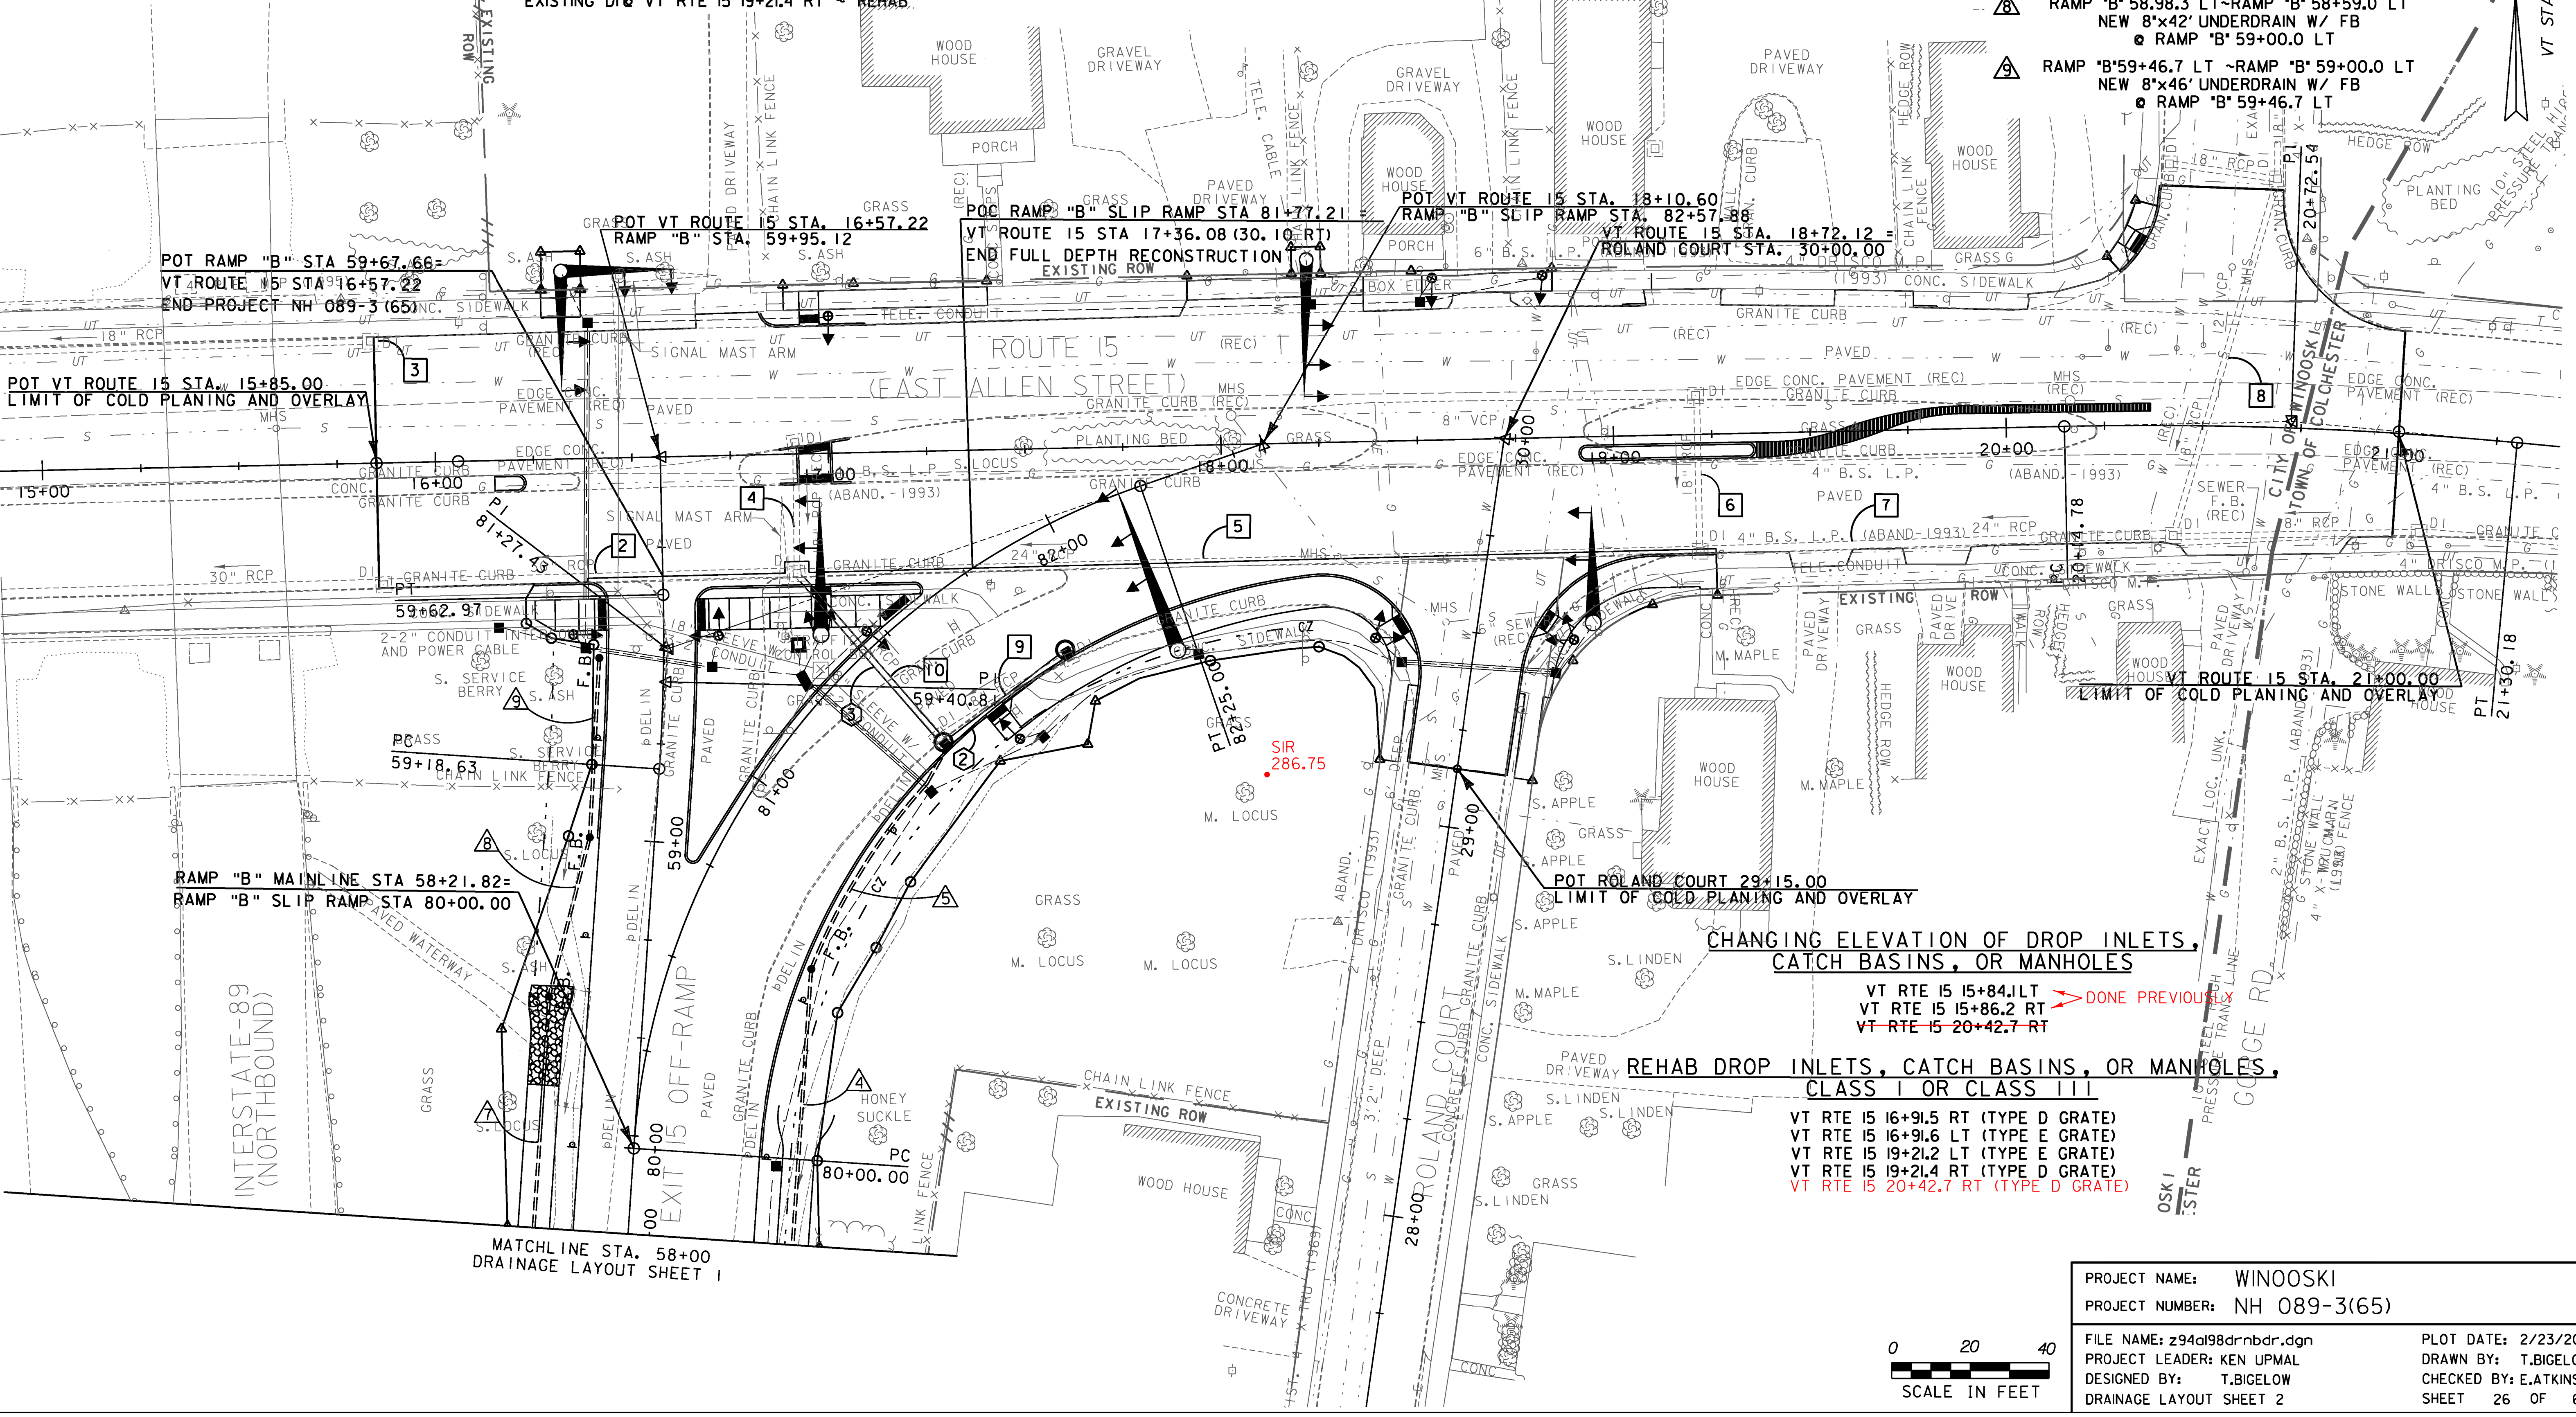


CHANGING ELEVATION OF DROP INLETS, CATCH BASINS, OR MANHOLES

VT RTE 15 15+84.1LT
VT RTE 15 15+86.2 RT
VT RTE 15 20+42.7 RT

REHAB DROP INLETS, CATCH BASINS, OR MANHOLES, CLASS I OR CLASS III

VT RTE 15 16+91.5 RT (TYPE D GRATE)
VT RTE 15 16+91.6 LT (TYPE E GRATE)
VT RTE 15 19+21.2 LT (TYPE E GRATE)
VT RTE 15 19+21.4 RT (TYPE D GRATE)
VT RTE 15 20+42.7 RT (TYPE D GRATE)

MATCHLINE STA. 58+00
DRAINAGE LAYOUT SHEET 1

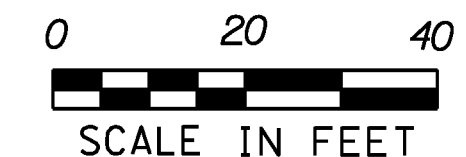

PROJECT NAME:	WINOOSKI	FILE NAME:	z94a198drnldr.dgn	PLOT DATE:	2/23/2010
PROJECT NUMBER:	NH 089-3(65)	PROJECT LEADER:	KEN UPMAL	DRAWN BY:	T.BIGELOW
		DESIGNED BY:	T.BIGELOW	CHECKED BY:	E.ATKINS
		DRAINAGE LAYOUT SHEET 2		SHEET	26 OF 67