


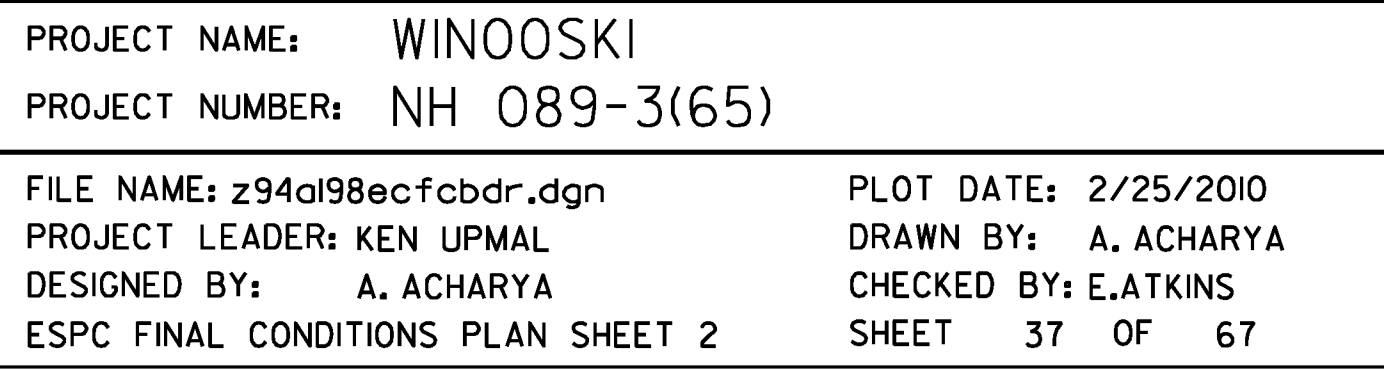

NOTE:
SEE CROSS SECTIONS AND PARTIAL GRADING PLAN (SHEET 23) FOR ADDITIONAL GRADING