

BEGIN R.O.W. PROJECT  
NHG SGNL(26)S STA. 0+123.0 10.5 M LT. [34.4']




BEGIN NHG SGNL(26)S  
BEGIN ADAS(2)  
U.S. ROUTE 7  
WALLINGFORD  
STA. 0+118

LIMIT OF WORK  
STA. 1+055

GILBERT HART LIBRARY  
ASSOCIATION

PERRY, JOHN O.  
& REVA A.

END NHG SGNL(26)S  
END ADAS(2)  
U.S. ROUTE 7  
WALLINGFORD  
STA. 0+176

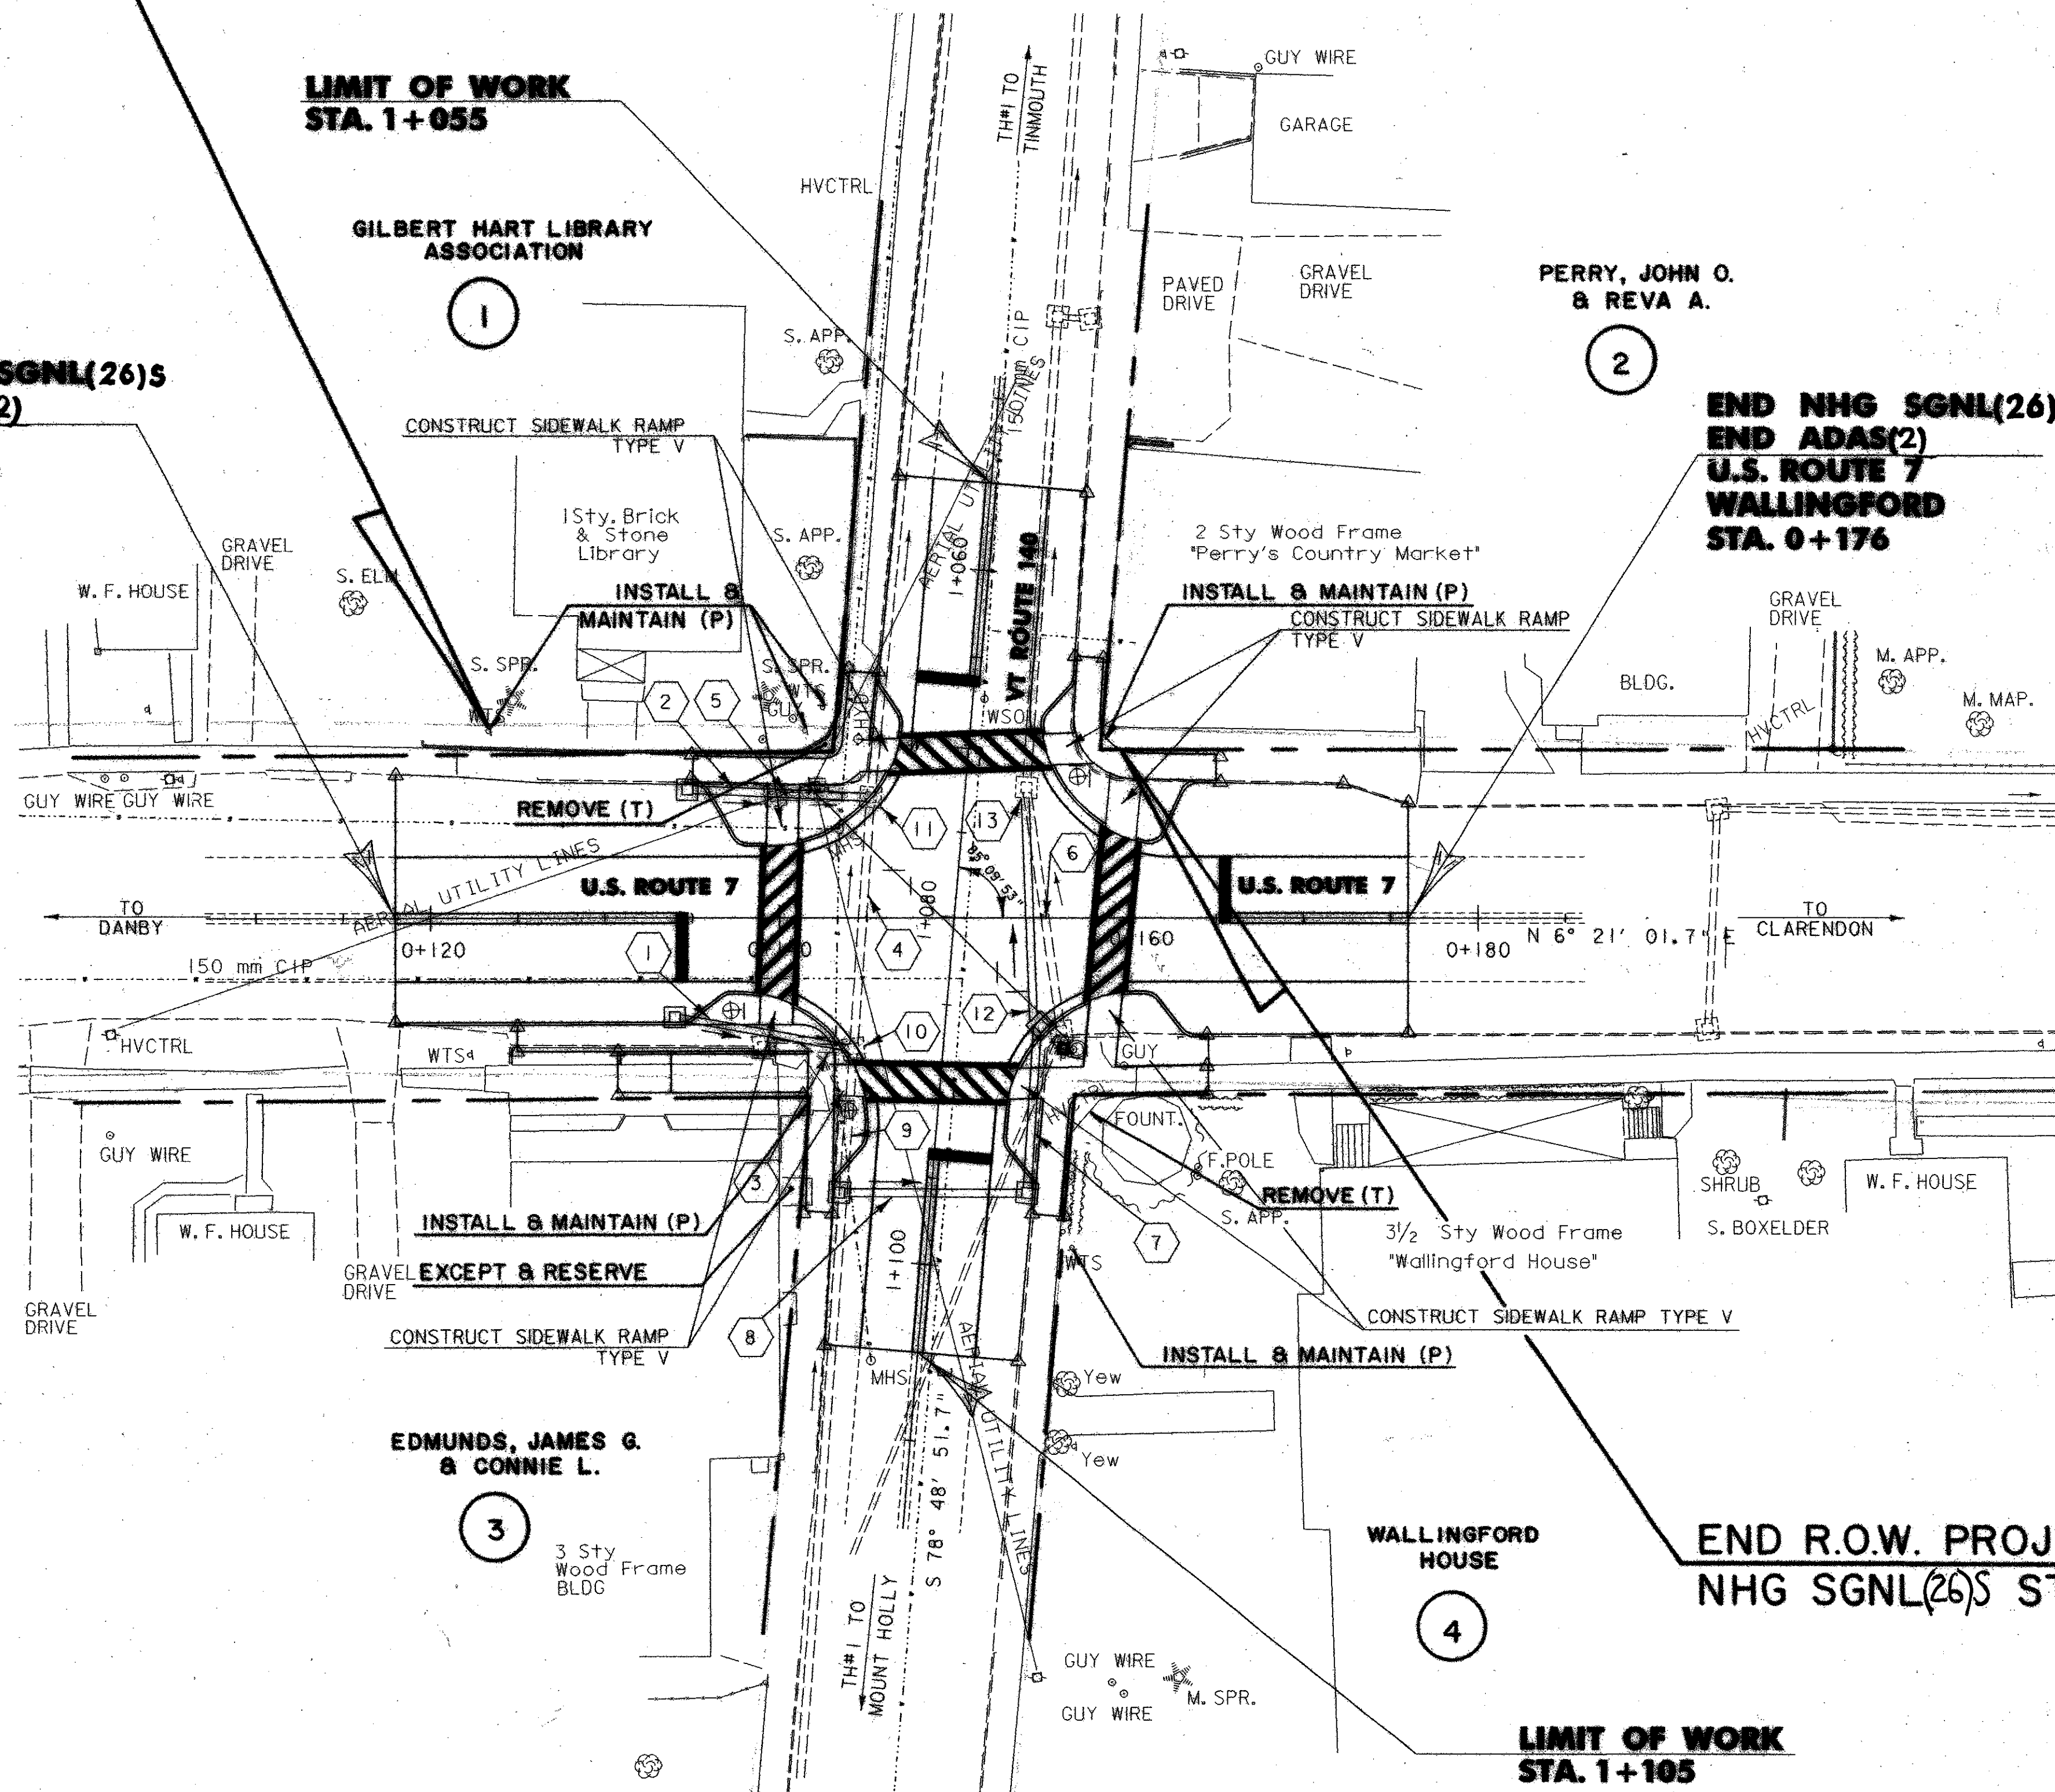

- 1 CONST. @ 0+134.0 TO 0+144.24, RT.  
NEW 450 mm X 10 m OPTION PIPE
- 2 CONST. @ 0+134.70 TO 0+145.21, LT.  
NEW 450 mm X 10 m OPTION PIPE
- 3 CONST. @ 0+139.03 TO 0+144.24, RT.  
REMOVE EXIST. 375 mm RCP AND RCDI @ INLET  
(STA. 0+139.5 RT.)
- 4 CONST. @ 0+144.75, @  
RETAIN EXIST. 450 mm RCP
- 5 CONST. @ 0+139.73 TO 0+145.21, LT.  
REMOVE EXIST. 450 mm RCP & RCDI @ INLET  
(STA. 0+139.8 LT.)
- 6 CONST. @ 0+154.13 LT. TO 0+156.10, RT.  
REMOVE EXIST. 450 mm RCP & RCDI @ INLET  
(STA. 0+157.10 RT.)
- 7 VT ROUTE 140 CONST. @ 1+085.76 TO 1+095.39, LT.  
NEW 450 mm X 9 m OPTION PIPE
- 8 VT ROUTE 140 CONST. @ 1+095.39, LT. TO 1+096.26, RT.  
NEW 450 mm X 11 m OPTION PIPE
- 9 VT ROUTE 140 CONST. @ 1+087.99 TO 1+096.99, RT.  
REMOVE 9 m OF EXIST. 450 mm RCP
- 10 CONST. @ 0+144.24, RT.  
REHAB EXISTING RCDI, ADJUST TOP TO FACE OF CURB
- 11 CONST. @ 0+145.21, LT.  
REHAB EXISTING RCDI, ADJUST TOP TO FACE OF CURB.
- 12 CONST. @ 0+154.13, LT. TO 0+155.00, RT.  
NEW 450 mm X 14 m OPTION PIPE
- 13 CONST. @ 0+154.13, LT.  
REHAB EXISTING RCDI


NOTES:

- 1. THIS PLAN DOES NOT SHOW EXISTING WATER LINES OR REFLECT THE WATER SYSTEM IMPROVEMENTS. REFER TO THE PLANS TITLED WATER SYSTEM IMPROVEMENTS FOR THE WALLINGFORD FIRE DISTRICT #1 ATTACHED.
- 2. SEE SHEET 13 FOR BULB-OUT DETAILS.

END R.O.W. PROJECT  
NHG SGNL(26)S STA. 0+158.2 9.8 M LT. [32.2']

LIMIT OF WORK  
STA. 1+105

DATUM	
VERTICAL	NAVD 88
HORIZONTAL	NAD 83 (92)

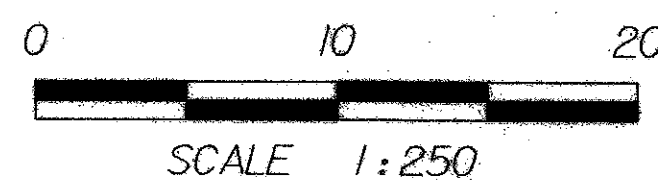

<b>PROJECT LAYOUT</b>	PROJECT: <b>WALLINGFORD</b>	PROJECT NO.: <b>NHG SGNL (26)S STP ADAS (2)</b>
	DESIGN FILE NAME:	PLOT DATE: 14 JUN 99
	IPARM FILE NAME:	SURVEYED BY: VAOT
	DESIGNED BY: GAS/GAE	DRAWN BY: W-M
	R.O.W. SHEET 8 OF 8 SHEETS	SHEET 2 OF 25 SHEETS

Scale\_r3