

DURABLE 600 mm STOP BAR
1+070 RT.



REMOVAL OF EXISTING PAVEMENT MARKINGS
1+061.0 - 1+089.5 RT

DURABLE LETTER OR SYMBOL
1+051.4 RT. "HANDICAPPED"
1+055.4 RT. "HANDICAPPED"
1+059.3 RT. "HANDICAPPED"
1+063.3 RT. "HANDICAPPED"
1+068.2 RT. "HANDICAPPED"
1+081.5 RT. "ARROW A /- ARROW B"
1+082.5 RT. "ARROW A"
1+082.5 RT. "ONLY"
1+112.5 RT. "ARROW B"
1+112.5 RT. "ARROW B"
1+154.5 LT. "ARROW B"
1+154.5 RT. "ARROW B"

DURABLE 100 mm WHITE LINE
ALL PAVEMENT MARKINGS
UNLESS OTHERWISE NOTED.

DURABLE 100 mm YELLOW LINE
1+076.3 - 1+079.9 RT (DOUBLE CENTERLINE)

SEE STANDARD E-191 FOR
LETTER OR SYMBOL DETAILS

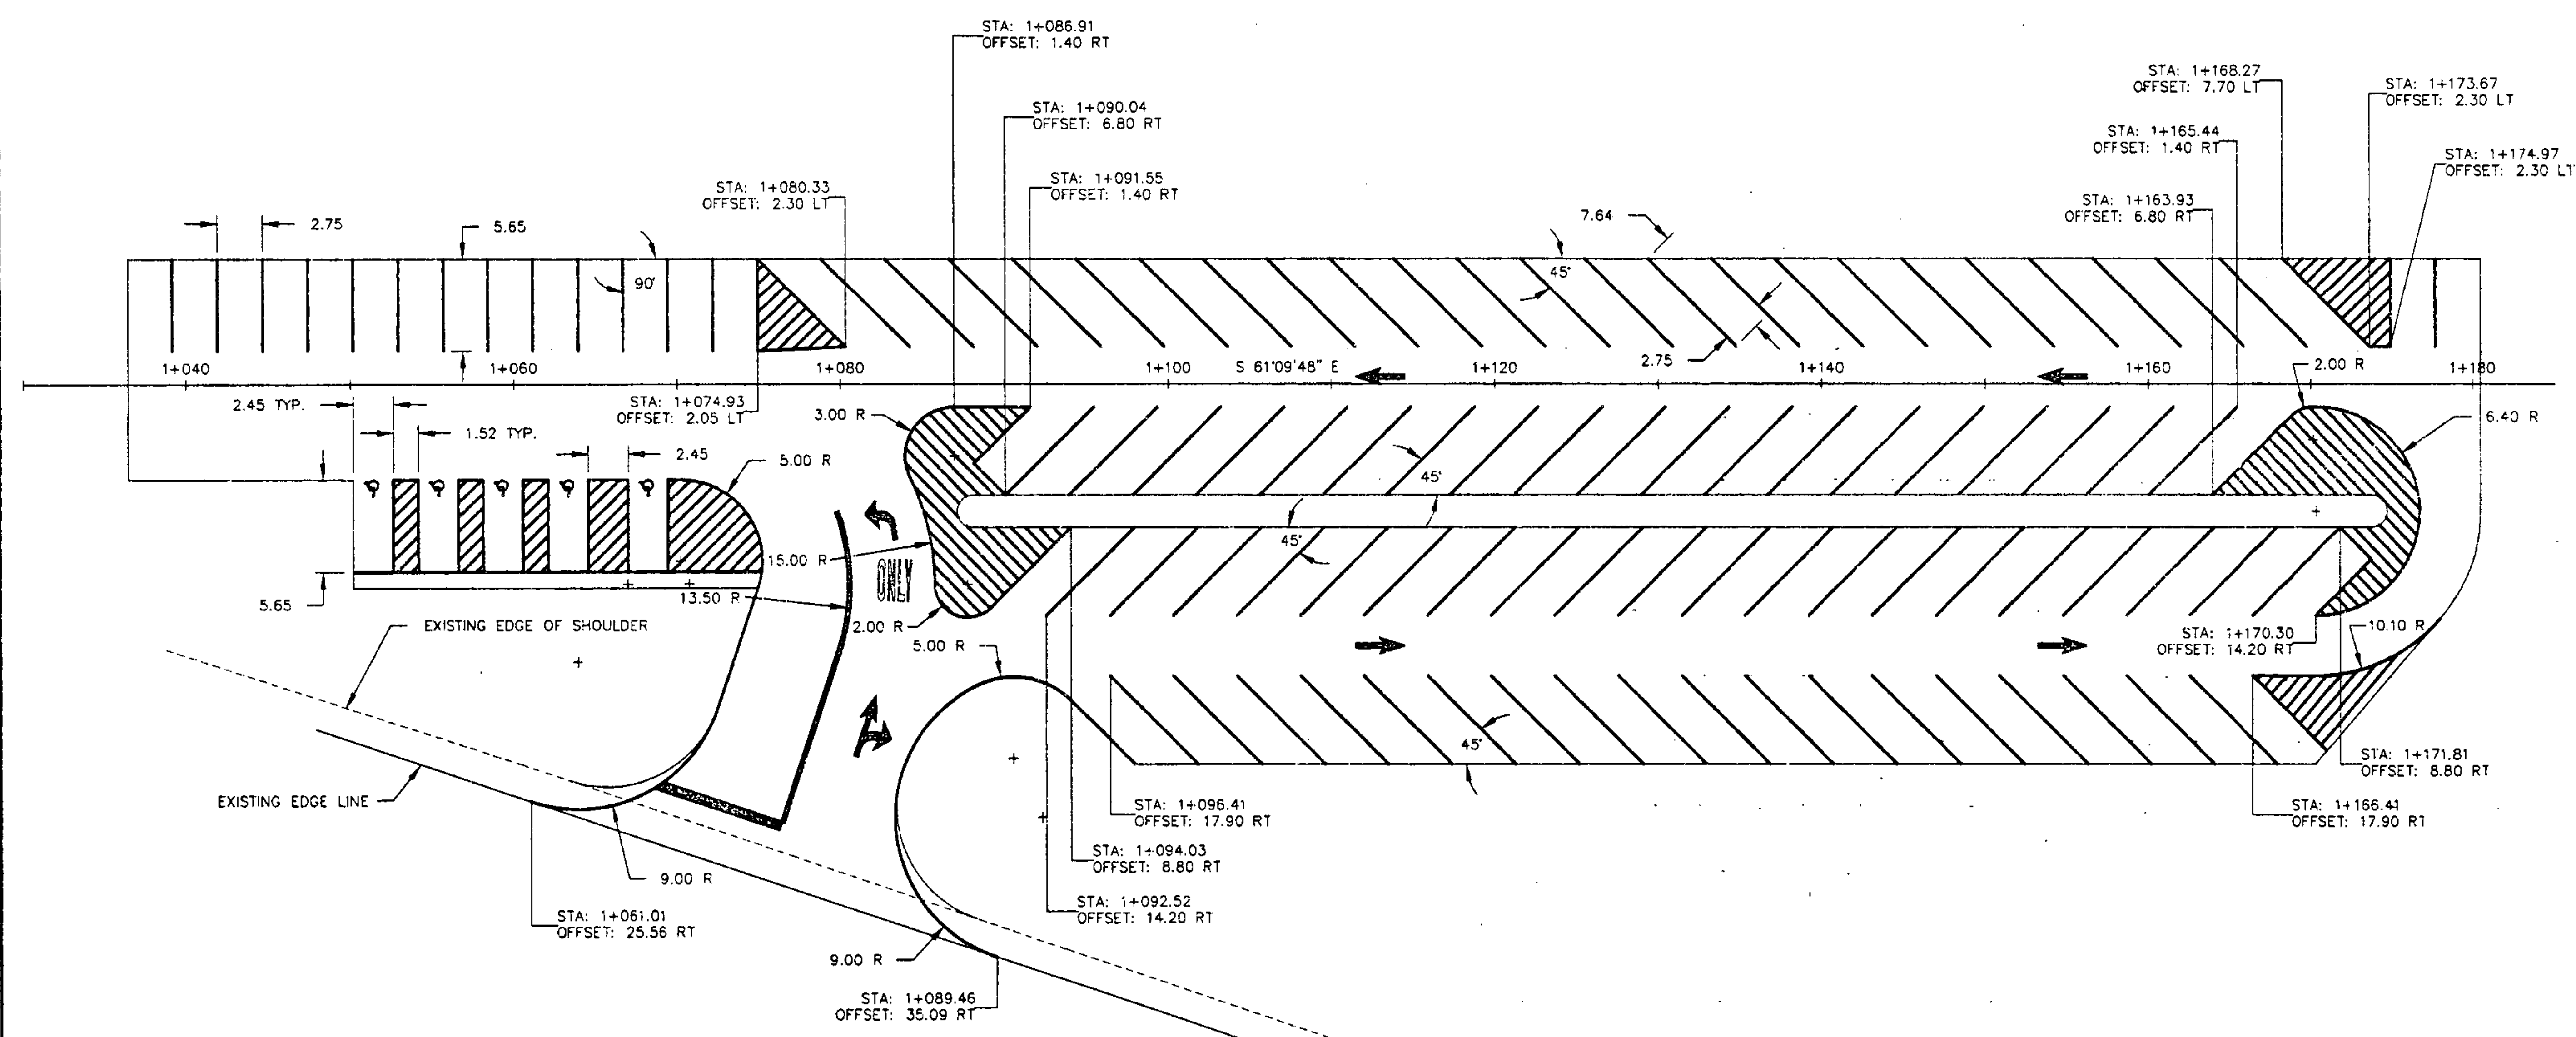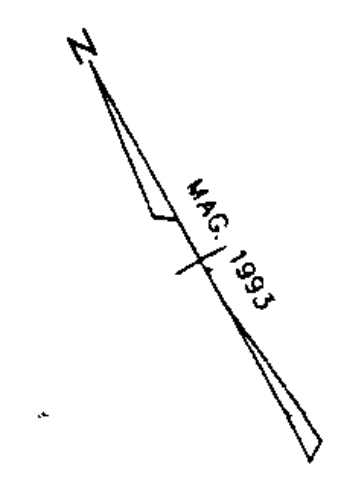

DATUM
VERTICAL NAVD88(meters)
HORIZONTAL N/A



ALL DIMENSIONS IN METERS
UNLESS OTHERWISE NOTED

PAVEMENT MARKING PLAN	PREPARED BY VSE DATE 12/95
	CHECKED BY VSE DATE 12/95
	DESIGN SUPERVISOR GAK DATE 12/95
	PROJ. RICHMOND CMG PARK(4)
SHEET 9 OF 22 SHEETS	