

HAY BALES FOR EROSION CONTROL
59 AS SHOWN

EVERGREEN SHRUBS

- 1+056.8, 14.9 RT.
- 1+061.2, 14.9 RT.
- 1+065.6, 14.9 RT.
- 1+070.8, 16.9 RT.
- 1+089.4, 7.8 RT.
- 1+090.4, 21.0 RT.
- 1+094.3, 7.8 RT.
- 1+099.2, 7.8 RT.
- 1+104.0, 7.8 RT.
- 1+108.9, 7.8 RT.
- 1+113.8, 7.8 RT.
- 1+118.7, 7.8 RT.
- 1+123.5, 7.8 RT.
- 1+128.4, 7.8 RT.
- 1+133.2, 7.8 RT.
- 1+138.2, 7.8 RT.
- 1+143.1, 7.8 RT.
- 1+147.9, 7.8 RT.
- 1+152.7, 7.8 RT.
- 1+157.6, 7.8 RT.
- 1+162.5, 7.8 RT.
- 1+167.4, 7.8 RT.
- 1+172.3, 7.8 RT.

EVERGREEN TREES

- 1+175.5, 21.5 LT.
- 1+185.1, 19.9 LT.
- 1+193.4, 21.5 LT.
- 1+201.0, 19.0 LT.

DECIDUOUS TREES


- 1+110.1, 29.9 RT.
- 1+125.6, 34.0 RT.
- 1+139.9, 37.3 RT.
- 1+155.8, 38.0 RT.

BEGIN NEW FENCE AT
BRIDGE ABUTMENT

APPROXIMATE LOCATION OF NEW CHAIN-LINK FENCE.
ACTUAL LOCATION TO BE DETERMINED BY THE ENGINEER


HAY BALES ALONG
DITCH (TYP)

BALED HAY EROSION
CHECKS (TYP)

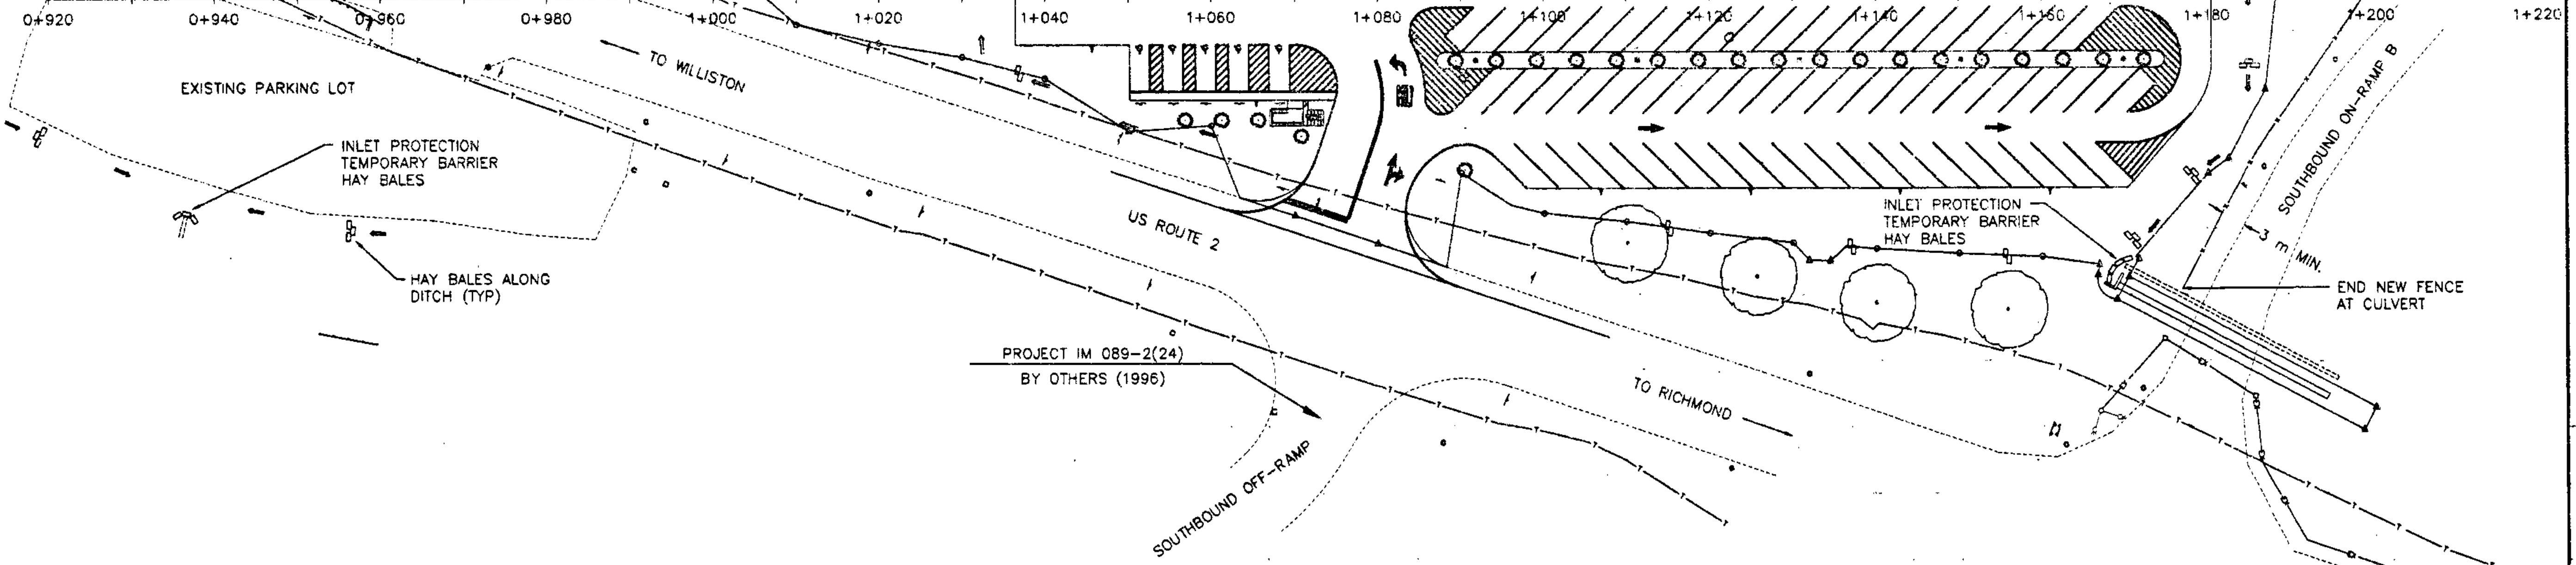

- NOTES:**
1. UPON COMPLETION OF THE GRADING OPERATIONS FOR EARTH SIDESLOPE AREAS, THE CONTRACTOR SHALL IMMEDIATELY ESTABLISH VEGETATION IN ACCORDANCE WITH THE SEEDING REQUIREMENTS ON SHEET 2.
 2. SEE VAOT STANDARD DRAWING T-2 FOR TEMPORARY EROSION CONTROL DETAILS.

DATUM
VERTICAL NAVD88(meters)
HORIZONTAL N/A

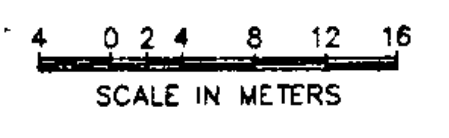

ALL DIMENSIONS IN METERS
UNLESS OTHERWISE NOTED

LANDSCAPING AND EROSION CONTROL PLAN	PREPARED BY <u>VSE</u> DATE <u>3/95</u>
	CHECKED BY <u>VSE</u> DATE <u>3/95</u>
	DESIGN SUPERVISOR <u>GAK</u> DATE <u>3/95</u>
	PROJ. RICHMOND CMG PARK(4)
SHEET <u>13</u> OF <u>22</u> SHEETS	