




1+080

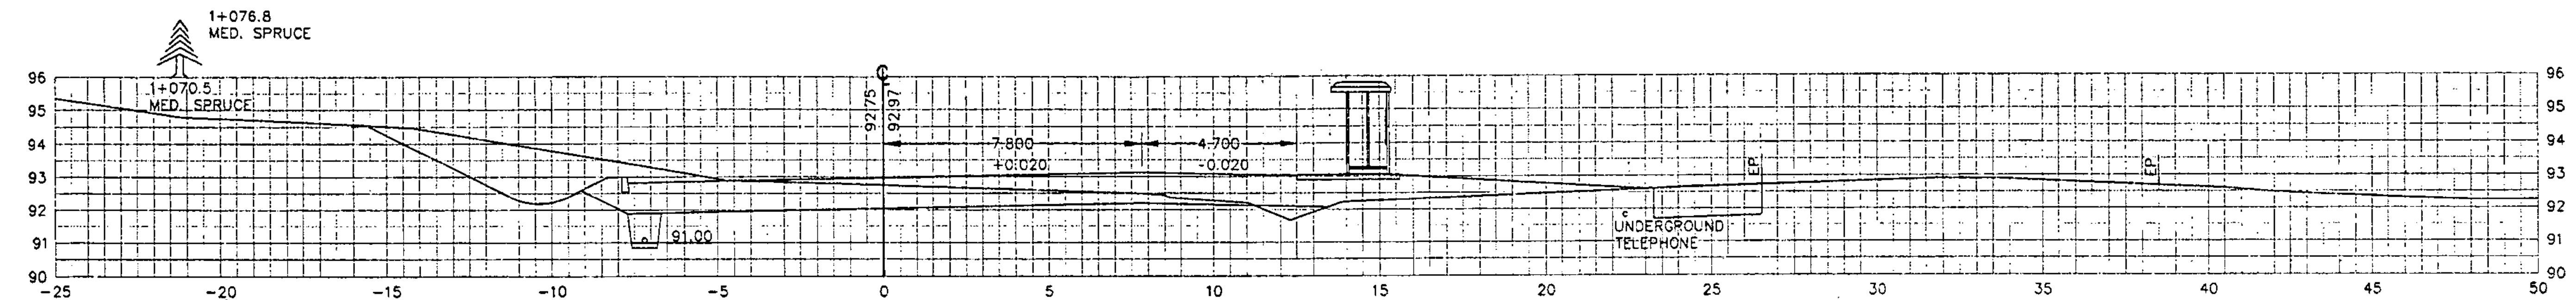

1+070

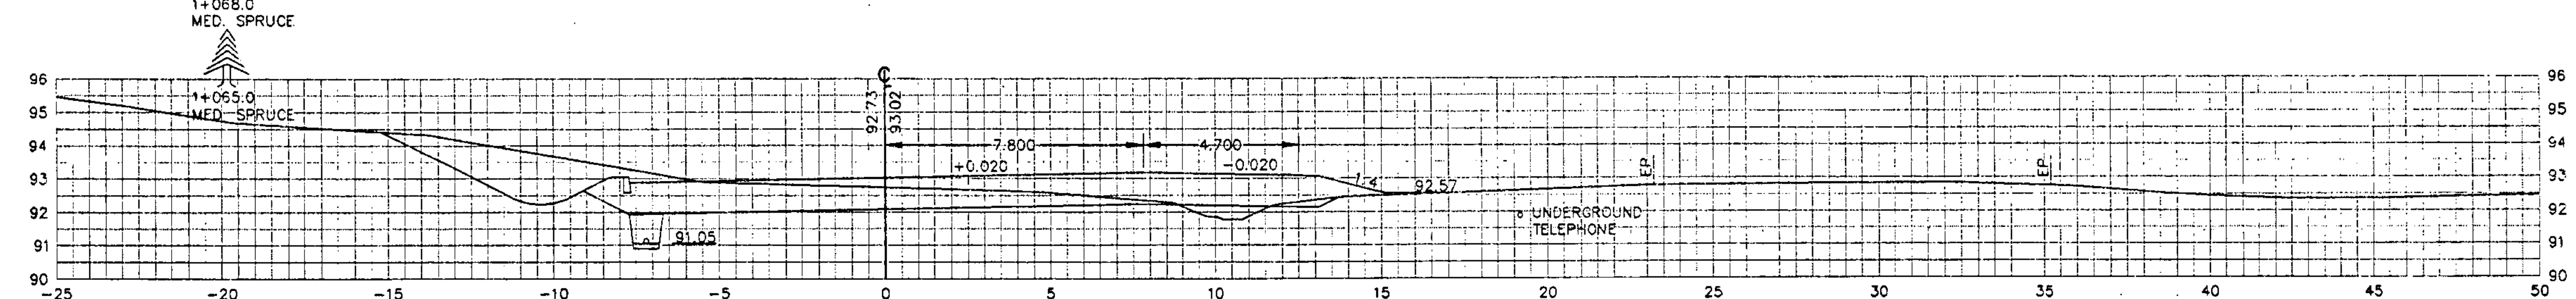

1+060

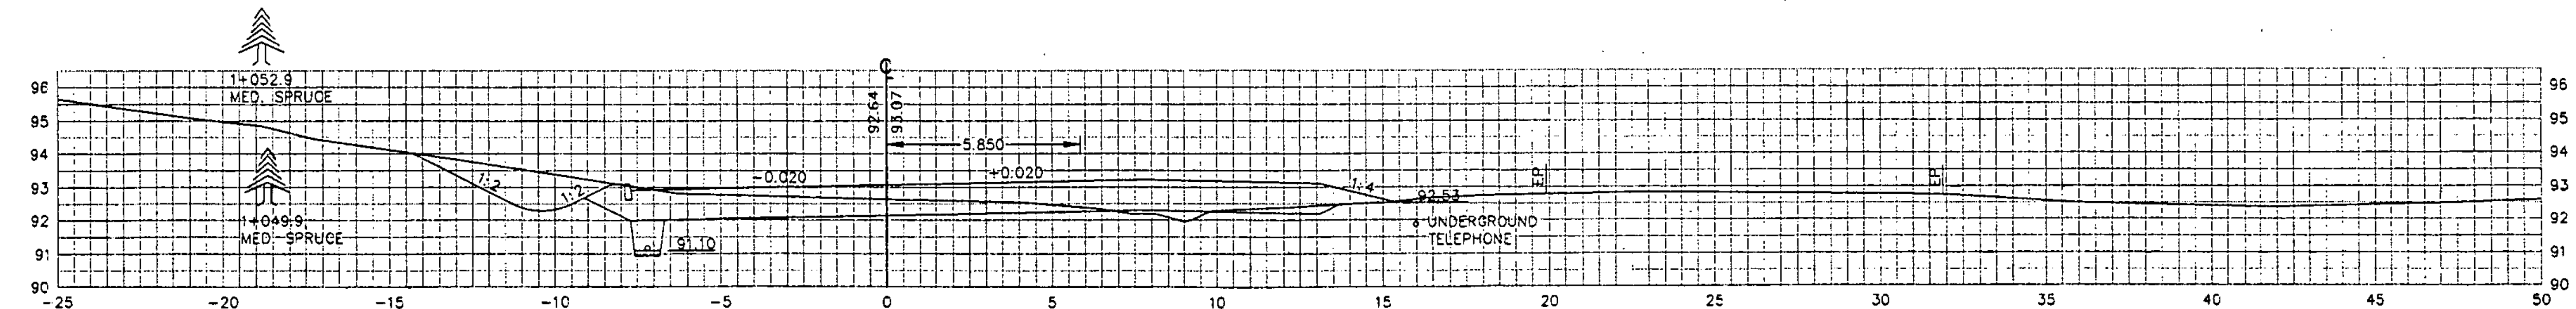

1+050

5 m

CROSS SECTIONS	FROM STA. 1+050 TO STA. 1+080
	SURVEY BY RDC DATE 12/93
	PROJ. RICHMOND CMG PARK(4)
	SHEET 19 OF 22 SHEETS