




1+120

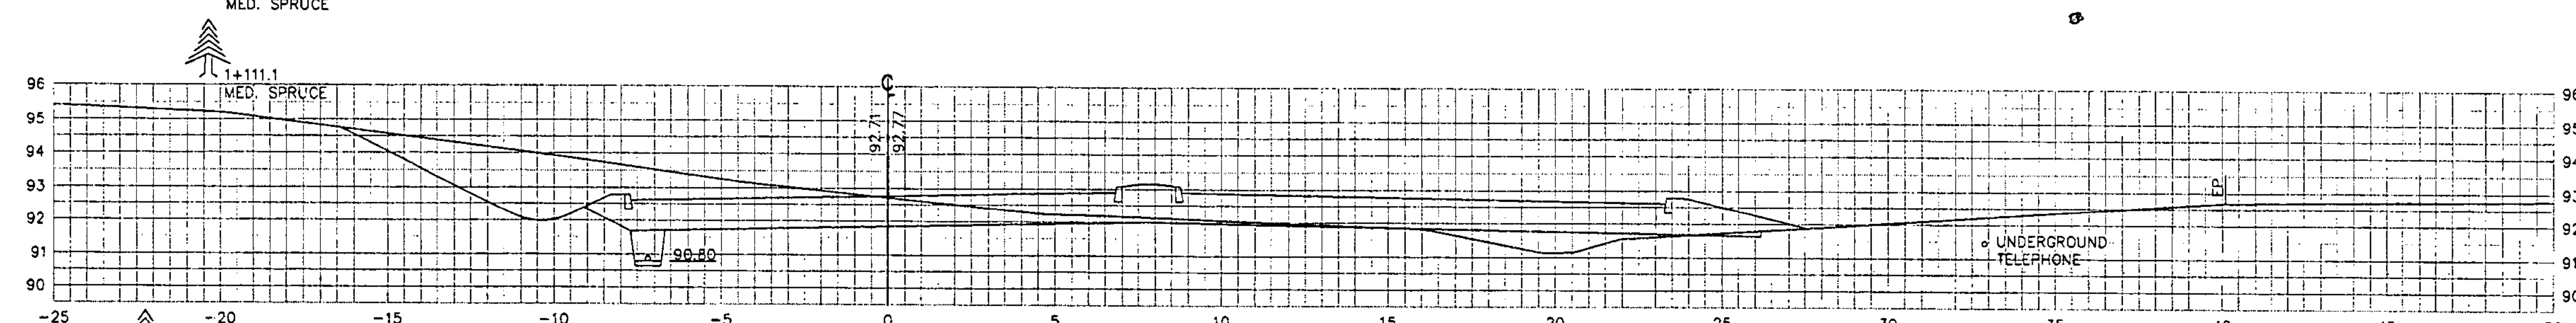

1+110

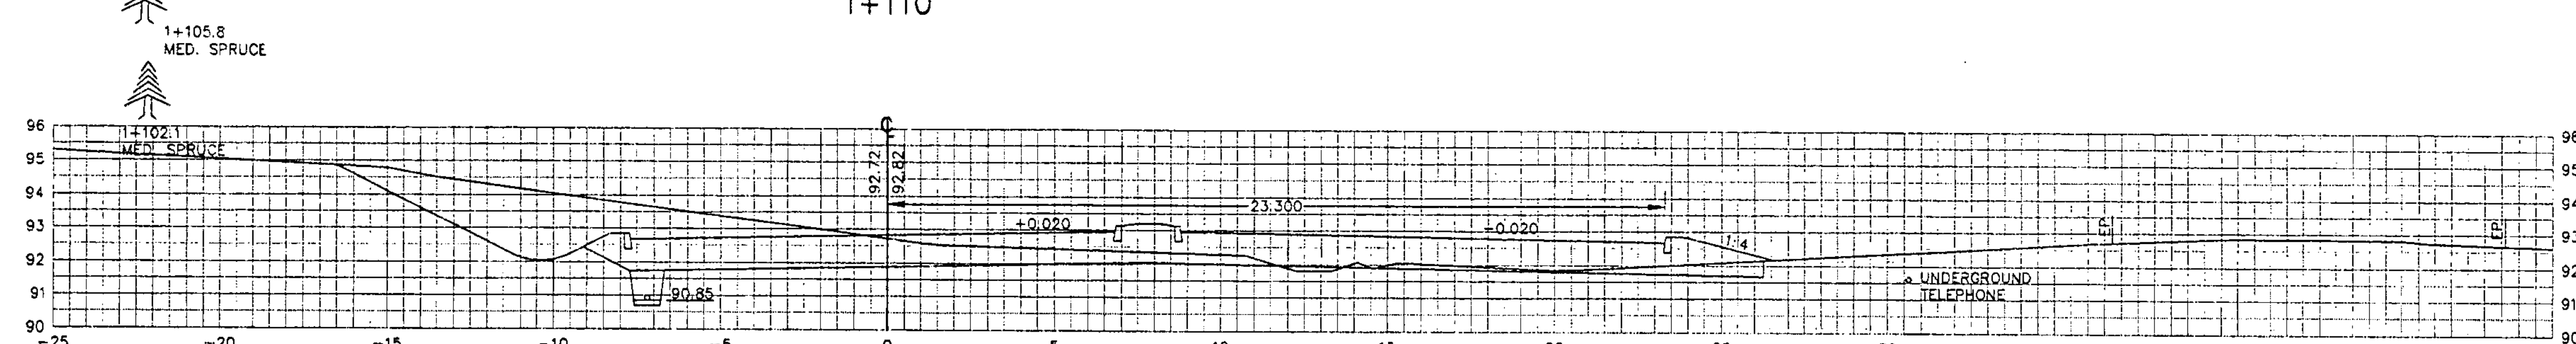

1+100

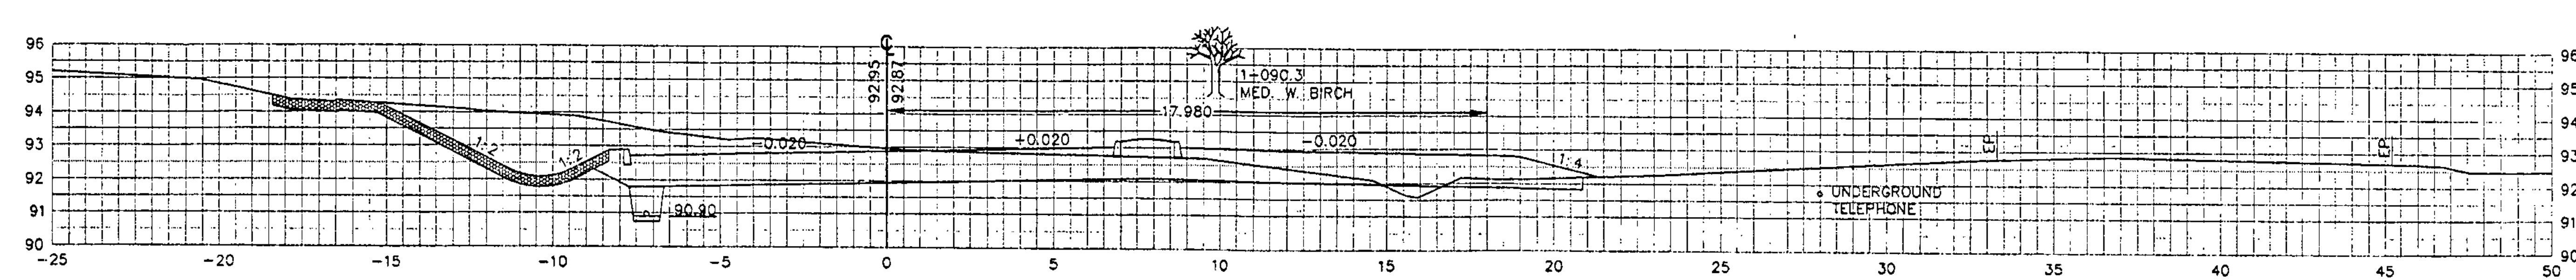

1+090

5 m

CROSS SECTIONS	FROM STA. 1+090 TO STA. 1+120
	SURVEY BY RDC DATE 12/93
	PROJ. RICHMOND CMG PARK(4)
	SHEET 20 OF 22 SHEETS