


REVISIONS AND CORRECTIONS
 JUNE 30, 1995 ORIGINAL APPROVAL

APPROVED
 [Signature]
 DIRECTOR OF ENGINEERING
 [Signature]
 DESIGN ENGINEER

MODIFIED ECCENTRIC LOADER TERMINAL WITH WOOD POSTS (MELT)

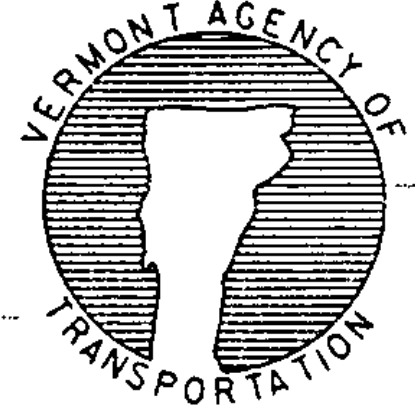

VERMONT AGENCY OF
TRANSPORTATION

STANDARD G-17 b