

REVISIONS AND CORRECTIONS
JUL. 5, 1972 - ORIGINAL APPROVAL
JUNE 1, 1994 - REISSUED, WITHOUT CHANGE,
UNDER NEW SIGNATURES.


APPROVED

APPROVED FOR THIS PROJECT
AND/OR DESIGN IMPLEMENTATION.
FHWA FINAL APPROVAL PENDING.

Stephen D. MacCallister
DIRECTOR OF ENGINEERING

Robert M. Murphy
DESIGN ENGINEER

TEMPORARY EROSION CONTROL DETAILS

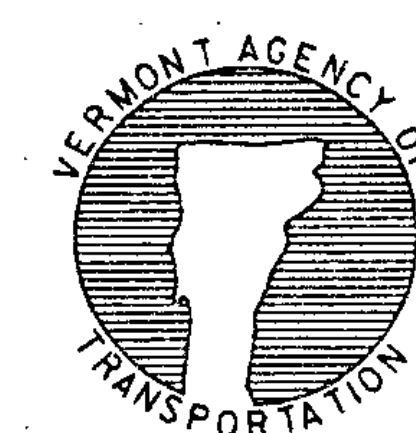

STANDARD T-2