


BEGIN PROJECT
MM 01.200

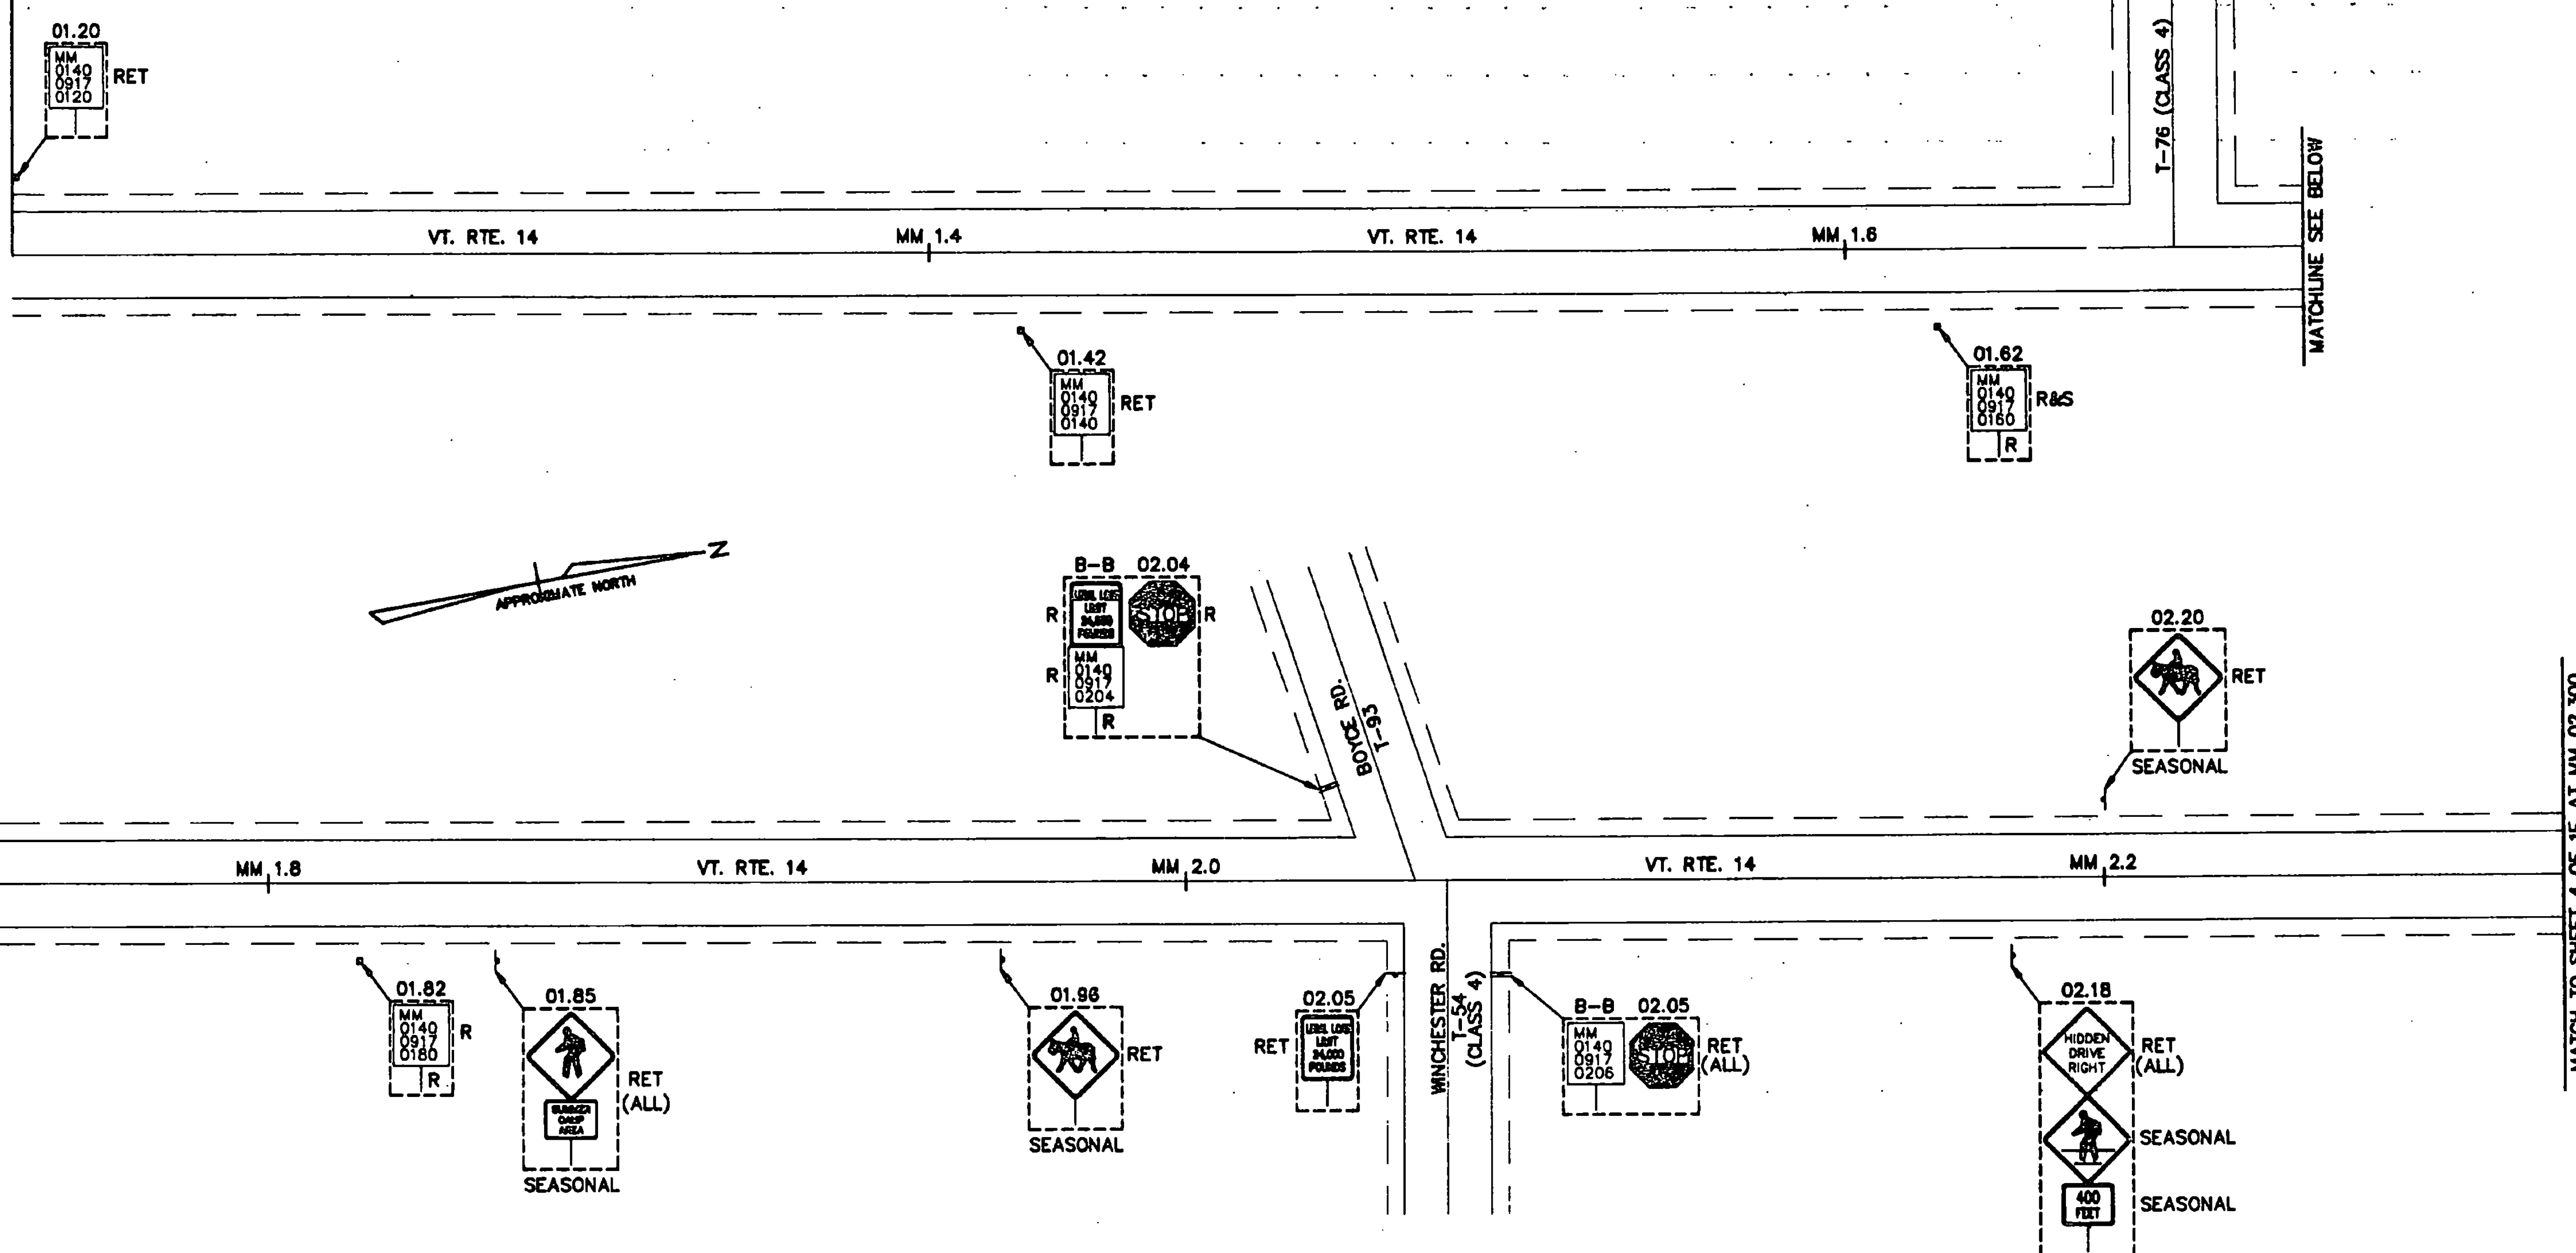

MATCHLINE SEE ABOVE

MATCH TO SHEET 4 OF 15 AT MM 02.300

NOTE:
MILE MARKER LOCATIONS ARE BASED ON
BRIDGE 53 @ MM 01.154.

- LEGEND**
- R REMOVE EXISTING
 - N NEW
 - RET RETAIN
 - R&S REMOVE AND SALVAGE
 - S SALVAGED
 - B-B BACK TO BACK

EXISTING SIGNS I		MM 01.200 TO MM 02.300 - (WILLIAMSTOWN)	
		SURVEYED BY SJB/JHF	DATE 9/83
		DRAWN BY JHF	DATE 11/83
		SQUAD LEADER SJB	
		DESIGN FILE NO.	
		DATE PLOTTED	
		PROJ. NAME WILLIAMSTOWN	
		PROJ. NO. STP SIGN 9454	
		SHEET 3 OF 15 SHEETS	

NOT TO SCALE

DATUM	
VERTICAL	N/A
HORIZONTAL	N/A

FILE ENG. & VTS. PARALLEL BY: DATE: 1989-07-11