
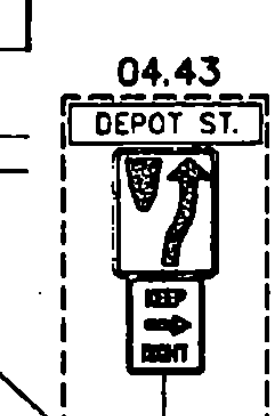
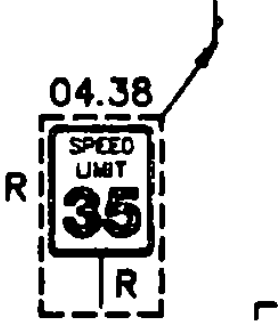
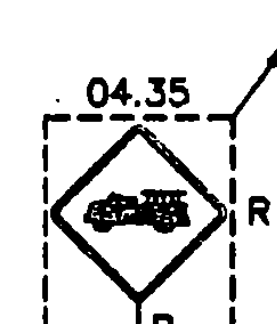
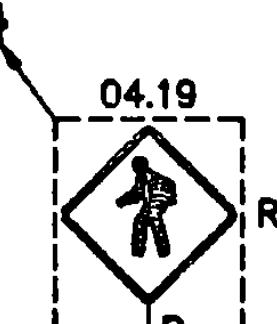
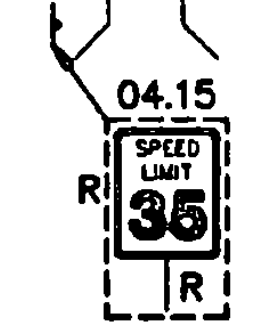


ISLAND CONSTRUCTION AND ASSOCIATED SIGNING AND STRIPING IS NOT IN THIS CONTRACT.

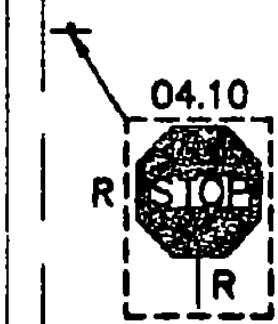

- LEGEND**
- R REMOVE EXISTING
 - N NEW
 - RET RETAIN
 - R&S REMOVE AND SALVAGE
 - S SALVAGED
 - B-B BACK TO BACK

EXISTING SIGNS III	MM 03.500 TO MM 04.450 - (WILLIAMSTOWN)	
	SURVEYED BY	SJB/JMF DATE 9/83
	DRAWN BY	JMF DATE 11/83
	SQUAD LEADER	SJB
DESIGN FILE NO.	DATE PLOTTED	
PROJ. NAME	WILLIAMSTOWN	
PROJ. NO.	STP SIGN 9454	
SHEET 5 OF 15 SHEETS		

DATUM	
VERTICAL	N/A
HORIZONTAL	N/A

NOT TO SCALE