

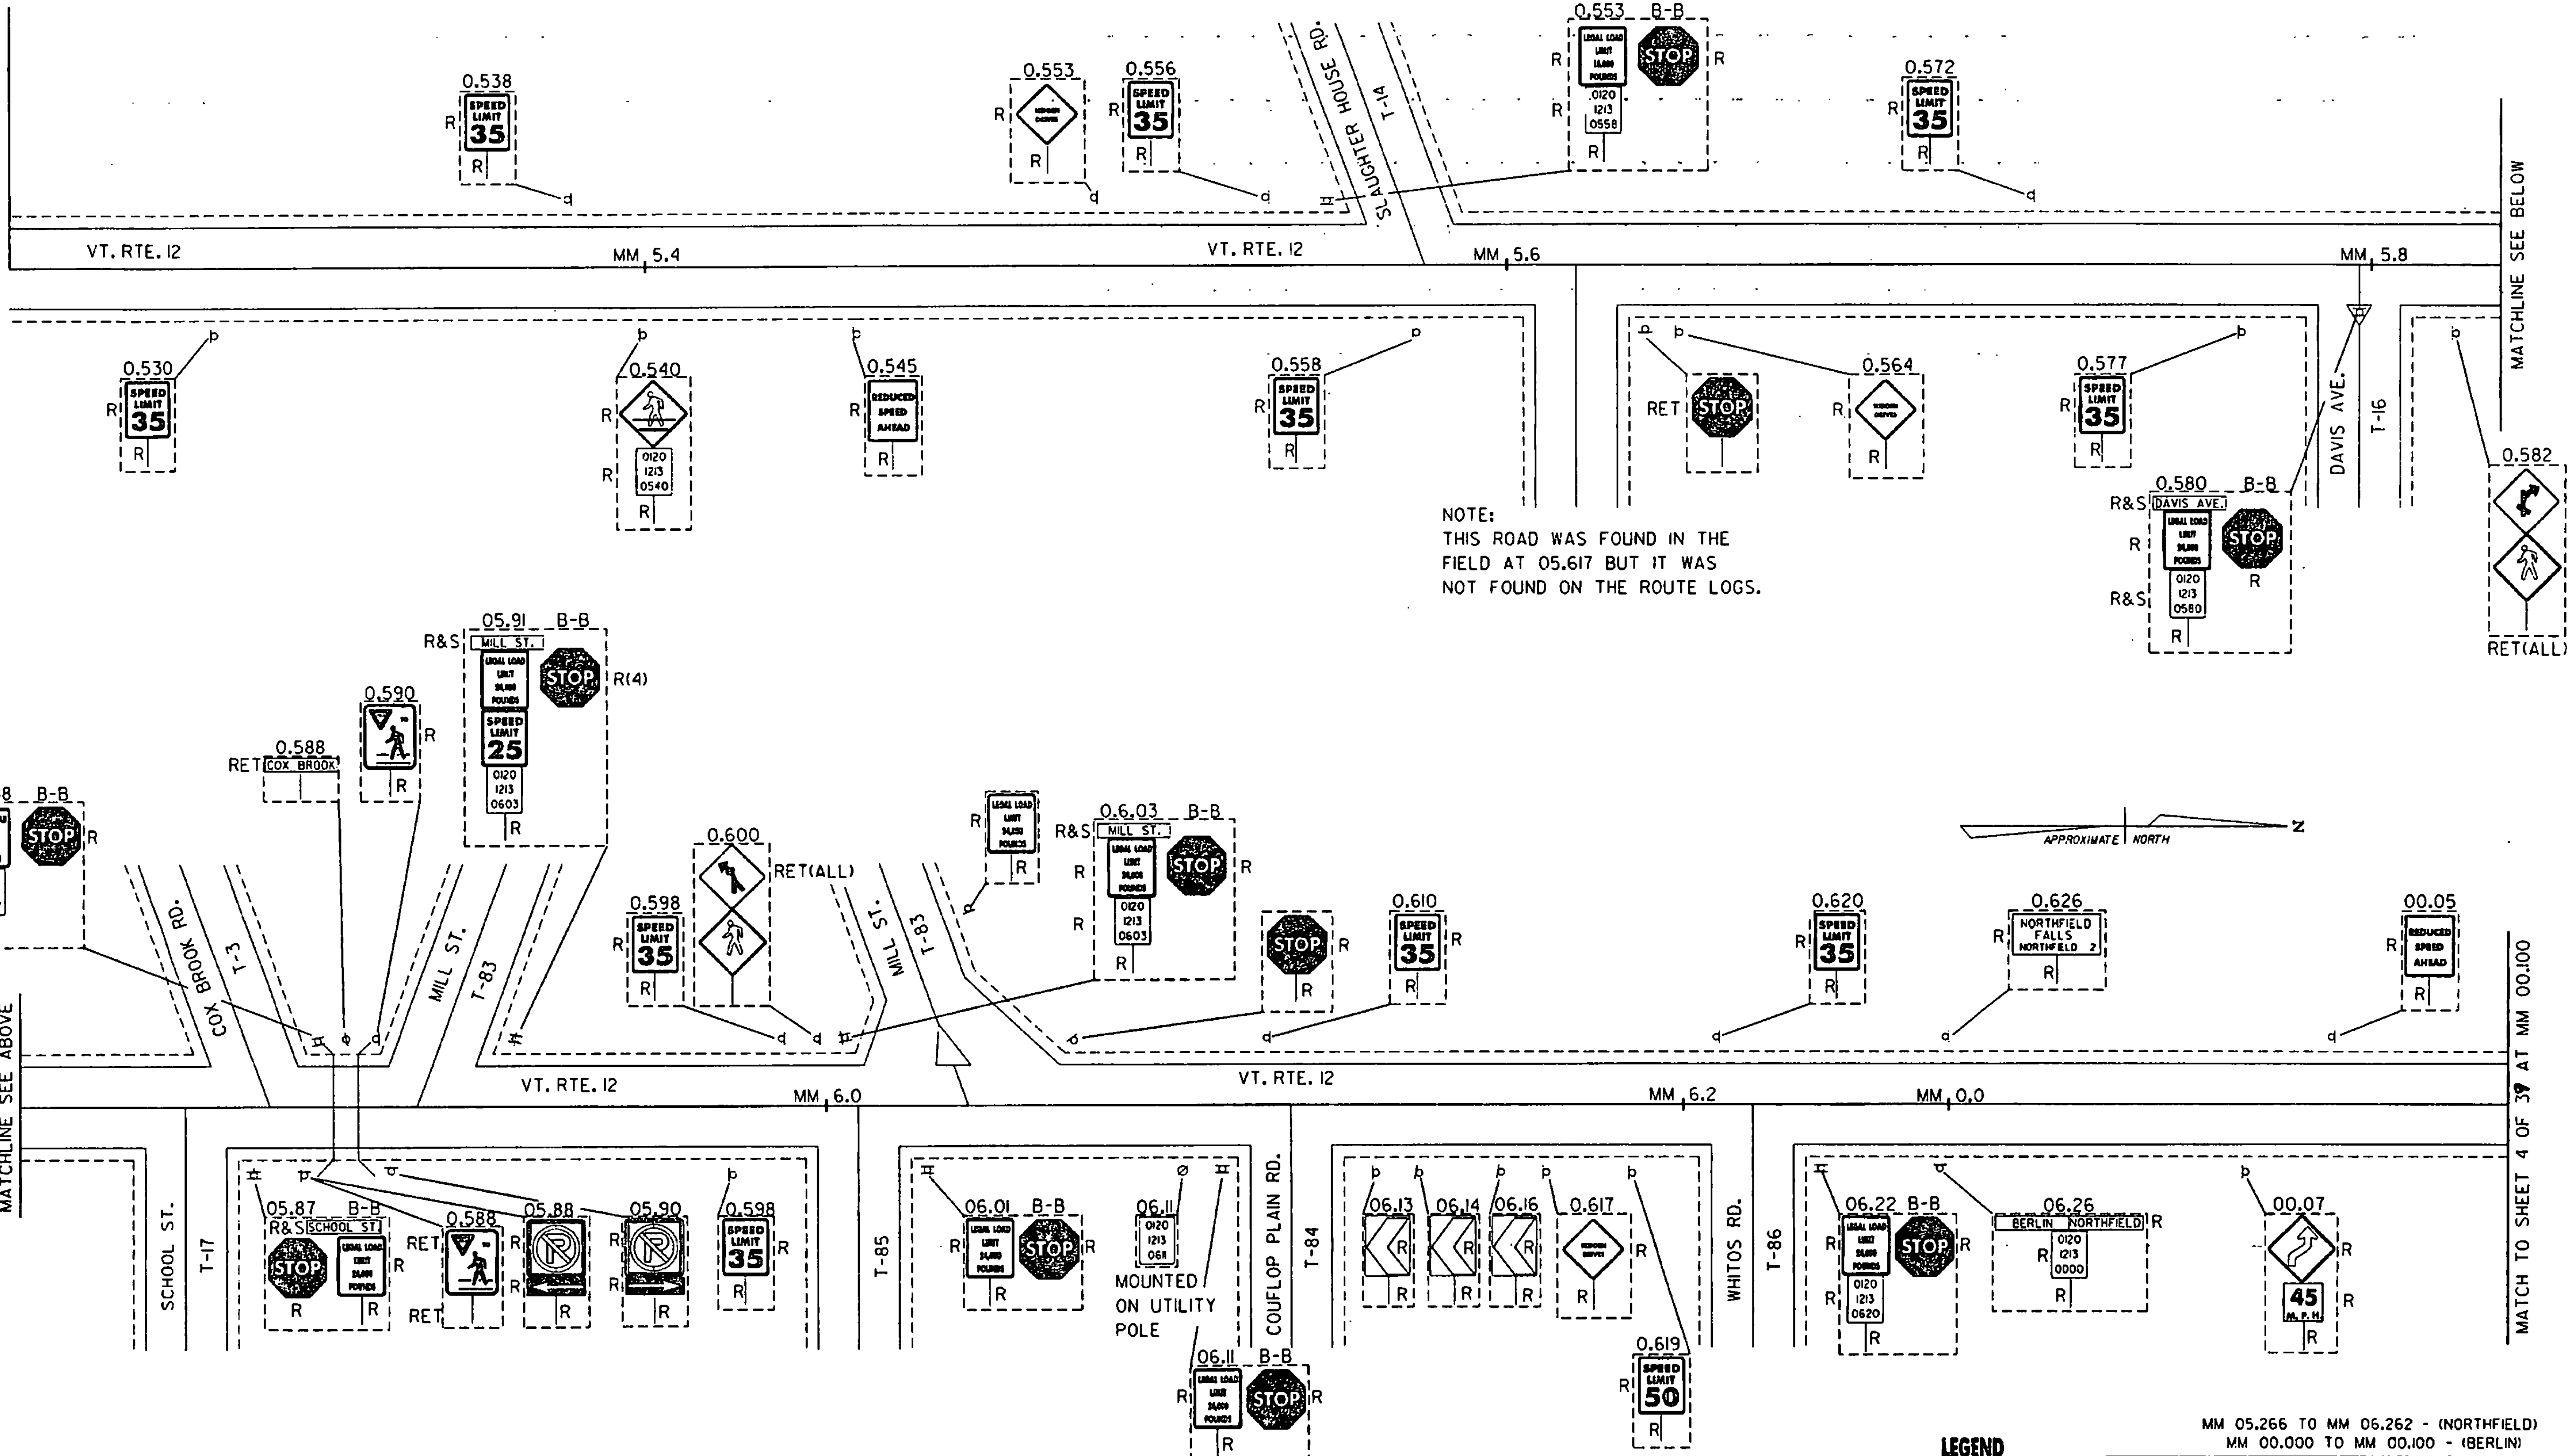


BEGIN PROJECT
MM 05.266 (NORTHFIELD)

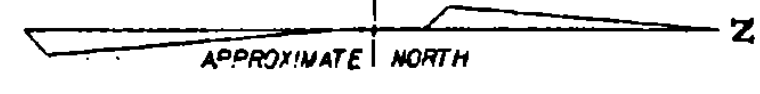

NOTE:
THIS ROAD WAS FOUND IN THE
FIELD AT 05.617 BUT IT WAS
NOT FOUND ON THE ROUTE LOGS.

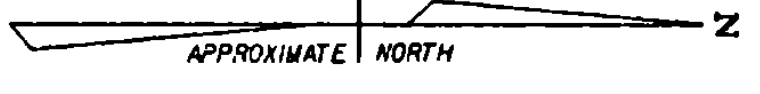

NOTE:
MILE MARKER LOCATIONS FOR NORTHFIELD
ARE BASED ON BRIDGE 61 @ MM 05.055

MILE MARKER LOCATIONS FOR BERLIN
ARE BASED ON BRIDGE 64 @ MM 0.799

LEGEND
 R REMOVE EXISTING
 N NEW
 RET RETAIN
 R&S REMOVE AND SALVAGE
 S SALVAGED
 B-B BACK TO BACK
 NOT TO SCALE

**EXISTING
SIGN**

MM 05.266 TO MM 06.262 - (NORTHFIELD)
MM 00.000 TO MM 00.100 - (BERLIN)

SURVEYED BY	DATE
DRAWN BY	DATE 10/95
SQUAD LEADER	DATE
DESIGN FILE NO. 180F/JHK/NORTFLD.DGN	
IPARM	
FILE NORTH02.1	
PROJ. NAME NORTHFIELD-BERLIN	
PROJ. NO. STP SIGN 9467	
SHEET 3 OF 39 SHEETS	