
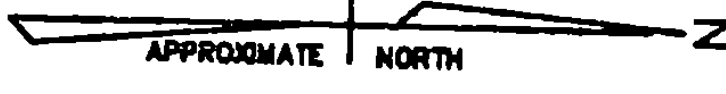


MATCH TO SHEET 4 OF 39 AT MM 01.300

MATCHLINE SEE ABOVE

MATCH TO SHEET 6 OF 39 AT MM 02.390

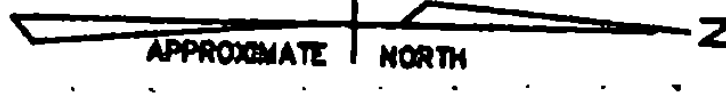

- LEGEND**
- R REMOVE EXISTING
  - N NEW
  - RET RETAIN
  - R&S REMOVE AND SALVAGE
  - S SALVAGED
  - B-B BACK TO BACK

<p><b>EXISTING SIGNS III</b></p>		MM 01.300 TO MM 02.390 - (BERLIN)			
		SURVEYED BY	SJB/JHF	DATE	9/83
		DRAWN BY	SAM	DATE	9/83
		SQUAD LEADER	SJB		
		DESIGN FILE NO.			
		IPARM FILE	DATE PLOTTED		
		PROJ. NAME	NORTHFIELD-BERLIN		
		PROJ. NO.	STP SIGN 9467		
		SHEET	8 OF 39 SHEETS		

DATUM	
VERTICAL	N/A
HORIZONTAL	N/A

NOT TO SCALE

ALL SIGNS SHOWN UNLESS OTHERWISE NOTED BY DATE 9/83