

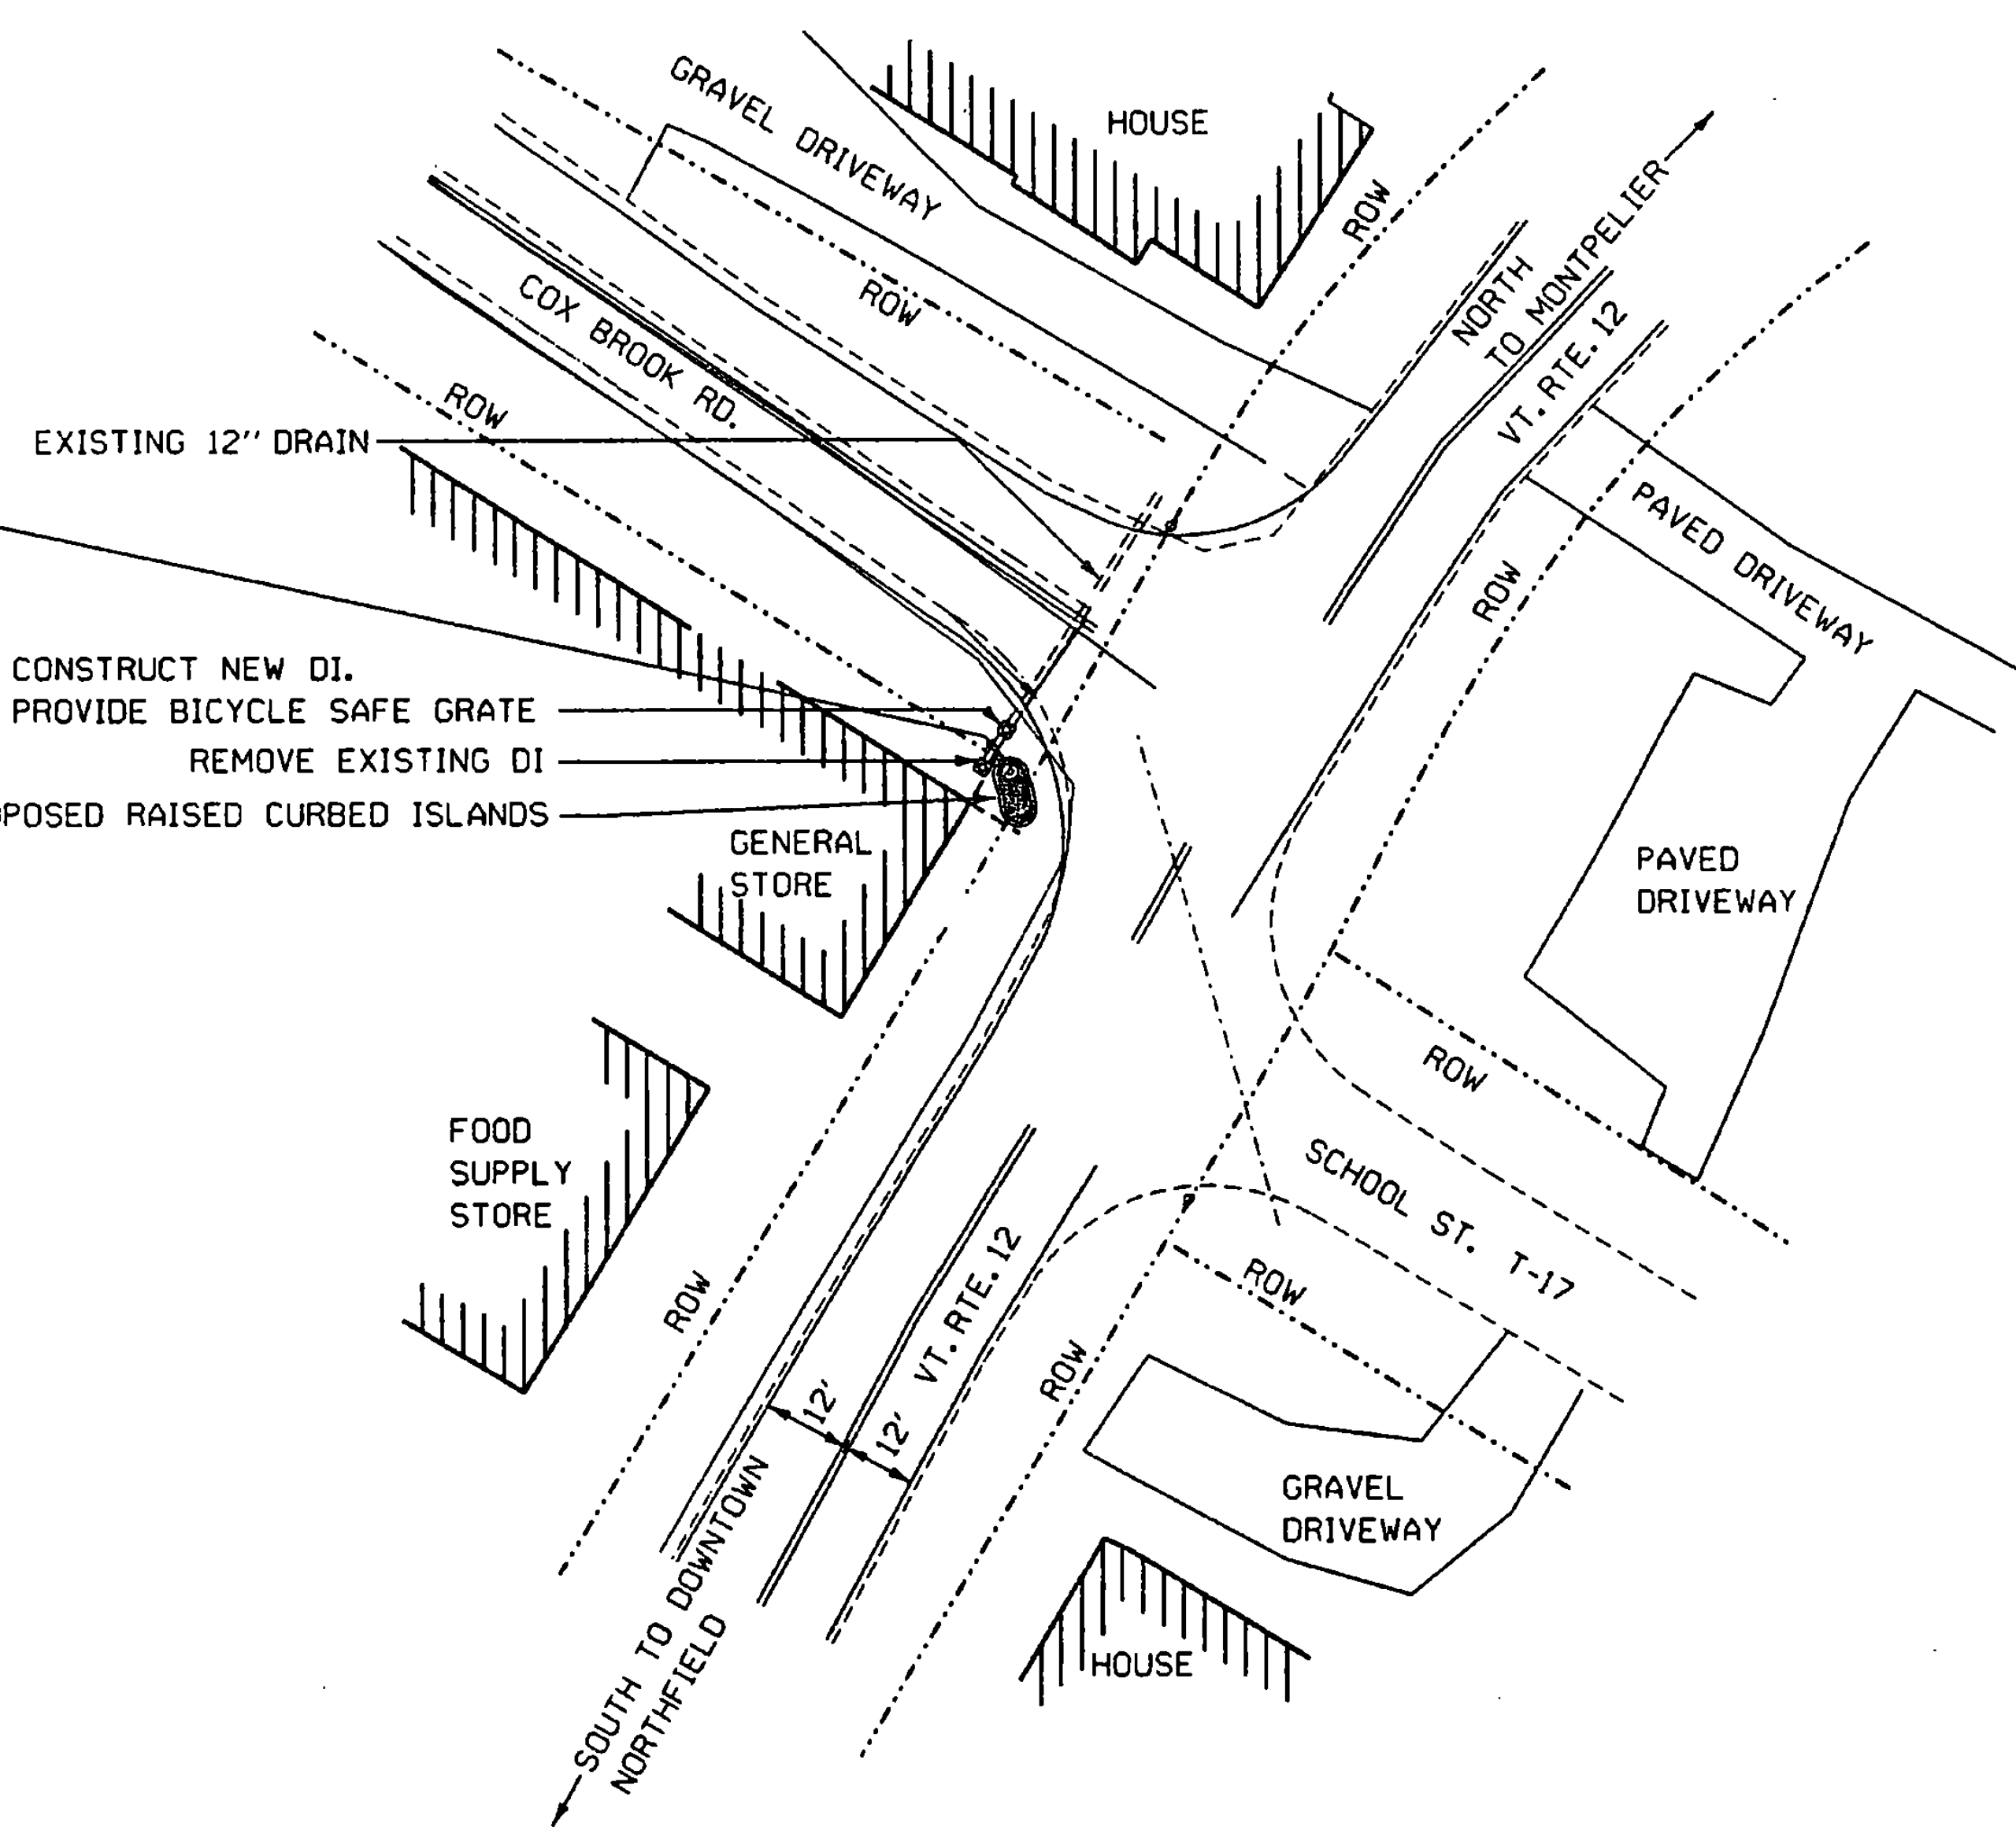


CONSTRUCT NEW DI.
 PROVIDE BICYCLE SAFE GRATE
 REMOVE EXISTING DI
 PROPOSED RAISED CURBED ISLANDS

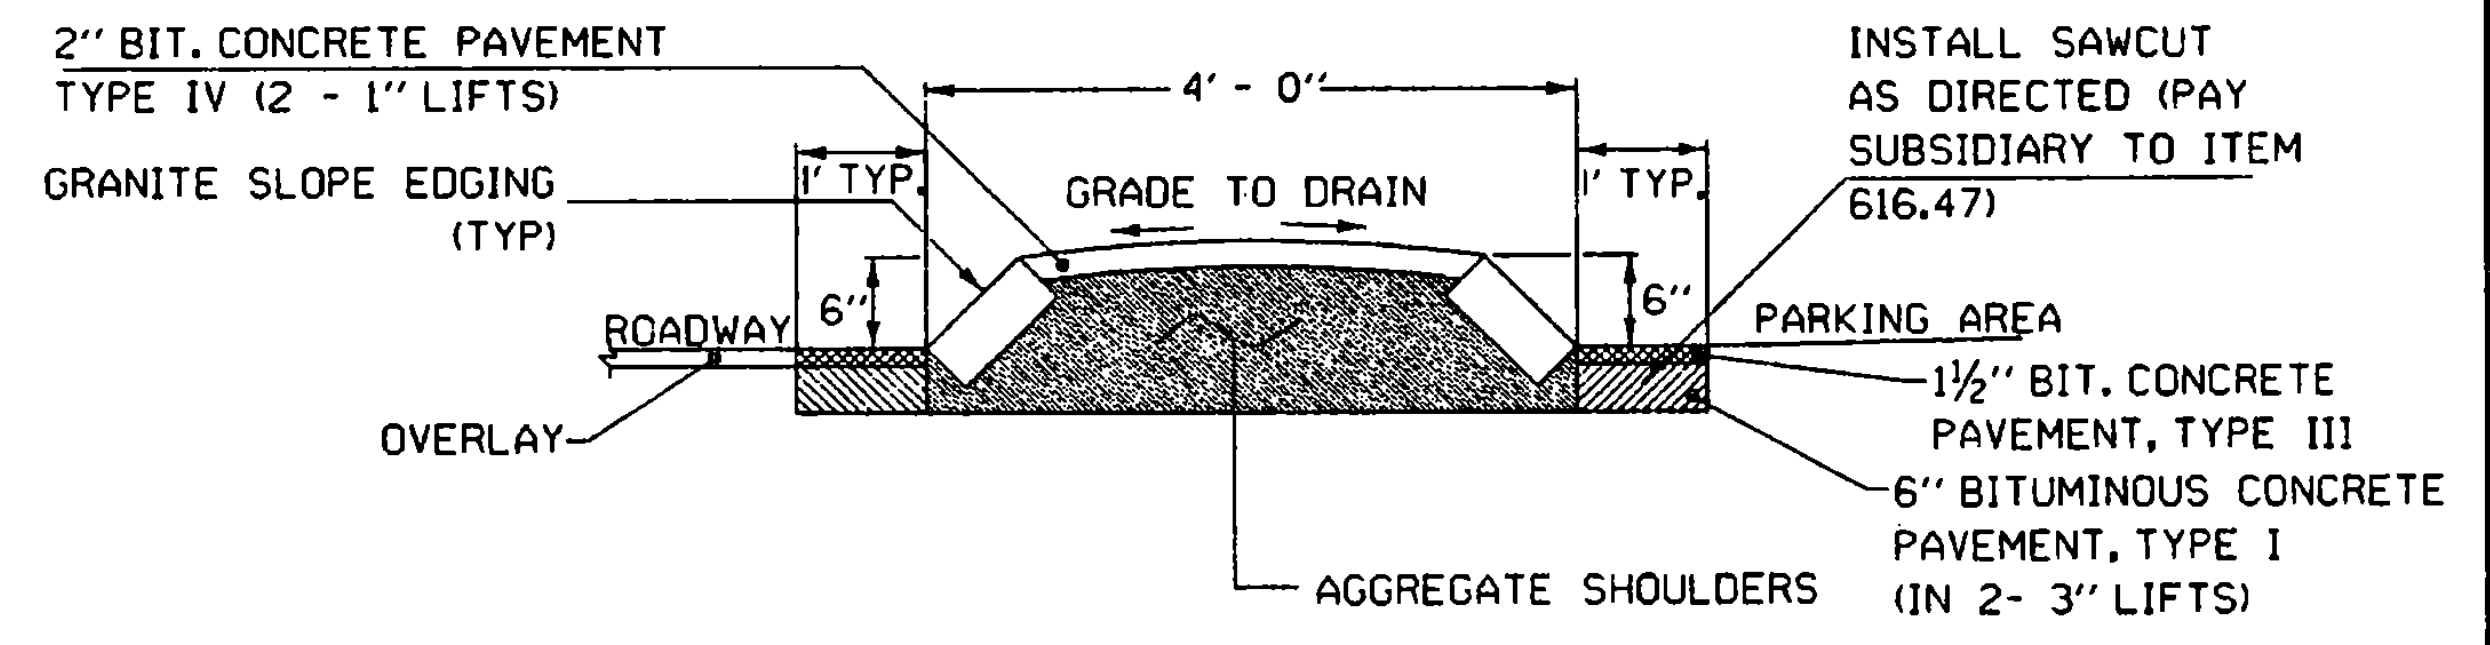

INTERSECTION PLAN
 SCALE: 1"=20'

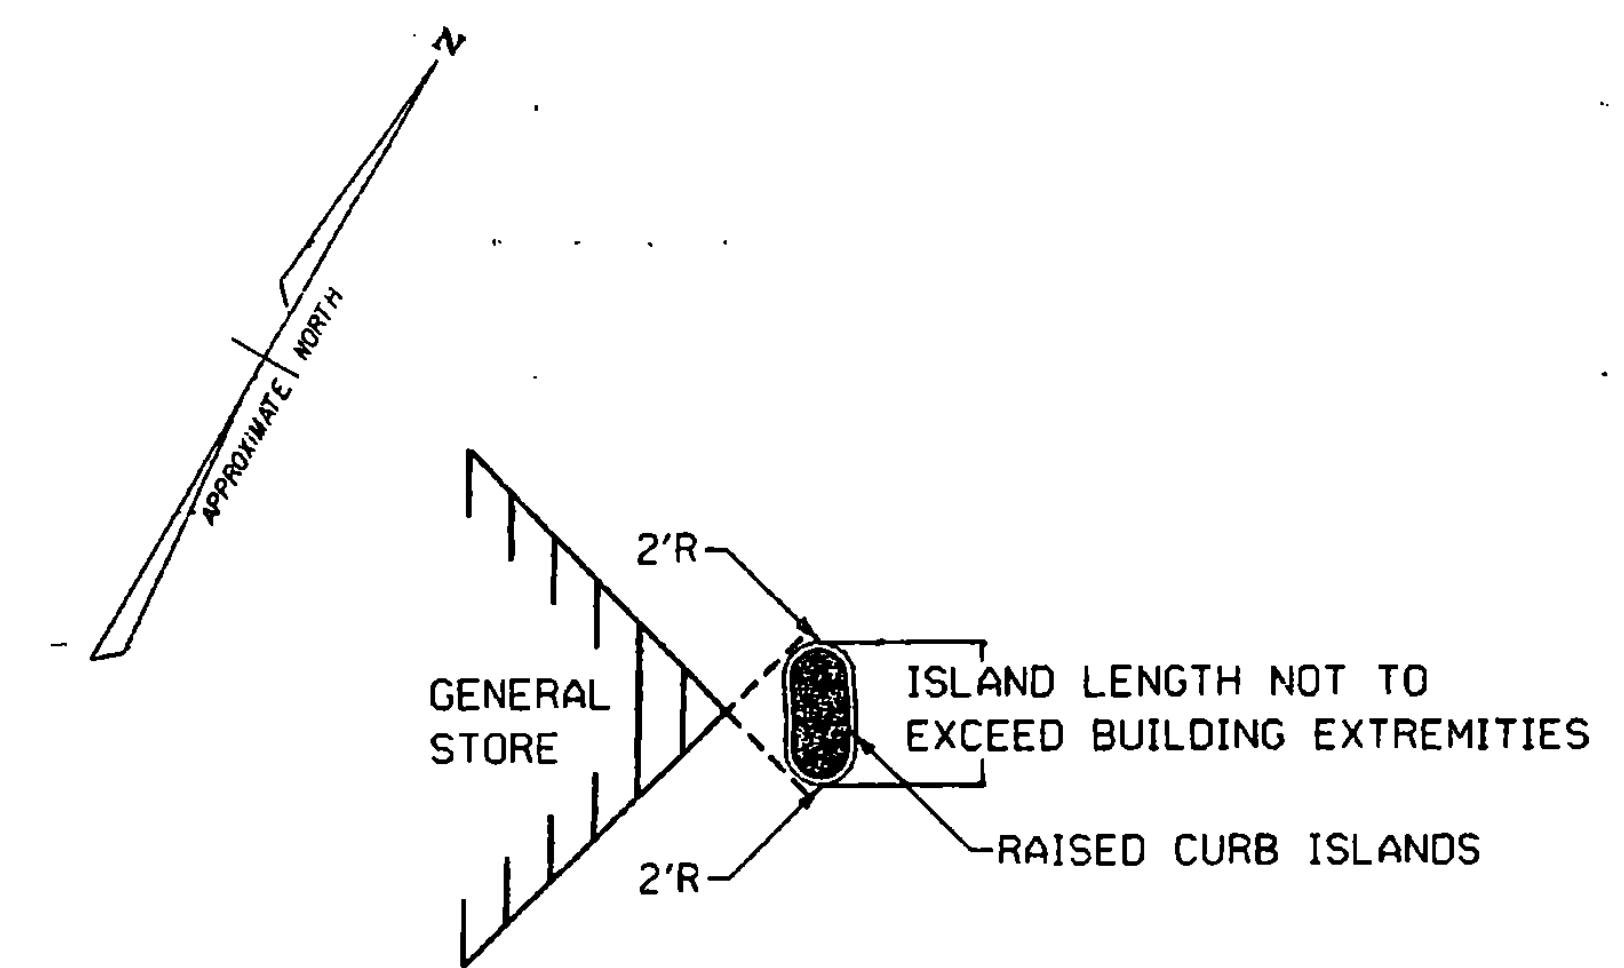

NOTE: ALL EXCAVATION WILL BE
 AS DIRECTED BY THE RESIDENT
 ENGINEER.

SECTION A -A
CURBED ISLAND DETAIL
 N.T.S.

INTERSECTION DETAILS	SURVEYED BY _____	DATE _____
	DRAWN BY JHK	DATE 3/96
	SQUAD LEADER _____	DATE _____
	DESIGN FILE NO. /pave/94k012/pk012.dgn	
	PARM FILE pk012.dwg	
	PROJ. NAME NORTHFIELD-BERLIN	
PROJ. NO. STP SIGN 9467		
SHEET 34 OF 39 SHEETS		