
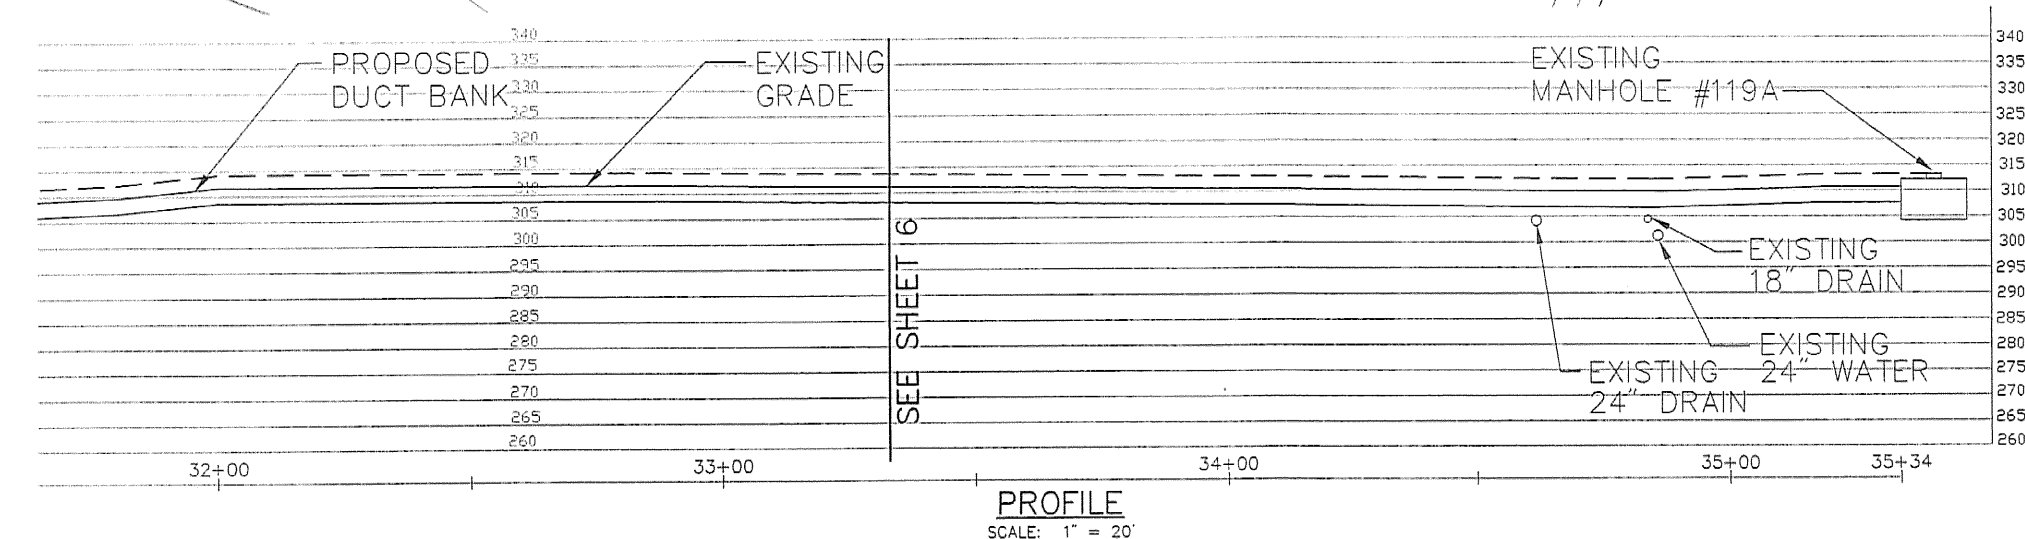


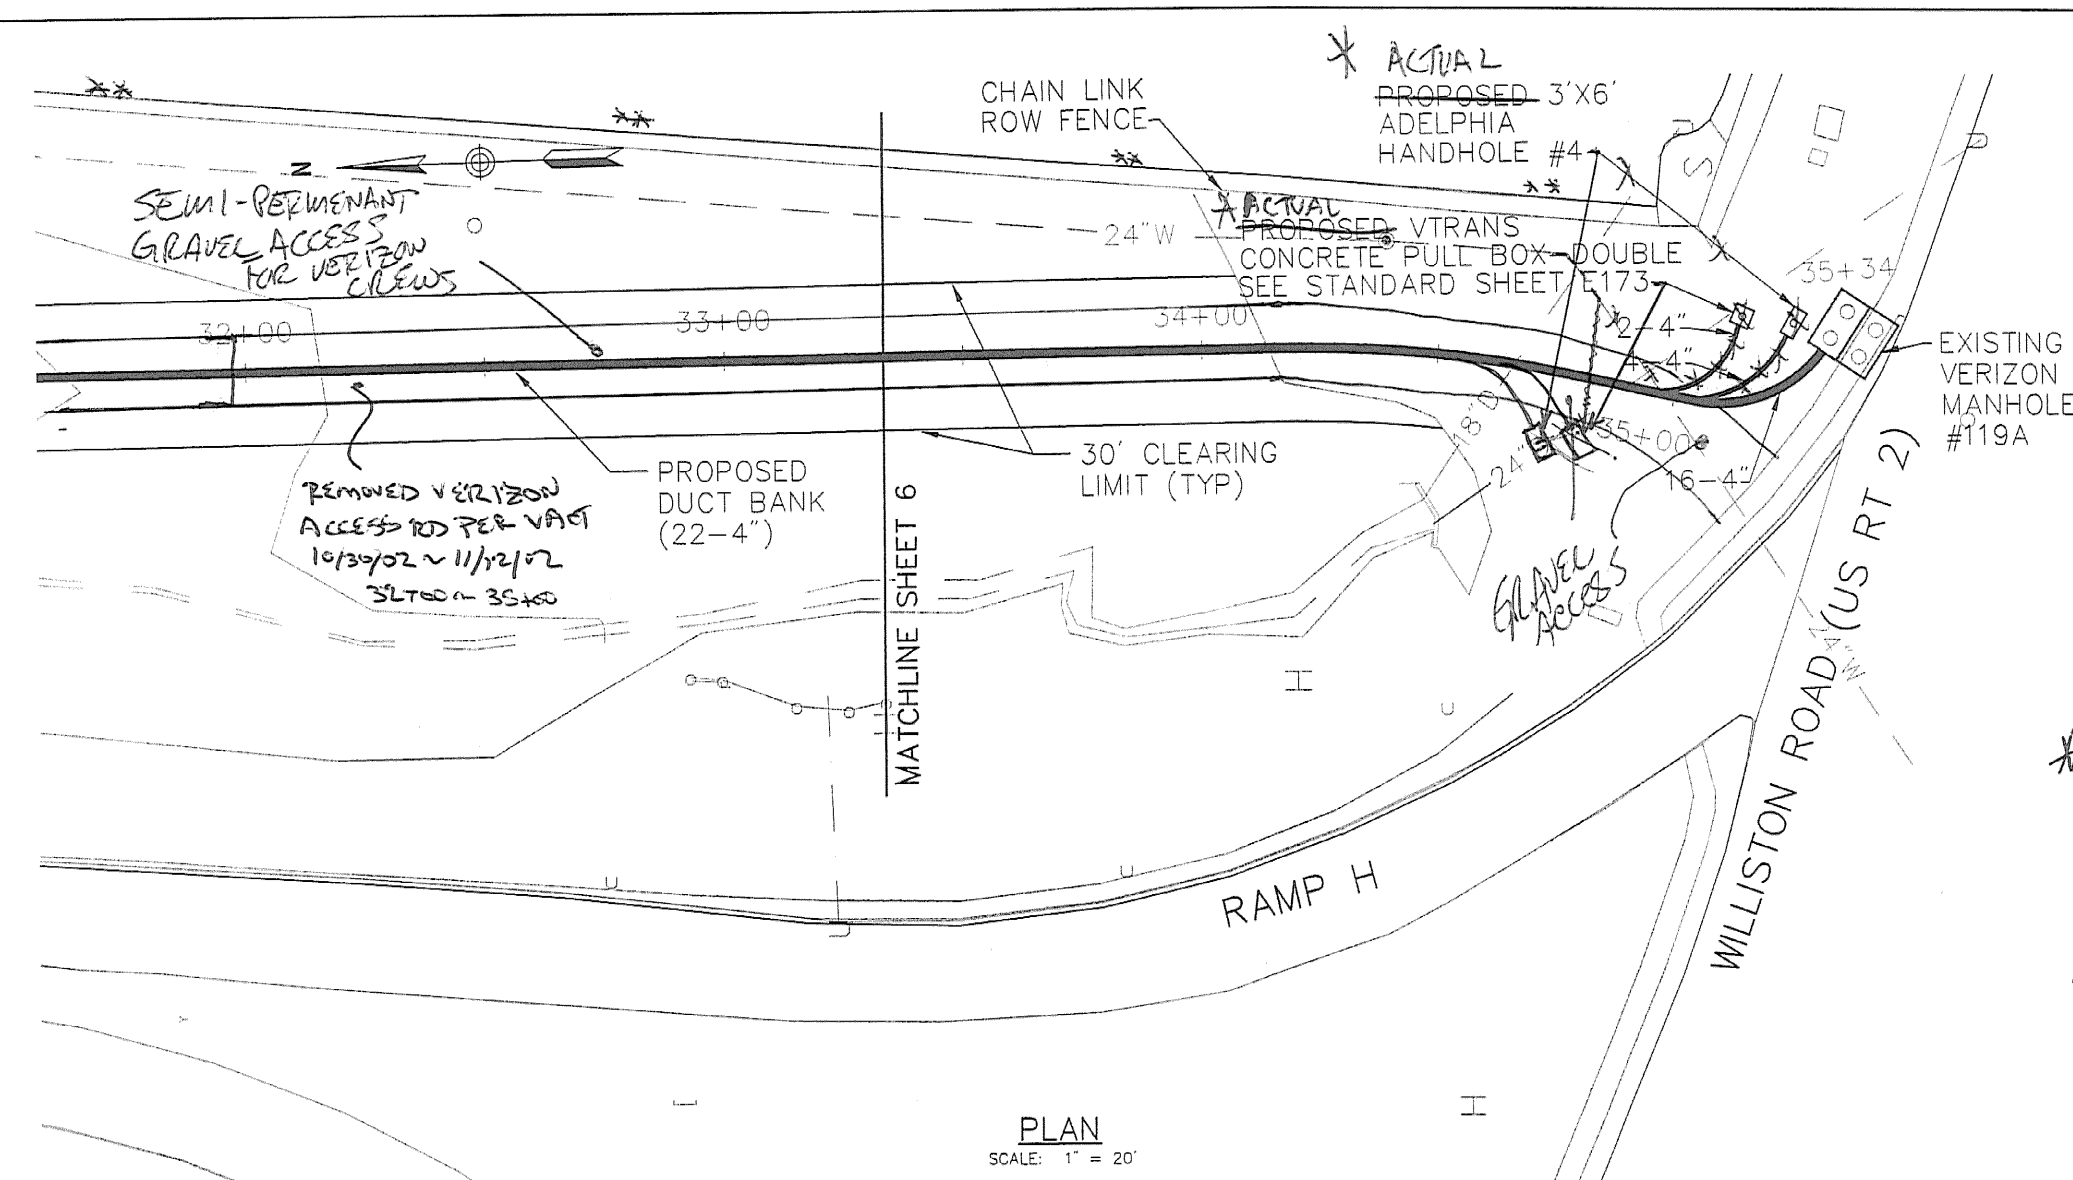

\* FIELD CONDITIONS GAVE RISE TO THE  
NEED TO RELOCATE THE CATV &  
VADT HANDHOLDS TO CLEAR  
EXISTING 8 CWD H<sub>2</sub>O LINE & OLD  
ABANDONED SHEET PILING. PLUS, A  
MASS OF EXISTING UNDERGROUND  
ELECTRIC CONDUITS WERE PRESENT.

\*\* Holiday Inn Maintenance Cleared brush along  
Row Fence 10/02. Saw Left Remainder  
of Maple logs from clearing operations for  
Holiday Inn @ their Request (11/12/02)

|                                              |                          |
|----------------------------------------------|--------------------------|
| STATE OF VERMONT<br>AGENCY OF TRANSPORTATION |                          |
| Town Of SOUTH BURLINGTON                     | Bridge No. 68            |
| Highway No. U.S. 2                           | Loc. Sta.                |
| U.S. 2 OVER I-89                             |                          |
| TELECOMMUNICATIONS RELOCATION                |                          |
| Designed By M. HAYES                         | Drawn By M. HAYES        |
| Checked By                                   | Bridge Design Supervisor |
|                                              | S. JOHNSON               |
| PROJECT                                      | PROJECT NO.              |
| SOUTH BURLINGTON                             | IN DECK(35)              |
| MBL (and Drawing No. VTRANS-GEN              | Date 02/01/01            |
| Bridge Sheet No. T-9 OF 9                    | Sheet 52 of 15           |

VANASSE HANGEN BRUSTLIN, INC.

