



**PLAN**  
SCALE: 1" = 20'

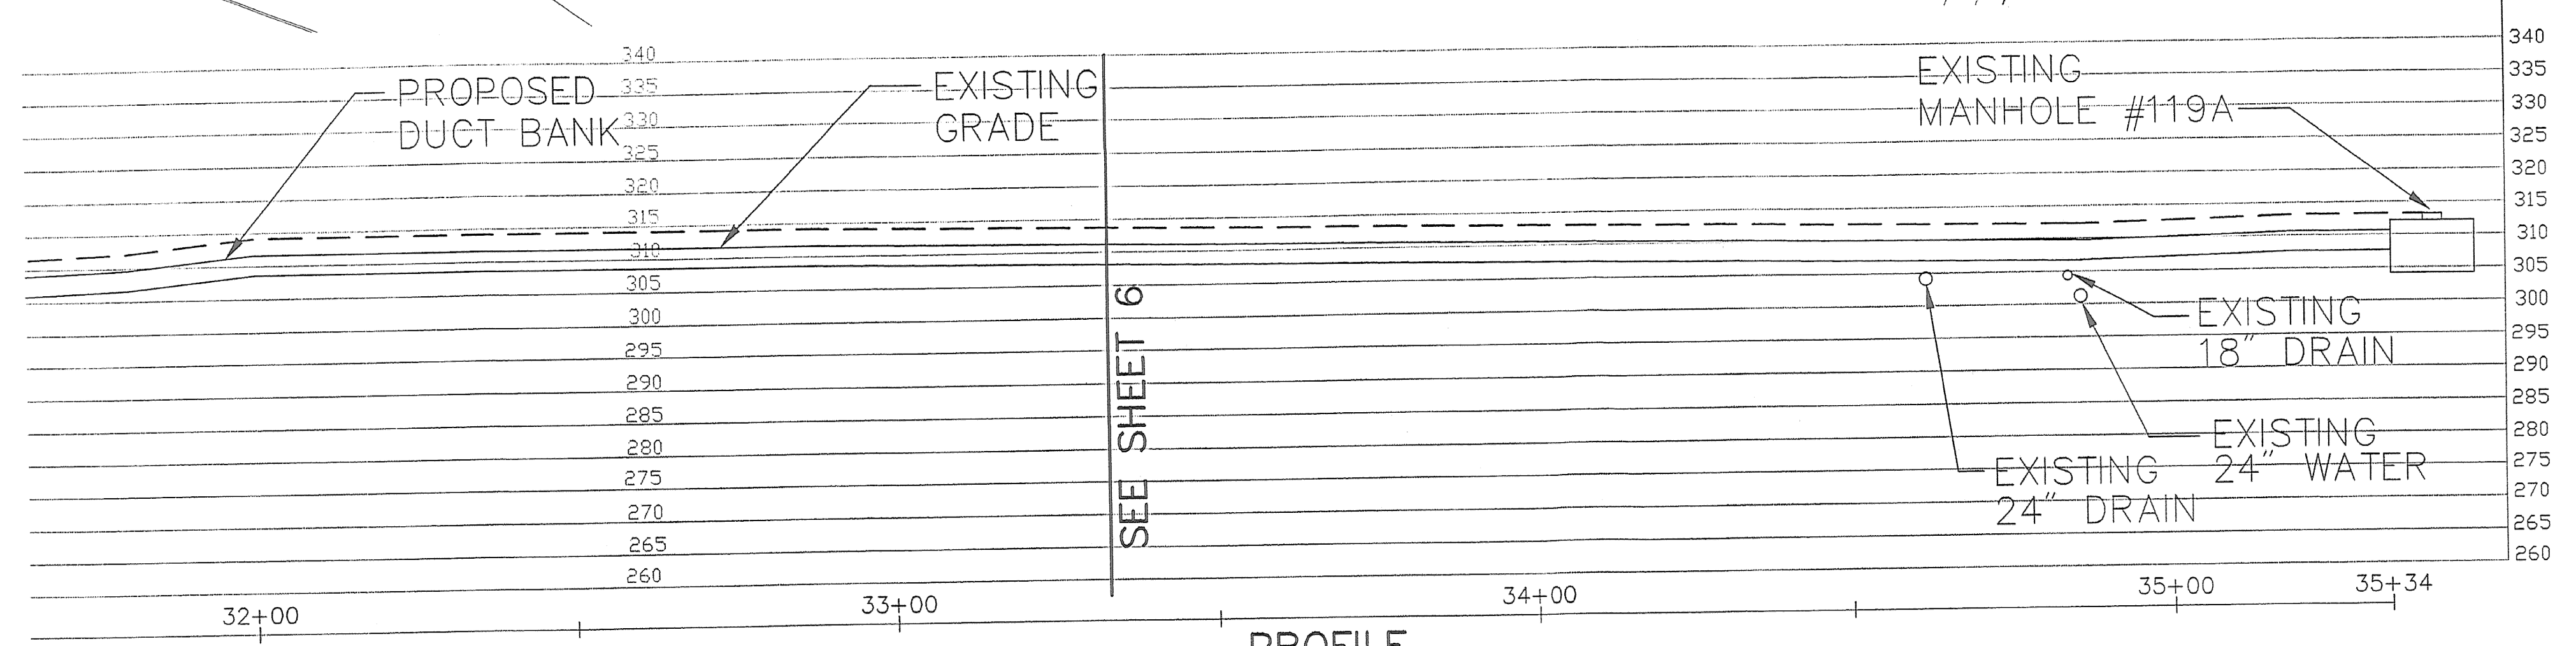

**PROFILE**  
SCALE: 1" = 20'

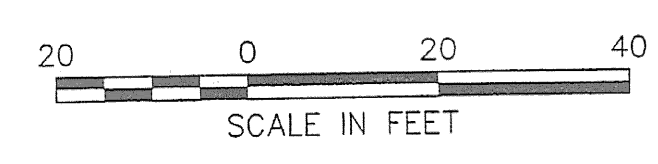

<b>STATE OF VERMONT AGENCY OF TRANSPORTATION</b>			
Town Of	SOUTH BURLINGTON	Bridge No.	68
Highway No. U.S.	2	Log Sta.	
		Surv. Sta.	
U.S. 2 OVER I-89			
<b>TELECOMMUNICATIONS RELOCATION</b>			
Designed By	M. HAYES	Drawn By	M. HAYES
Checked By	Date	Bridge Design Supervisor	S. JOHNSON Date
PROJECT	SOUTH BURLINGTON	PROJECT NO.	IM DECK(36)
VHB Cad Drawing No.	VTRANS-GEN	Date	10/31/01
Bridge Sheet No.	TP 8 OF 8	Sheet	33 of 75

VANASSE HANGEN BRUSTLIN, INC.