




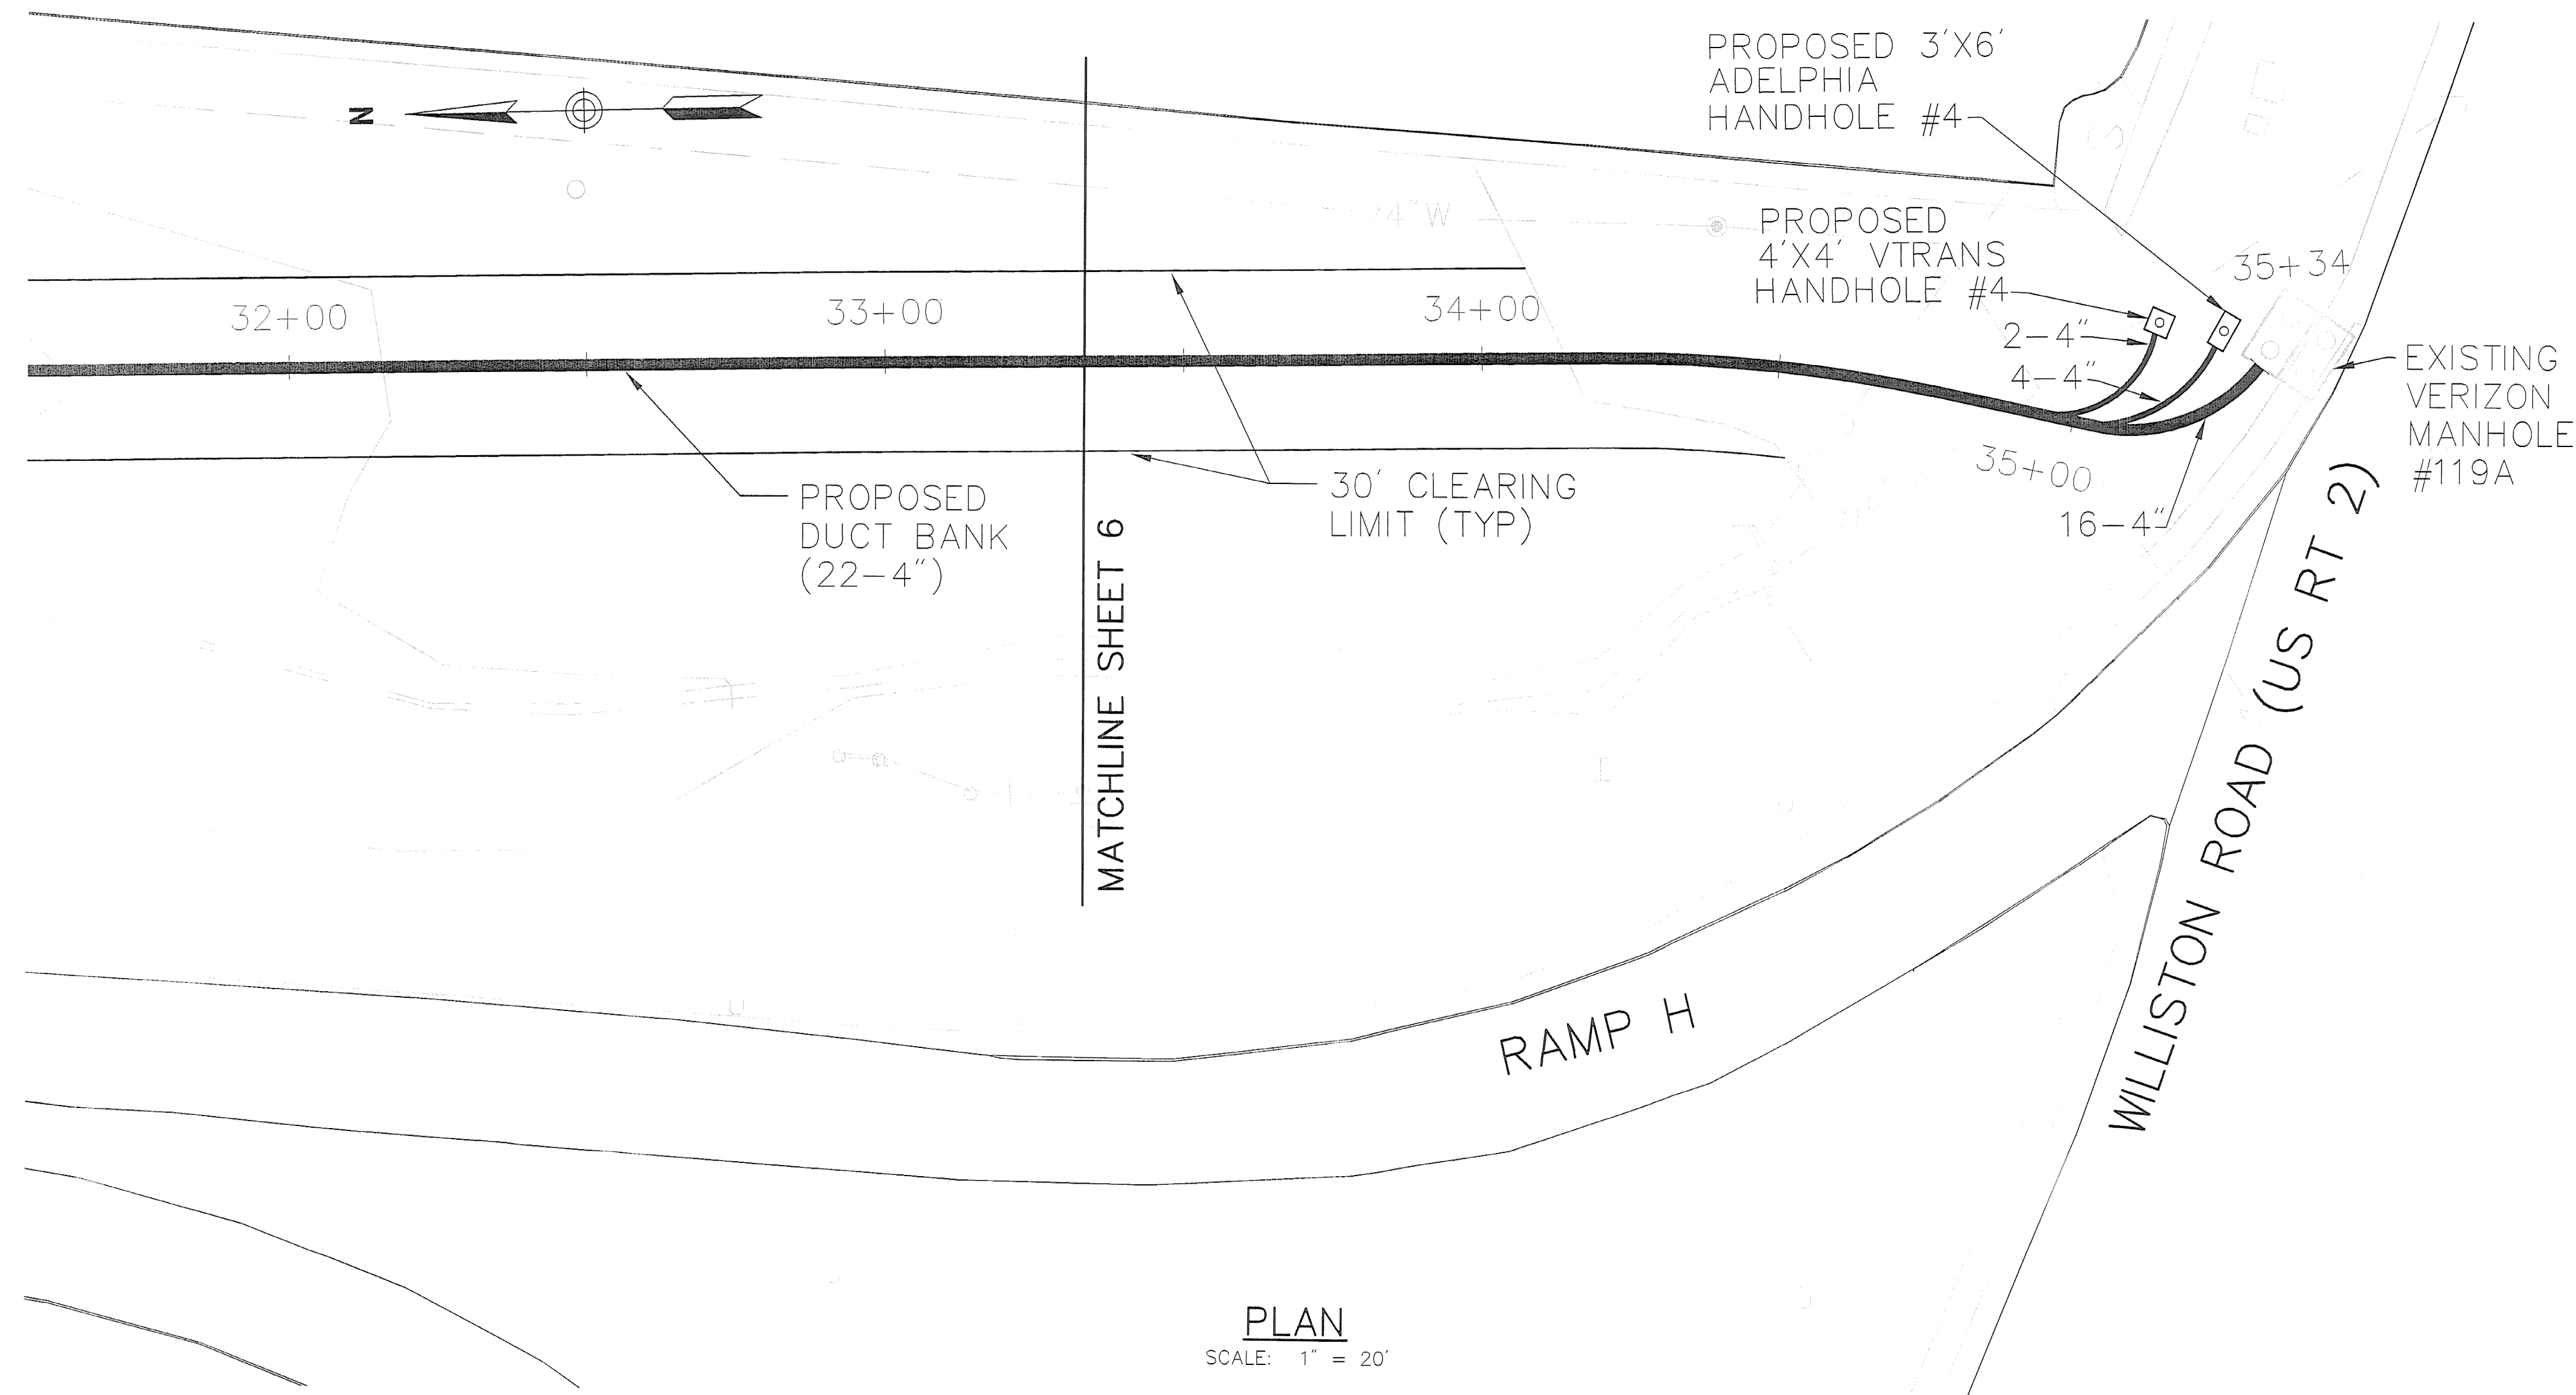

PLAN
SCALE: 1" = 20'

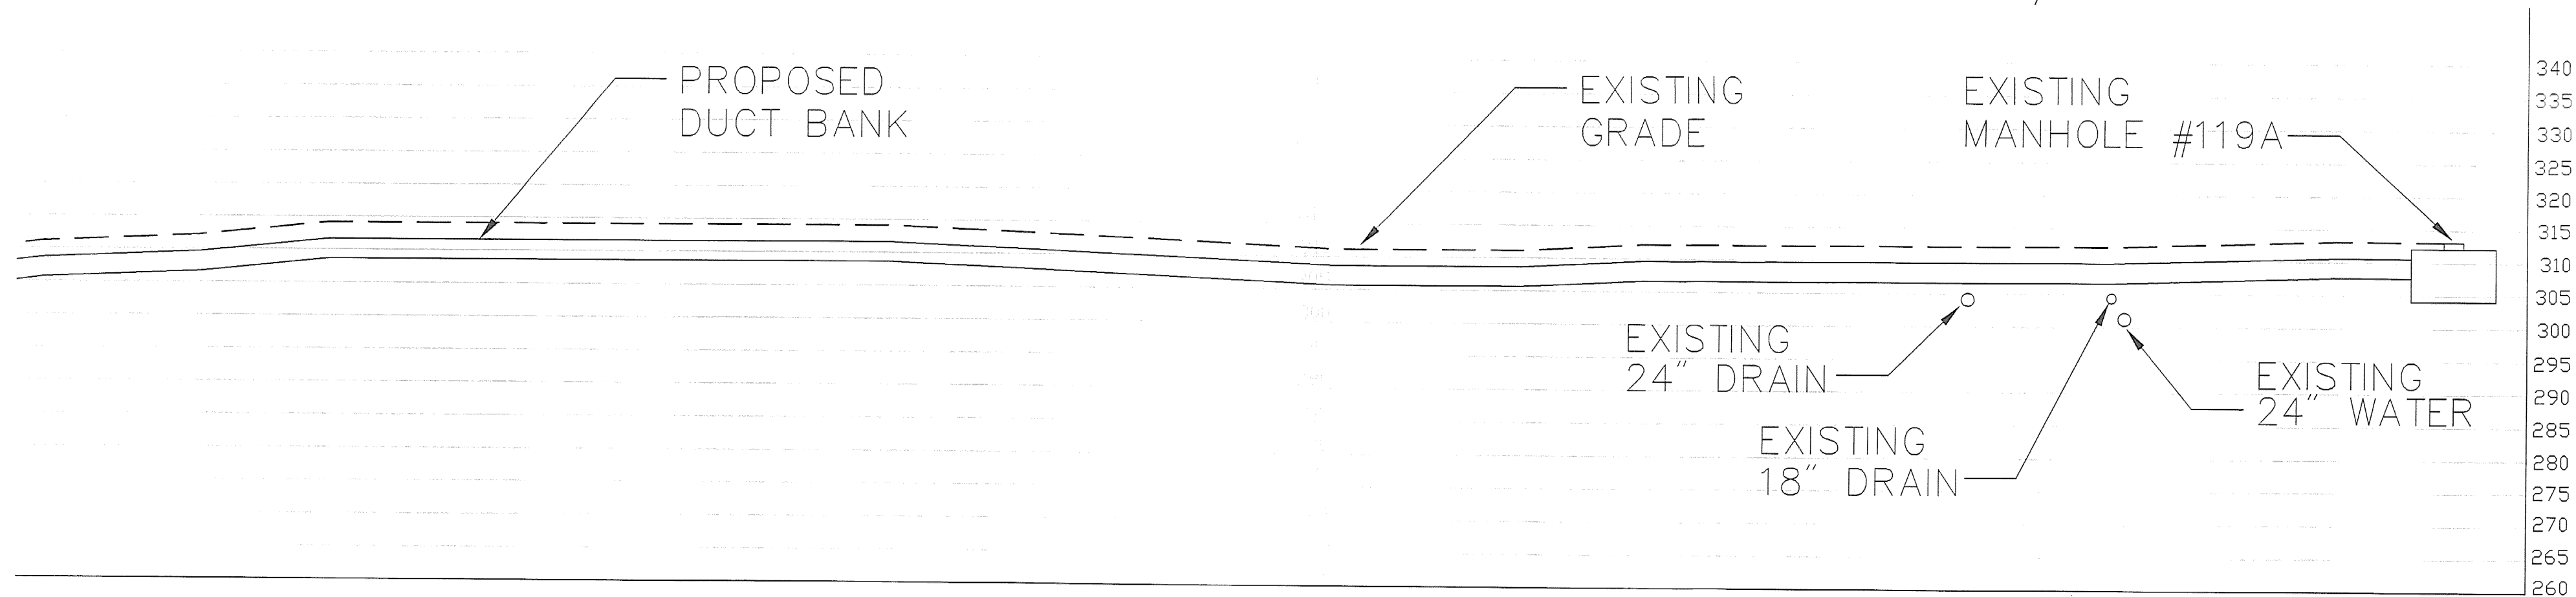

PROFILE
SCALE: 1" = 20'

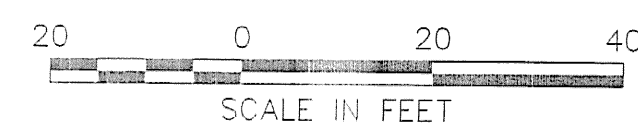

VANASSE HANGEN BRUSTLIN, INC.

STATE OF VERMONT AGENCY OF TRANSPORTATION			
Town Of	SOUTH BURLINGTON	Bridge No.	68
Highway No.	U.S. 2	Log Sta.	
		Surv. Sta.	
U.S. 2 OVER I-89			
TELECOMMUNICATIONS RELOCATION			
Designed By	M. HAYES	Drawn By	M. HAYES
Checked By		Bridge Design Supervisor	S. JOHNSON
		Date	
PROJECT	SOUTH BURLINGTON	PROJECT NO.	IM DECK(36)
VHB Cad Drawing No.	VTRANS-GEN	Date	9/24/01
Bridge Sheet No.		Sheet	7 of 7